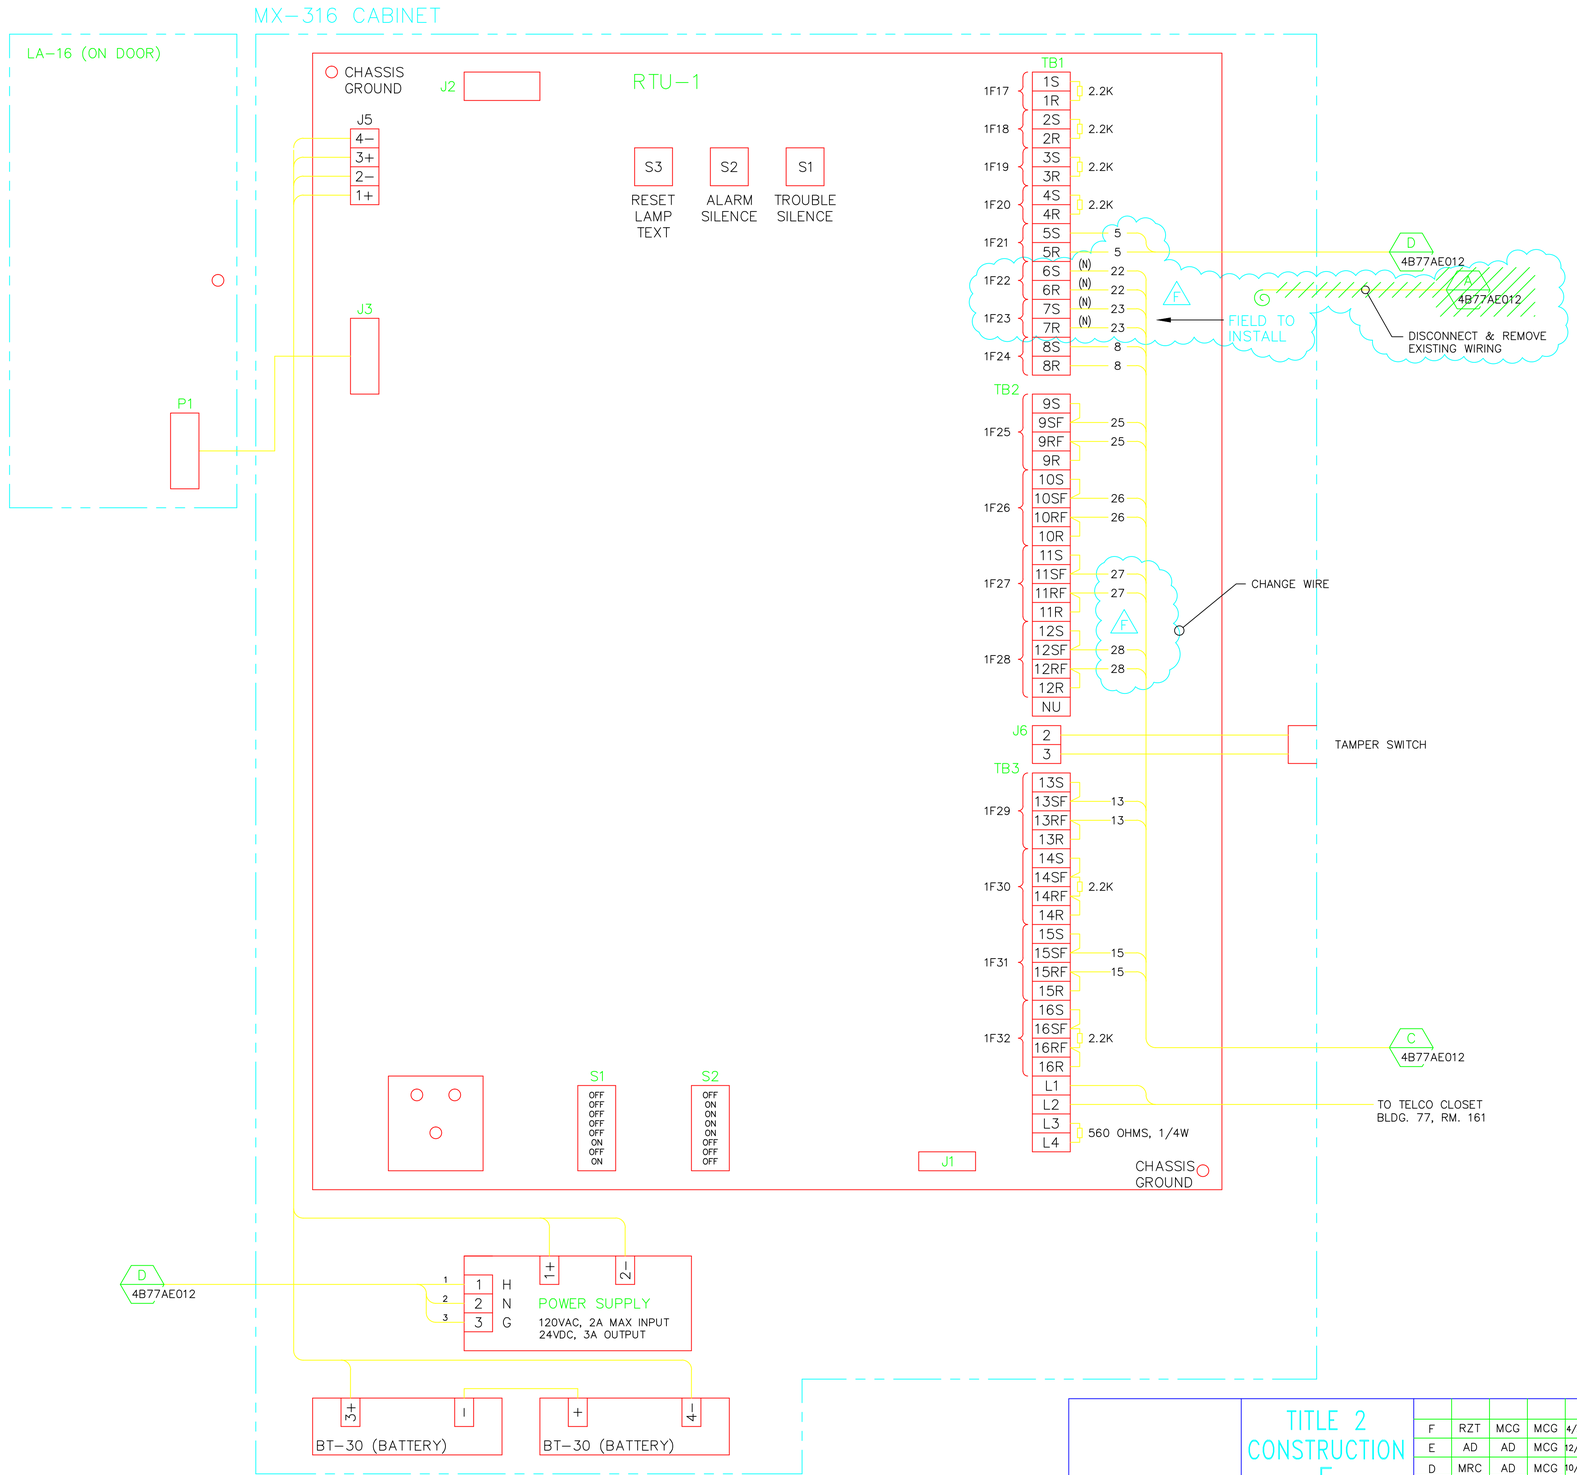

REFERENCE DRAWINGS

1. 4B77AE009 LOGIC DIAGRAM
2. 4B77AE012 FAP-00-77A SYS 3 INTERCONNECTION DIAGRAM

TITLE 2
CONSTRUCTION
F
4/26/2005

REVISION NUMBER	DRAWN BY	CHECKED BY	APPR'D BY	DATE	REMARKS
F	RZT	MCG	MCG	4/26/05	REVISED FOR DIGITIZE SYSTEM
E	AD	AD	MCG	12/17/03	AS-BUILT, RECORD DRAWING
D	MRC	AD	MCG	10/21/03	AS-BUILT, PHASE II FA UPGRADE
C	HYT	HYT	–	2/12/02	REPLACEMENT FIRE ALARM PROJECT
B	LSR	ROB	MCG	2-3-95	AS BUILT REV A
A	RB	BHS	BHS	1-7-94	MODIFY ZONE WIRING

PROFESSIONAL SEAL (IF REVISION, APPLIES ONLY TO REVISED WORK)

ISSUE (PROGRESS, ESTIMATE, BID, CONSTRUCTION, CONFORMED, REVISION, RECORD)

77A FIRE ALARM
MX-316 TR-132
INTERCONNECTION DIAGRAM

UNIVERSITY OF CALIFORNIA
LAWRENCE BERKELEY NATIONAL LABORATORY
FACILITIES DIVISION

DRAWN BY	LSR	DATE 3/23/1994
CHECKED BY	JEH	3/24/1994
APPROVED BY	ROB	3/24/1994
CAD FILE PATH	00019351	
SCALE	As Noted	
DRAWING NO.	4B77AE013F	SHEET
PROJECT NO.	120581	1 OF 1