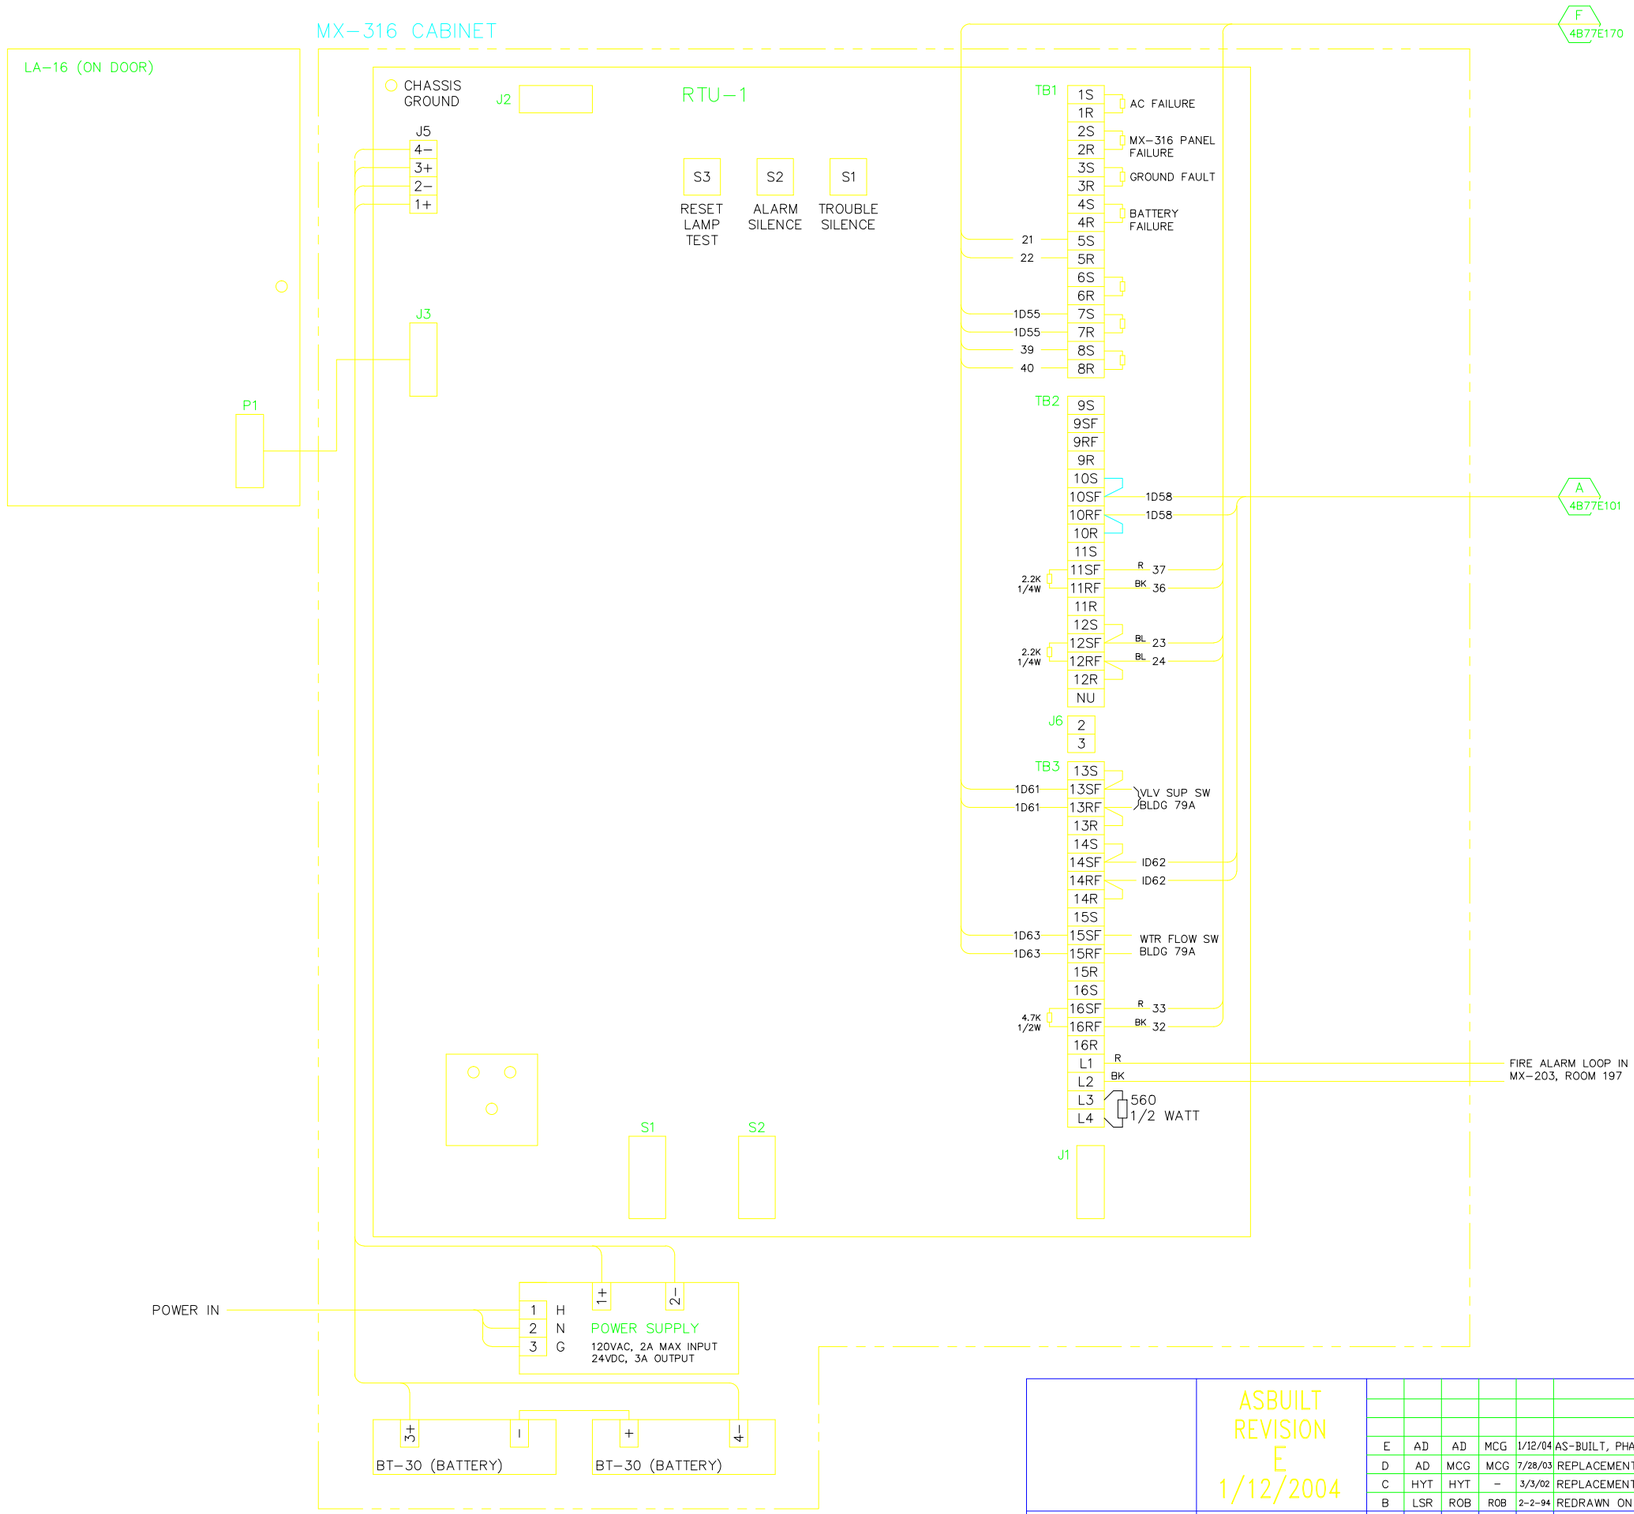

REFERENCE DWGS:

4B77E046	PLAN
4B77E047	LOGIC - TR 148
4B77E052	LOGIC - TR 122 - RMS 141D & E, CHEM STORAGE
4B77E054	MX-203 & SYS 3 PNL #1 INTERCONNECTION DIAG.
4B77E065	DEVICE WIRING - RMS 141D & E, CHEM STORAGE
4B77E066	SCHEM. DIAG. - RMS 141D & E, CHEM STORAGE
4B77E100	SYS 3 PNL #2 INTERCONNECTION DIAG.

DISTRIBUTION LIST:

2-ELECTRIC SHOP B76 (FILE I & II)
1-B90J (FILE III)
1-STICK FILE B90J

ASBUILT REVISION E 1/12/2004

REVISION NUMBER	DRAWN BY	CHECKED BY	APPR'D BY	DATE	REMARKS
E	AD	AD	MCG	1/12/04	AS-BUILT, PHASE II FIRE ALARM UPGRADE
D	AD	MCG	MCG	7/28/03	REPLACEMENT FIRE ALARM PROJECT
C	HYT	HYT	-	3/3/02	REPLACEMENT FIRE ALARM PROJECT
B	LSR	ROB	ROB	2-2-94	REDRAWN ON AUTCAD AS-BUILT

PROFESSIONAL SEAL (IF REVISION, APPLIES ONLY TO REVISED WORK)

ISSUE (PROGRESS, ESTIMATE, BID, CONSTRUCTION, CONFORMED, REVISION, RECORD)

77
FIRE ALARM SYSTEM
WIRING DIAGRAM FOR TR-122

UNIVERSITY OF CALIFORNIA
LAWRENCE BERKELEY NATIONAL LABORATORY
FACILITIES DIVISION

DRAWN BY	G	DATE 12/5/1988
CHECKED BY		
APPROVED BY	RMG	12/19/1988
CAD FILE PATH	00016928	
SCALE	As Noted	
DRAWING NO.	4B77E053E	SHEET
PROJECT NO.	FA8040	1 OF 1