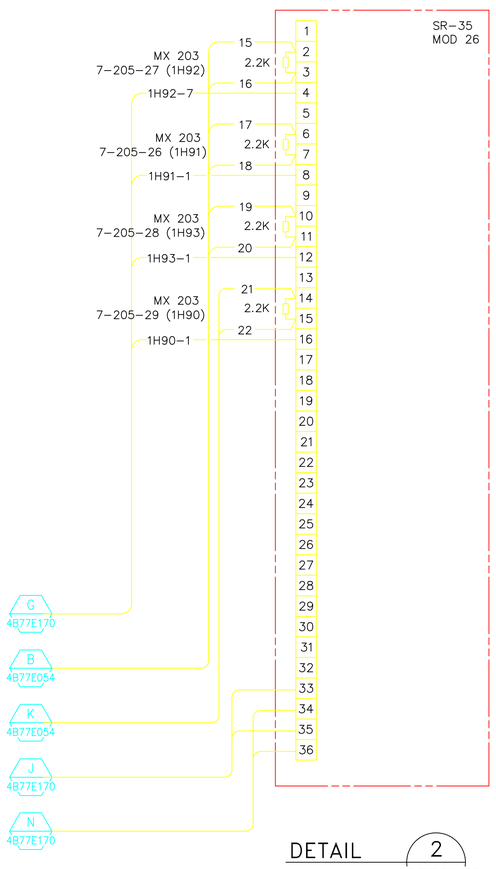

DETAIL 2
4B77E170

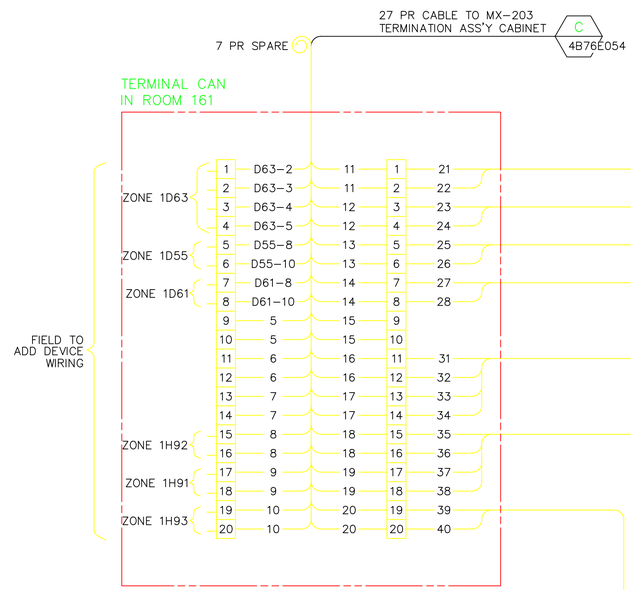

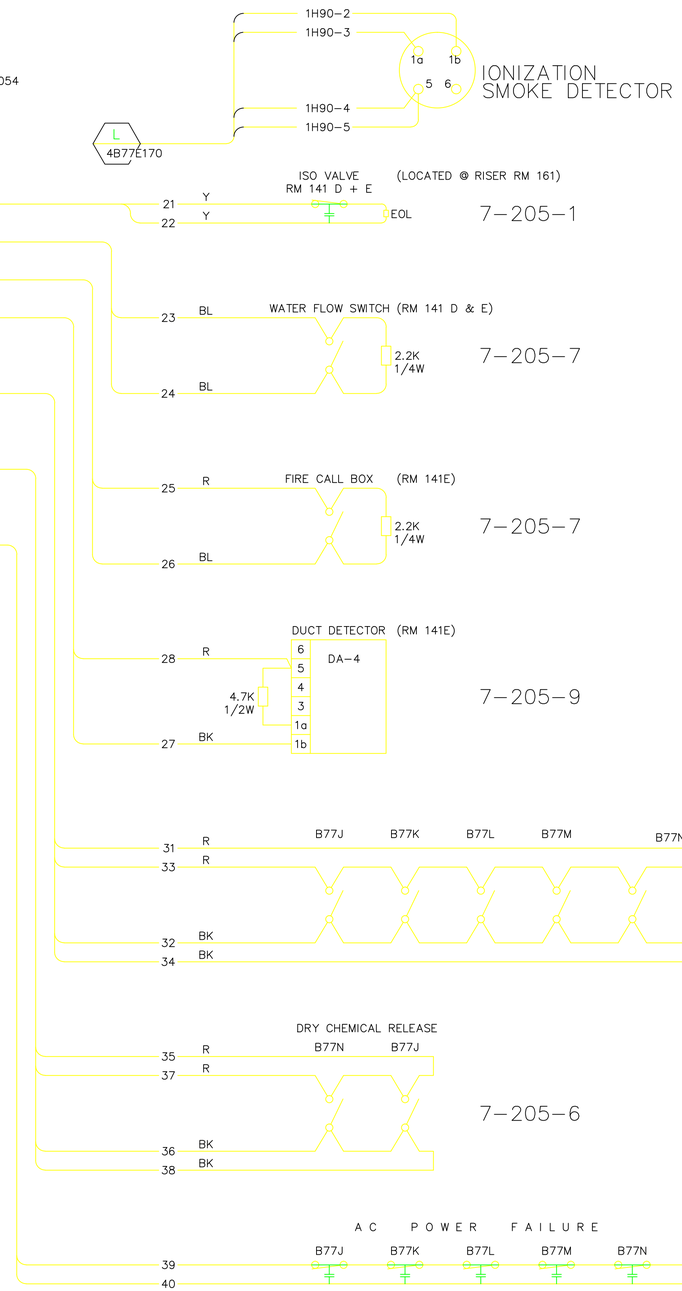

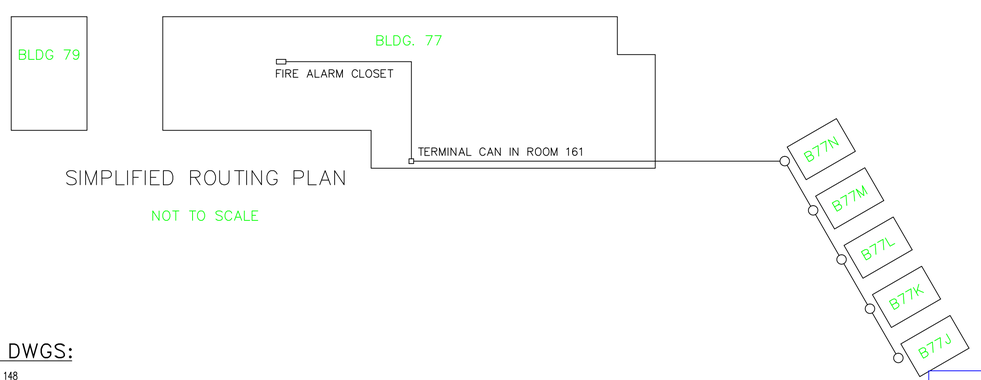

SIMPLIFIED ROUTING PLAN

NOT TO SCALE

REFERENCE DWGS:

4B77E047	LOGIC - TR 148
4B77E052	LOGIC - TR 122 - RMS 141D & E, CHEM STORAGE
4B77E053	RMS 141D & E, CHEM STORAGE MX-316 & SYS 3 PNL #1 INTERCONNECTION DIAG.
4B77E054	MX-203 & SYS 3 PNL #1 INTERCONNECTION DIAG.
4B77E066	SCHEM. DIAG. - RMS 141D & E, CHEM STORAGE
4B77E100	SYS 3 PNL #2 INTERCONNECTION DIAG.

PROFESSIONAL SEAL (IF REVISION, APPLIES ONLY TO REVISED WORK)

ISSUE (PROGRESS, ESTIMATE, BID, CONSTRUCTION, CONFORMED, REVISION, RECORD)

AS BUILT
E
4/27/2005

REVISION NUMBER	DRAWN BY	CHECKED BY	APPR'D BY	DATE	REMARKS
E	DSV	LDD	MCD	6/13/13	AS BUILT PER FIELD VERIFICATION
D	RZT	RZT	MCG	4/27/05	REVISED FOR FIELD VERIFICATION.
C	AD	AD	MCG	01/12/03	AS-BUILT, PHASE II FIRE ALARM UPGRADE
B	MRC	MCG	MCG	7/29/03	PHASE II FIRE ALARM UPGRADE
A	LM	MCG	MCG	6/25/98	CONSTRUCTION COMPLETE, FIELD TO VERIFY

77 FIRE ALARM
FIRE ALARM SYSTEM
DEVICE WIRING

UNIVERSITY OF CALIFORNIA
LAWRENCE BERKELEY NATIONAL LABORATORY
FACILITIES DIVISION

		DATE
DRAWN BY	LSR	2/1/1994
CHECKED BY	RB	2/2/1994
APPROVED BY	ROB	2/2/1994
CAD FILE PATH		
SCALE	As Noted	
DRAWING NO.	4B77E065E	SHEET 1 OF 1
PROJECT NO.	FA8040	