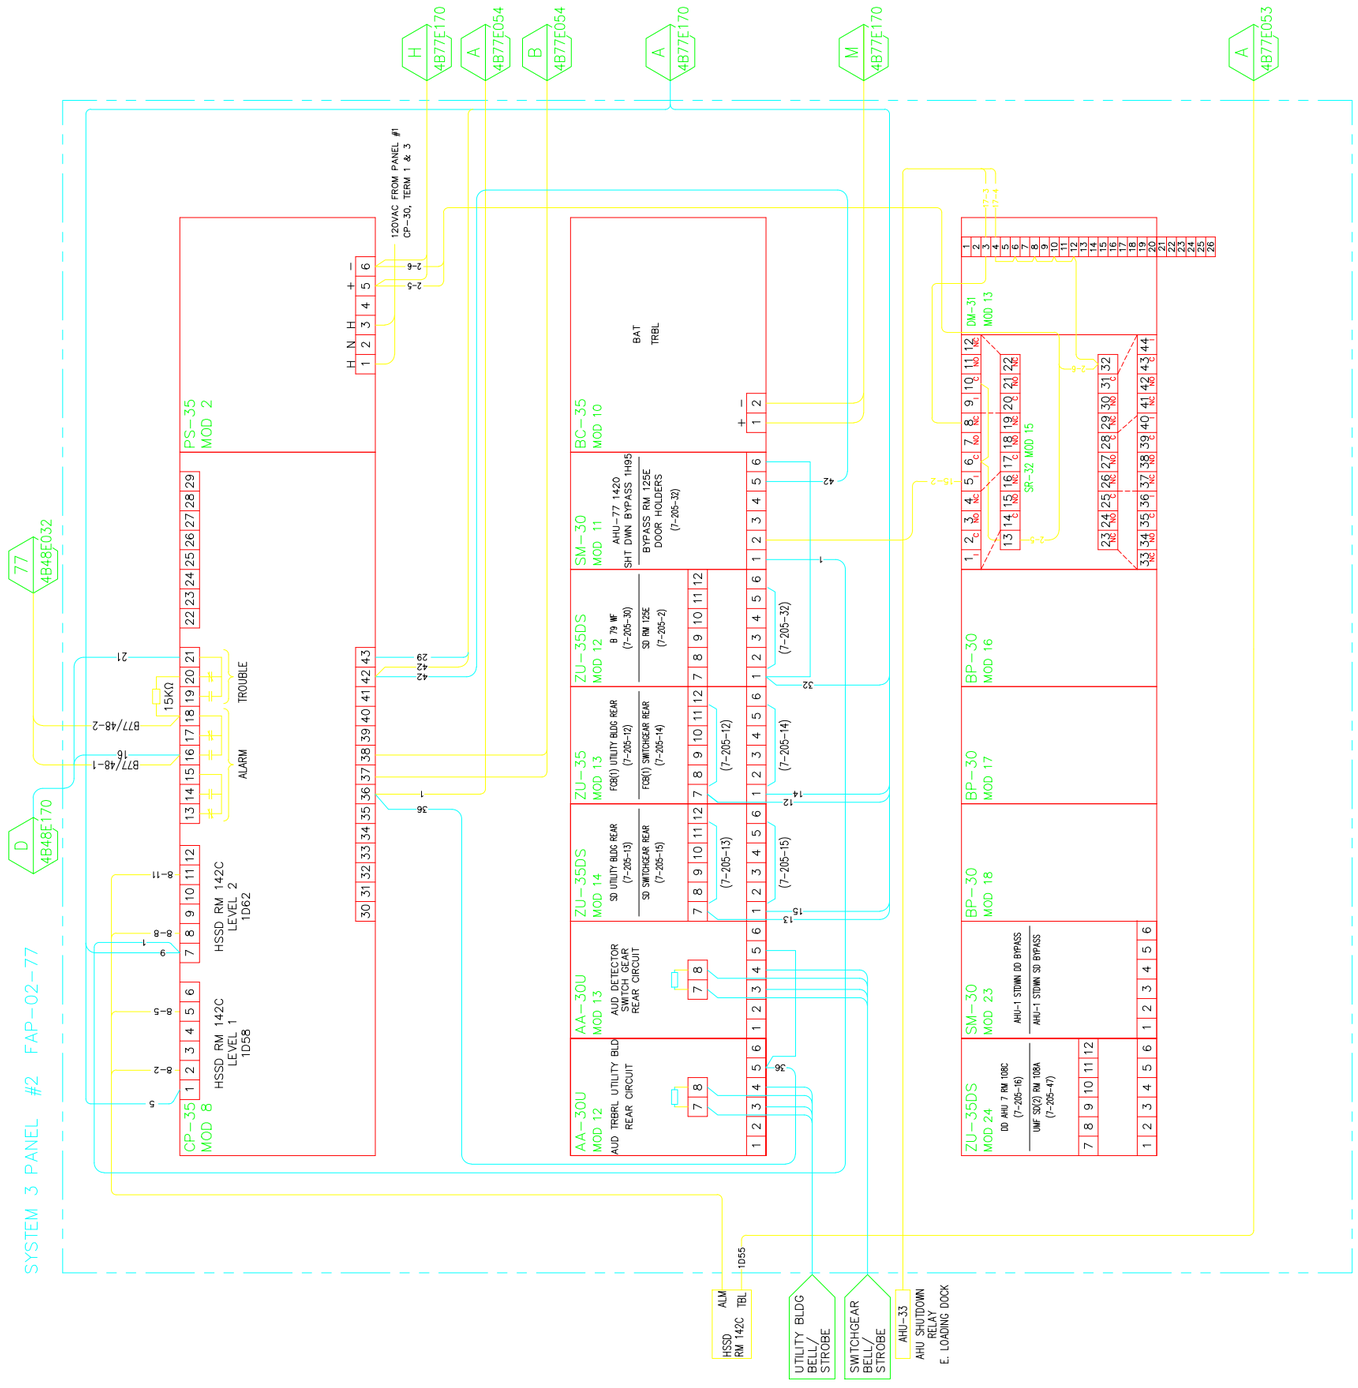

REFERENCE DWGS:

4B77E047	LOGIC DIAG. – TR148
4B77E052	LOGIC DIAG. – TR 122 – RMS 141D & E, CHEM STORAGE
4B77E053	RMS 141D & E, CHEM STORAGE MX-316 & SYS 3 PNL #1 INTERCONNECTION DIAG.
4B77E054	MX-203 & SYS 3 PNL #1 INTERCONNECTION DIAG.
4B77E065	DEVICE WIRING – RMS 141D & E, CHEM STORAGE
4B77E066	SCHEM. DIAG. – RMS 141D & E, CHEM STORAGE
4B77E170	INTERCONNECTION DIAGRAM

AS BUILT
|
6/13/13

REVISION NUMBER	DRAWN BY	CHECKED BY	APPR'D BY	DATE	REMARKS
I	DSV	LDD	MCD	6/13/13	AS BUILT PER FIELD VERIFICATION
H	HYT	HYT	–	06/21/10	HVAC REPLCAEMENT PROJECT
G	RZT	MCG	MCG	4/27/05	REVISED FOR DIGITIZE SYSTEM
F	AD	AD	MCG	1/12/04	AS-BUILT, PHASE II FIRE ALARM UPGRADE
E	MRC	AD	MCG	8/8/03	PHASE II FIRE ALARM UPGRADE
D	HYT	HYT	–	3/29/02	REPLACEMENT FIRE ALARM PROJECT
C	HYT	HYT	–	3/29/02	REPLACEMENT FIRE ALARM PROJECT

PROFESSIONAL SEAL (IF REVISION, APPLIES ONLY TO REVISED WORK)

ISSUE (PROGRESS, ESTIMATE, BID, CONSTRUCTION, CONFORMED, REVISION, RECORD)

77 FIRE ALARM
SYSTEM 3 PANEL #2
INTERCONNECTION DIAGRAM

UNIVERSITY OF CALIFORNIA
LAWRENCE BERKELEY NATIONAL LABORATORY
FACILITIES DIVISION

DRAWN BY	LDD	DATE 1/10/2000
CHECKED BY	LDD	1/10/2000
APPROVED BY	MCG	1/10/2000
CAD FILE PATH		
SCALE	As Noted	
DRAWING NO.	4B77E101I	SHEET FA0.3
PROJECT NO.	FN5100	1 OF 1