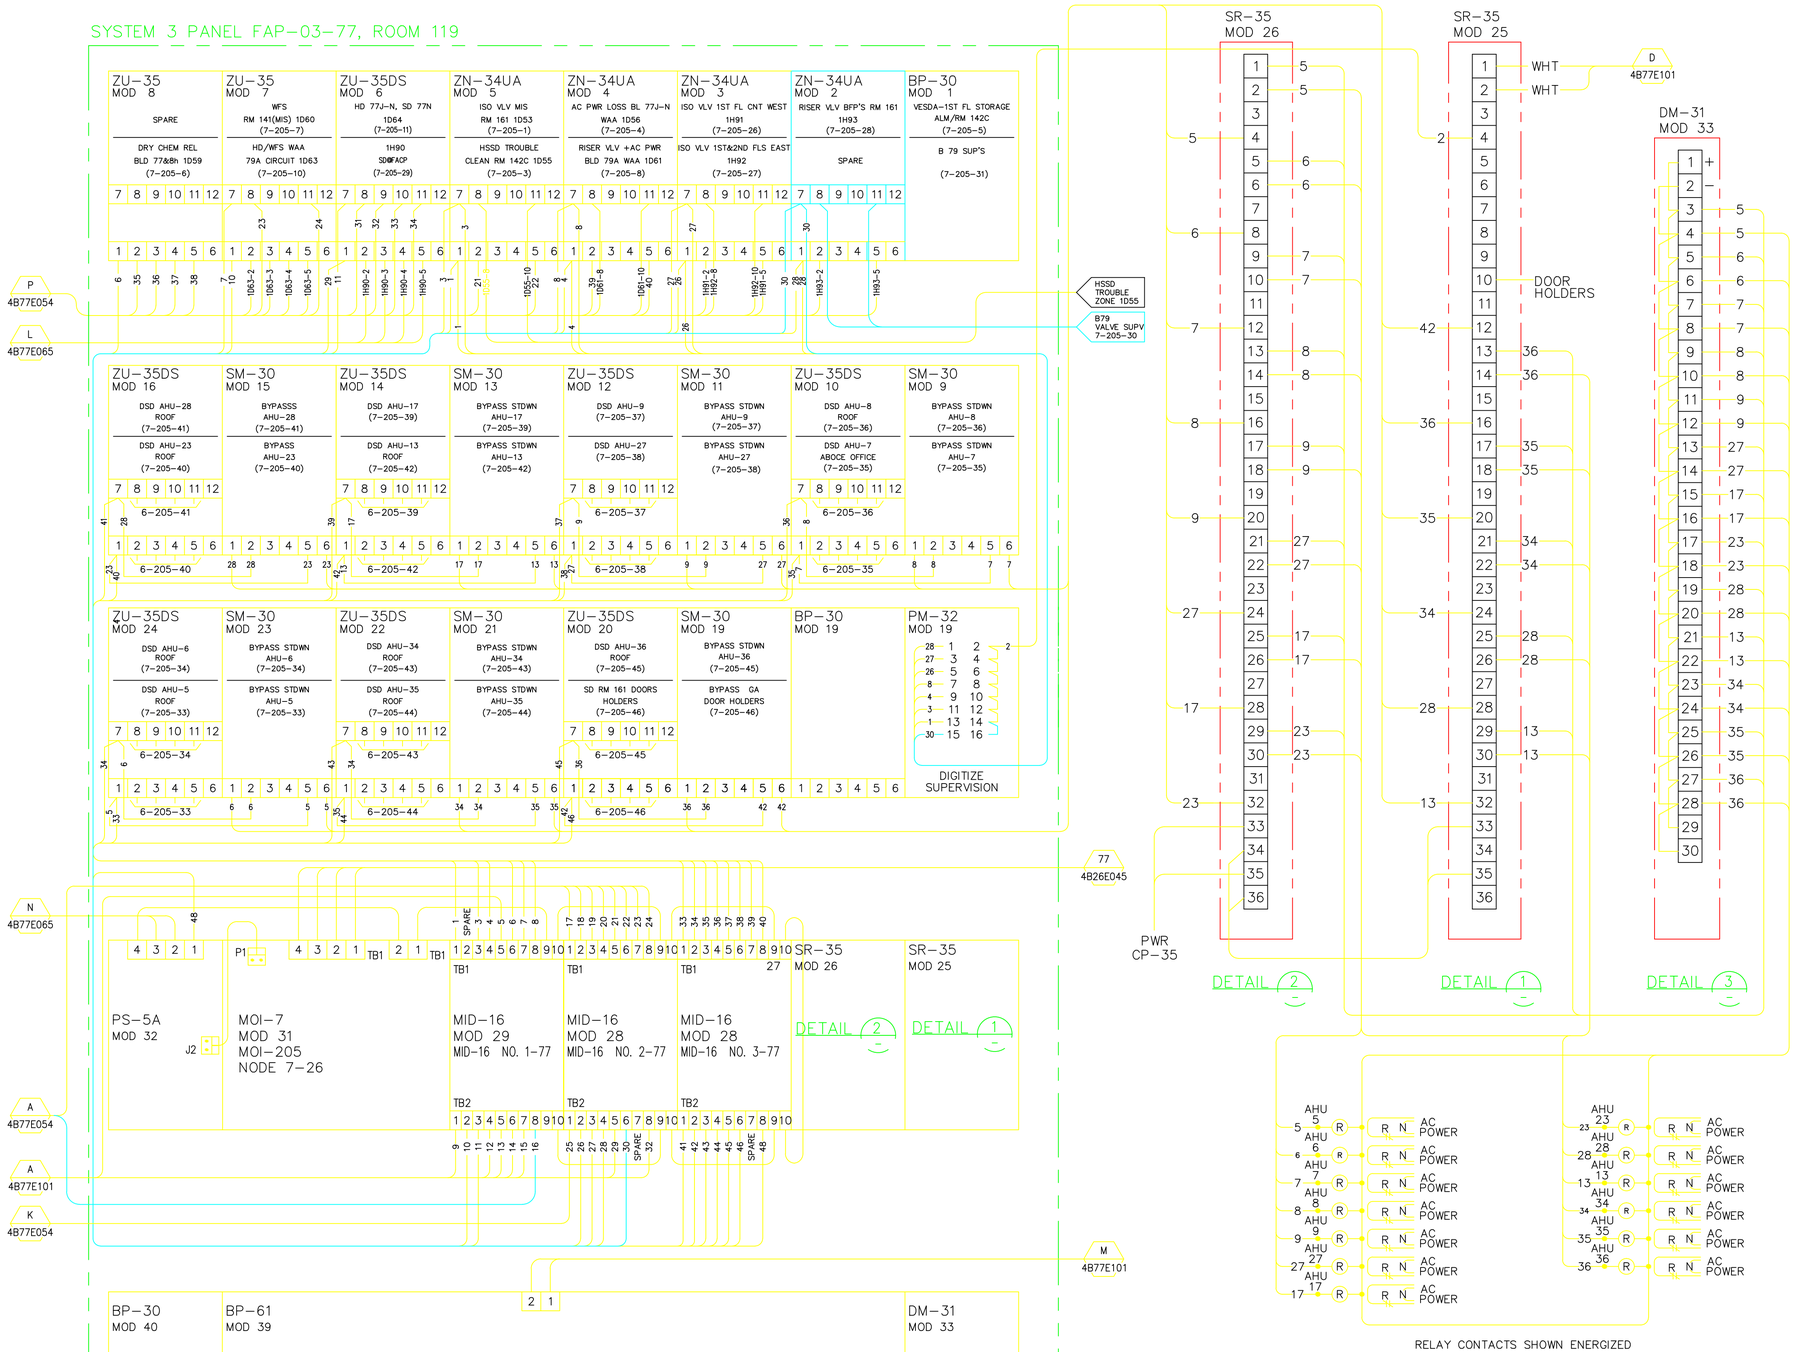

OLD ADDRESS	DESCRIPTION	MID-16 TERMINATION	MODULE TYPE & NO.	MXL NO. 7 AT B26 ADDRESS
1D53	RM. 161 ISO VALVE SUPERVISION	TB. 1 NO. 1	MID-16 NO. 1-77	7-205-1
	SPARE	TB. 1 NO. 3	MID-16 NO. 1-77	7-205-2
1D55	HSSD TROUBLE	TB. 1 NO. 3	MID-16 NO. 1-77	7-205-3
1D56	BLD 77J-N POWER FAILURE	TB. 1 NO. 4	MID-16 NO. 1-77	7-205-4
1D58	HSSD LEVEL 1 ALARM	TB. 1 NO. 5	MID-16 NO. 1-77	7-205-5
1D59	BLD 77J/77N DRY CHEM RELEASE	TB. 1 NO. 6	MID-16 NO. 1-77	7-205-6
1D60	WFS RM 141D & 141E	TB. 1 NO. 7	MID-16 NO. 1-77	7-205-7
1D61	RISER VLV & AC PWR SUPV	TB. 1 NO. 8	MID-16 NO. 1-77	7-205-8
1D62	HSSD LEVEL 2 ALARM	TB. 2 NO. 1	MID-16 NO. 1-77	7-205-9
1D63	WFS	TB. 2 NO. 2	MID-16 NO. 1-77	7-205-10
1D64	HD BLD B77J-77N/SD B77N	TB. 2 NO. 3	MID-16 NO. 1-77	7-205-11
	UTILITY BLDG FCB	TB. 2 NO. 4	MID-16 NO. 1-77	7-205-12
	UTILITY BLDG SD	TB. 2 NO. 5	MID-16 NO. 1-77	7-205-13
	SWITCHGEAR FCB	TB. 2 NO. 6	MID-16 NO. 1-77	7-205-14
	SWITCHGEAR SD	TB. 2 NO. 7	MID-16 NO. 1-77	7-205-15
	BUILDING 79 WATERFLOW	TB. 2 NO. 8	MID-16 NO. 1-77	7-205-16
1H81	FCB & HD 1ST FLOOR WEST	TB. 1 NO. 1	MID-16 NO. 2-77	7-205-17
1H82	FCB & HD 1ST FLOOR CENTER	TB. 1 NO. 2	MID-16 NO. 2-77	7-205-18
1H83	FCB & HD 1ST FLOOR EAST	TB. 1 NO. 3	MID-16 NO. 2-77	7-205-19
1H84	FCB & HD 2ND FLOOR EAST	TB. 1 NO. 4	MID-16 NO. 2-77	7-205-20
1H85	BLD 79 FCB & HD METAL STOR	TB. 1 NO. 5	MID-16 NO. 2-77	7-205-21
1H86	WFS 1ST FLOOR CENTER & WEST	TB. 1 NO. 6	MID-16 NO. 2-77	7-205-22
1H87	WFS 1ST FLOOR EAST	TB. 1 NO. 7	MID-16 NO. 2-77	7-205-23
1H88	WFS 2ND FLOOR & LD	TB. 1 NO. 8	MID-16 NO. 2-77	7-205-24
1H89	RM 165B CO2 RELEASE	TB. 2 NO. 1	MID-16 NO. 2-77	7-205-25
1H91	ISO VLV SUPV 1ST FLR (C&W)	TB. 2 NO. 2	MID-16 NO. 2-77	7-205-26
1H92	ISO VLV SUPV 1ST/2ND FLR (E)	TB. 2 NO. 3	MID-16 NO. 2-77	7-205-27
1H93	RISER VALVE SUPERVISION	TB. 2 NO. 4	MID-16 NO. 2-77	7-205-28
1H90	FIRE ALARM SD, "FA" CLOSET	TR. 2 NO. 5	MID-16 NO. 2-77	7-205-29
	BUILDING 79 VALVE SUPERVISION	TR. 2 NO. 6	MID-16 NO. 2-77	7-205-30
1H95	SYSTEM 3 TROUBLE	TR. 2 NO. 7	MID-16 NO. 2-77	7-205-31
	RM 125 SD FOR DOOR HOLDERS	TR. 2 NO. 8	MID-16 NO. 2-77	7-205-32
	AHU 5 DSD	TB. 1 NO. 1	MID-16 NO. 3-77	7-205-33
	AHU 6 DSD	TB. 1 NO. 2	MID-16 NO. 3-77	7-205-34
	AHU 7 DSD	TB. 1 NO. 3	MID-16 NO. 3-77	7-205-35
	AHU 8 DSD	TB. 1 NO. 4	MID-16 NO. 3-77	7-205-36
	AHU 9 DSD	TB. 1 NO. 5	MID-16 NO. 3-77	7-205-37
	AHU 27 DSD	TB. 1 NO. 6	MID-16 NO. 3-77	7-205-38
	AHU 17 DSD	TB. 1 NO. 7	MID-16 NO. 3-77	7-205-39
	AHU 23 DSD	TB. 1 NO. 8	MID-16 NO. 3-77	7-205-40
	AHU 28 DSD	TB. 2 NO. 1	MID-16 NO. 3-77	7-205-41
	AHU 13 DSD	TB. 2 NO. 2	MID-16 NO. 3-77	7-205-42
	AHU 34 DSD	TB. 2 NO. 3	MID-16 NO. 3-77	7-205-43
	AHU 35 DSD	TB. 2 NO. 4	MID-16 NO. 3-77	7-205-44
	AHU 36 DSD	TB. 2 NO. 5	MID-16 NO. 3-77	7-205-45
	SD RM. 161 DOOR HOLDERS	TB. 2 NO. 6	MID-16 NO. 3-77	7-205-46
	SPARE	TB. 2 NO. 7	MID-16 NO. 3-77	7-205-47
	MID RIBBON UNPLUGGED	TB. 2 NO. 8	MID-16 NO. 3-77	7-205-48

AS BUILT
H
6/13/13

REVISION NUMBER	DRAWN BY	CHECKED BY	APPR'D BY	DATE	REMARKS
H	DSV	LDD	MCD	6/13/13	AS BUILT PER FIELD VERIFICATION
G	HYT	HYT	–	8/26/11	BUILDING 79 RENOVATION PROJECT
F	HYT	HYT	–	4/06/2/10	HVAC REPLACEMENT RECORD DRAWING
E	HYT	HYT	–	4/16/09	REHAB BLDG. STRUCTURE/SYSTEMS PH. 2
D	HYT	HYT	–	1/29/07	REHAB BLDG. STRUCTURE/SYSTEMS PH. 2
C	AD	LDD	MCD	7/31/06	REVISED FOR MXL COPPER LOOP
B	AD	AD	MCG	1/12/04	AS-BUILT, PHASE II FIRE ALARM UPGRADE

PROFESSIONAL SEAL (IF REVISION, APPLIES ONLY TO REVISED WORK)
ISSUE (PROGRESS, ESTIMATE, BID, CONSTRUCTION, CONFORMED, REVISION, RECORD)

77 FIRE ALARM SYSTEM
SYSTEM 3 PANEL FAP-03-77
INTERCONNECTION DIAGRAM, LOOP NO. 7

UNIVERSITY OF CALIFORNIA
LAWRENCE BERKELEY NATIONAL LABORATORY
FACILITIES DIVISION

DRAWN BY MRC	DATE 8/8/2003	
CHECKED BY AD	8/8/2003	
APPROVED BY MCG	8/8/2003	
CAD FILE PATH		
SCALE As Noted		
DRAWING NO. 4B77E170H	SHEET FA0.3	
PROJECT NO. FC1046	1 OF 1	