LEGEND

- FAP — EXISTING FIRE ALARM CONTROL PANEL
- B — EXISTING FIRE ALARM NOTIFICATION APPLIANCE (BELL)
- EXISTING FIRE ALARM CONDUIT RACEWAY
- 75 cd S — NEW FIRE ALARM NOTIFICATION APPLIANCE (STROBE) CANDELA AS NOTED
- J — NEW FIRE ALARM RACEWAY JUNCTION BOX
- A — NEW FIRE ALARM CONDUIT RACEWAY (3/4–INCH DIAMETER MINIMUM)
  - A: SINGLE PAIR AWG #14 THHN CONDUCTORS
  - 2A: TWO PAIR AWG #14 THHN CONDUCTORS

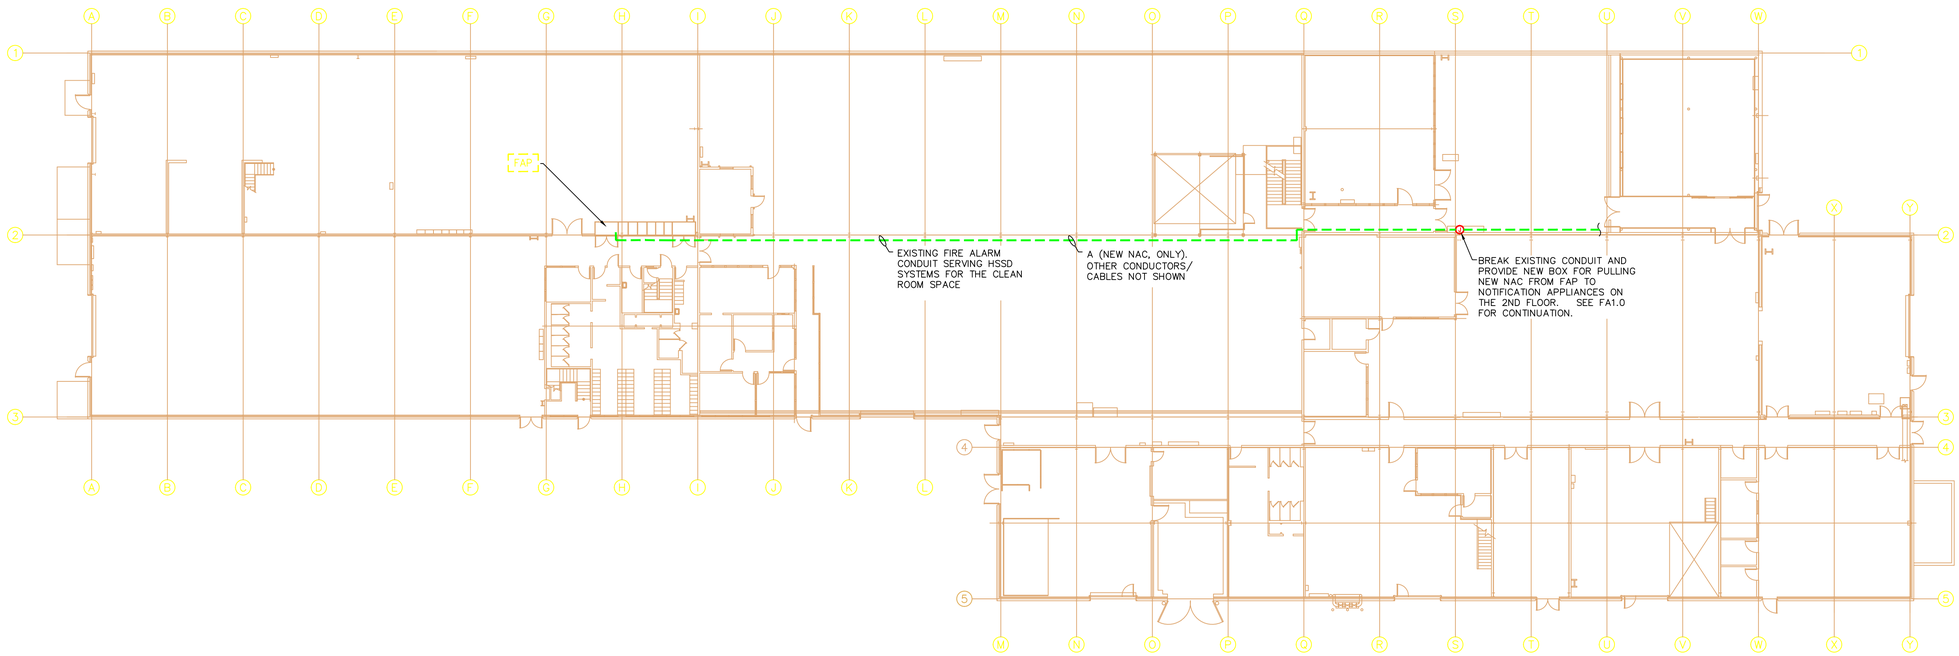

1 BUILDING 77 FIRE ALARM PLAN – 1st FLOOR
1" = 20'–0"

BUILDING KEYPLAN

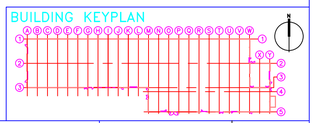

PROFESSIONAL SEAL (IF REVISION, APPLIES ONLY TO REVISED WORK)	ISSUE (PROGRESS, ESTIMATE, BID, CONSTRUCTION, CONFORMED, REVISION, RECORD)	REVISION NUMBER	DRAWN BY	CHECKED BY	APPR'D BY	DATE	REMARKS
	AS BUILT – – 07/20/11						

77
ROOM 25 MOVES
FIRE ALARM SYSTEM

UNIVERSITY OF CALIFORNIA
LAWRENCE BERKELEY NATIONAL LABORATORY
FACILITIES DIVISION

DRAWN BY HYT	DATE 06/04/05
CHECKED BY HYT	06/04/05
APPROVED BY –	–
CAD FILE PATH	
SCALE AS SHOWN	
DRAWING NO. 4B77E193A	SHEET FA2.0
PROJECT NO. FX4031	1 OF 1