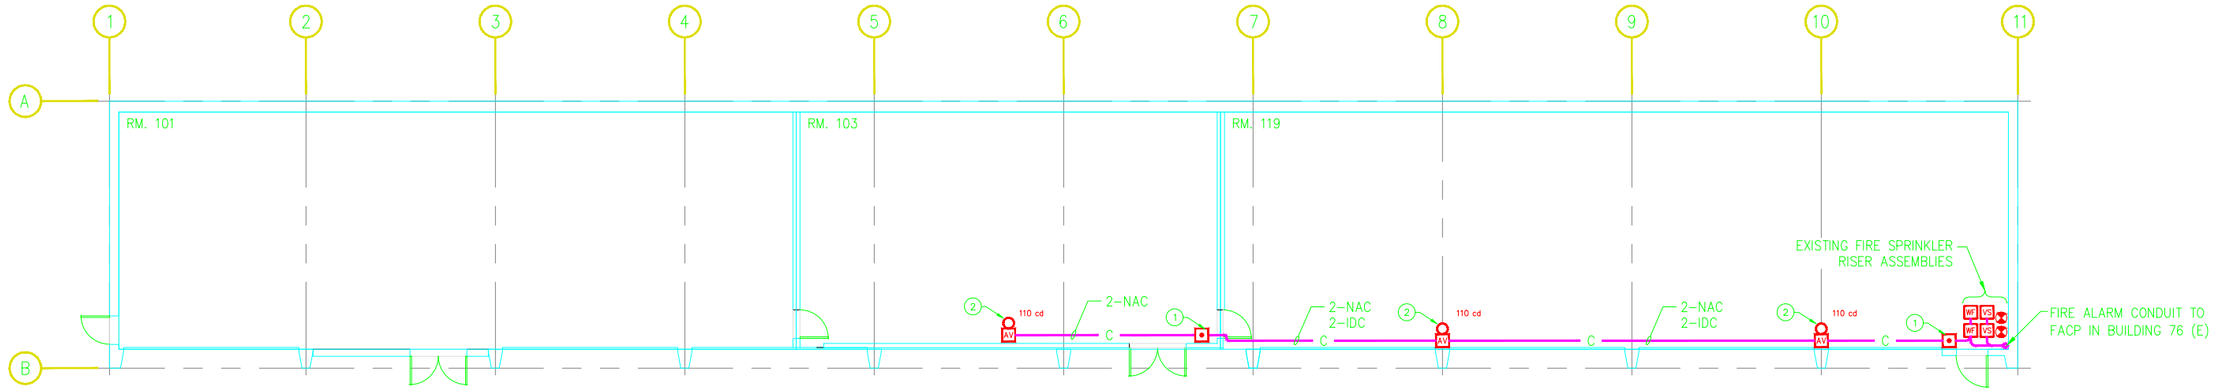

1 / FA10 BUILDING 78 FIRE ALARM PLAN

SCALE: 1/8"=1'-0"

8' 4' 0' 8' 16'
GRAPHIC SCALE: 1/8" = 1'-0"

PLAN NORTH

KEYPLAN–BUILDING 78

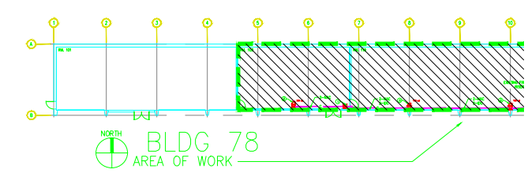

LEGEND

- EXISTING FIRE ALARM CONTROL PANEL
- WATERFLOW SWITCH (E)
- VALVE POSITION SUPERVISORY SWITCH (E)
- NEW BELL/STROBE
- RACEWAY JUNCTION BOX
- EXISTING FIRE ALARM CONDUIT
- —C— NEW ¾ INCH FIRE ALARM CONDUIT
- 2–NAC = 2 PAIR NAC CONDUCTORS
  2–IDC = 2 PAIR IDCS CONDUCTORS

KEYNOTES

1. PROVIDE AND INSTALL NEW FIRE CALL BOX, WIRED TO FACP (E) IN BUILDING 76.
2. PROVIDE AND INSTALL NEW OCCUPANT NOTIFICATION APPLIANCE (BELL/STROBE), WIRED TO FACP (E) IN BUILDING 76.

HYT Corporation
Fire Protection Engineers and Consultants
3498 Clayton Road - Suite 101 Concord, California 94519
Phone: (925) 681-2731 FAX: (925) 681-2733

RECORD DRAWING
11/06/09

RM	CONSULTING FIRM	CONSULTING A/E FIRM	PROFESSIONAL SEAL (IF REVISION, APPLIES ONLY TO REVISED WORK)	ISSUE (PROGRESS, ESTIMATE, IND, CONSTRUCTION, CONFORMED, REVISION, AS-BUILT)	REVISION NUMBER	DRAWN BY	CHECKED BY	APPR'D BY	DATE	REMARKS

78
SHOP RELOCATION
FIRE ALARM SYSTEM MODIFICATIONS

UNIVERSITY OF CALIFORNIA
LAWRENCE BERKELEY NATIONAL LABORATORY
BERKELEY LAB
FACILITIES DIVISION

DRAWN BY	DWH	DATE 01
CHECKED BY	BBT	01
APPROVED BY		
CAD FILE PATH	00022894	
SCALE	As Noted	
DRAWING NO.	4B78E018	F
PROJECT NO.	FP8300	