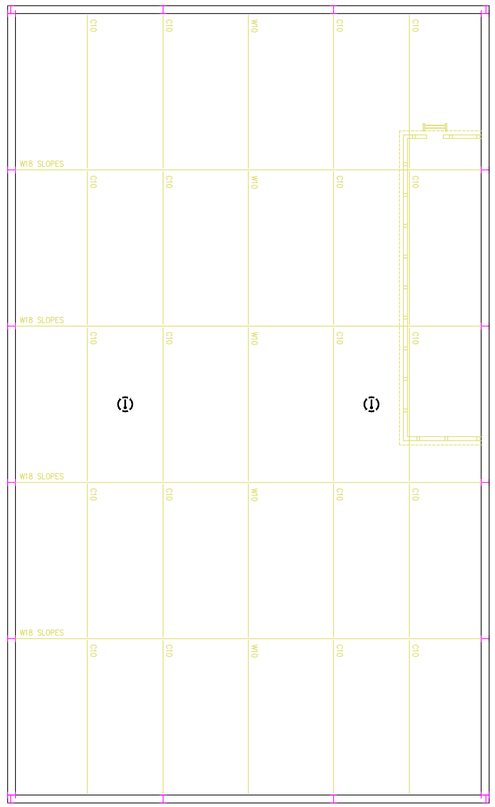

1 FA2.1 ROOF FIRE ALARM PLAN
SCALE: 1/8"=1'-0"

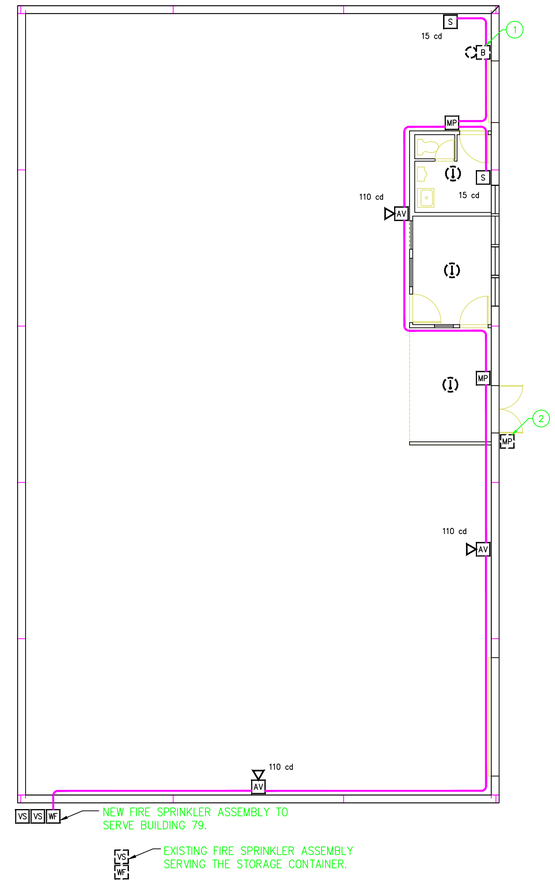

2 FA2.1 MEZZANINE FIRE ALARM PLAN
SCALE: 1/8"=1'-0"

WORK ITEM NOTES:

1. REMOVE EXISTING BELL NOTIFICATION APPLIANCE AND RETURN TO THE UNIVERSITY.
2. REMOVE EXISTING MANUAL FIRE CALL BOX AND RETURN TO THE UNIVERSITY.
3. UTILIZE EXISTING RACEWAY FROM THE FACP IN BUILDING 77 TO BUILDING 79 TO PROVIDE COMMUNICATION BETWEEN THE FACP AND THE NEW DEVICES & APPLIANCES.
4. UTILIZE EXISTING NOTIFICATION APPLIANCE CIRCUIT TO POWER THE NEW OCCUPANT NOTIFICATION APPLIANCES SHOWN.

NOTE:

ONLY THE NEW CONDUIT REQUIRED FOR THIS PROJECT IS SHOWN. EXISTING CONDUIT SERVES THE EXISTING SYSTEMS AND MAY BE USED AS NECESSARY AND APPROPRIATE.

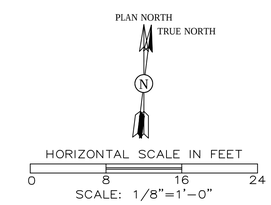

HYT Corporation
Fire Protection Engineers and Consultants
3498 Clayton Road - Suite 101 Concord,
California 94519 Phone: (925) 681-2731

CONSULTING FIRM | CONSULTING FIRM | CONSULTING A/E FIRM

REGISTERED PROFESSIONAL ENGINEER — ROBERT B. TAYLOR — No. 1165 — Exp. 9/30/12 — FIRE PROTECTION — STATE OF CALIFORNIA

PROFESSIONAL SEAL (IF REVISION, APPLIES ONLY TO REVISED WORK)

RECORD DRAWINGS – AS-BUILTS 05/24/2013

ISSUE (PROGRESS, ESTIMATE, BID, CONSTRUCTION, CONFORMED, REVISION, AS-BUILT)

REVISION NUMBER	DRAWN BY	CHECKED BY	APPR'D BY	DATE	REMARKS
A	HYT	LBNL		5/24/13	RECORD DRAWINGS – AS-BUILTS

79
OFFICE CONVERSION
FIRE ALARM SYSTEM
BUILDING PLANS

UNIVERSITY OF CALIFORNIA
LAWRENCE BERKELEY NATIONAL LABORATORY
FACILITIES DIVISION

DRAWN BY HYT	DATE 05/24/2013	
CHECKED BY HYT	09/02/2011	
APPROVED BY		
CAD FILE PATH		
SCALE As Noted		
DRAWING NO. 4B79E008A		SHEET FA2.1
PROJECT NO. FC1046		OF