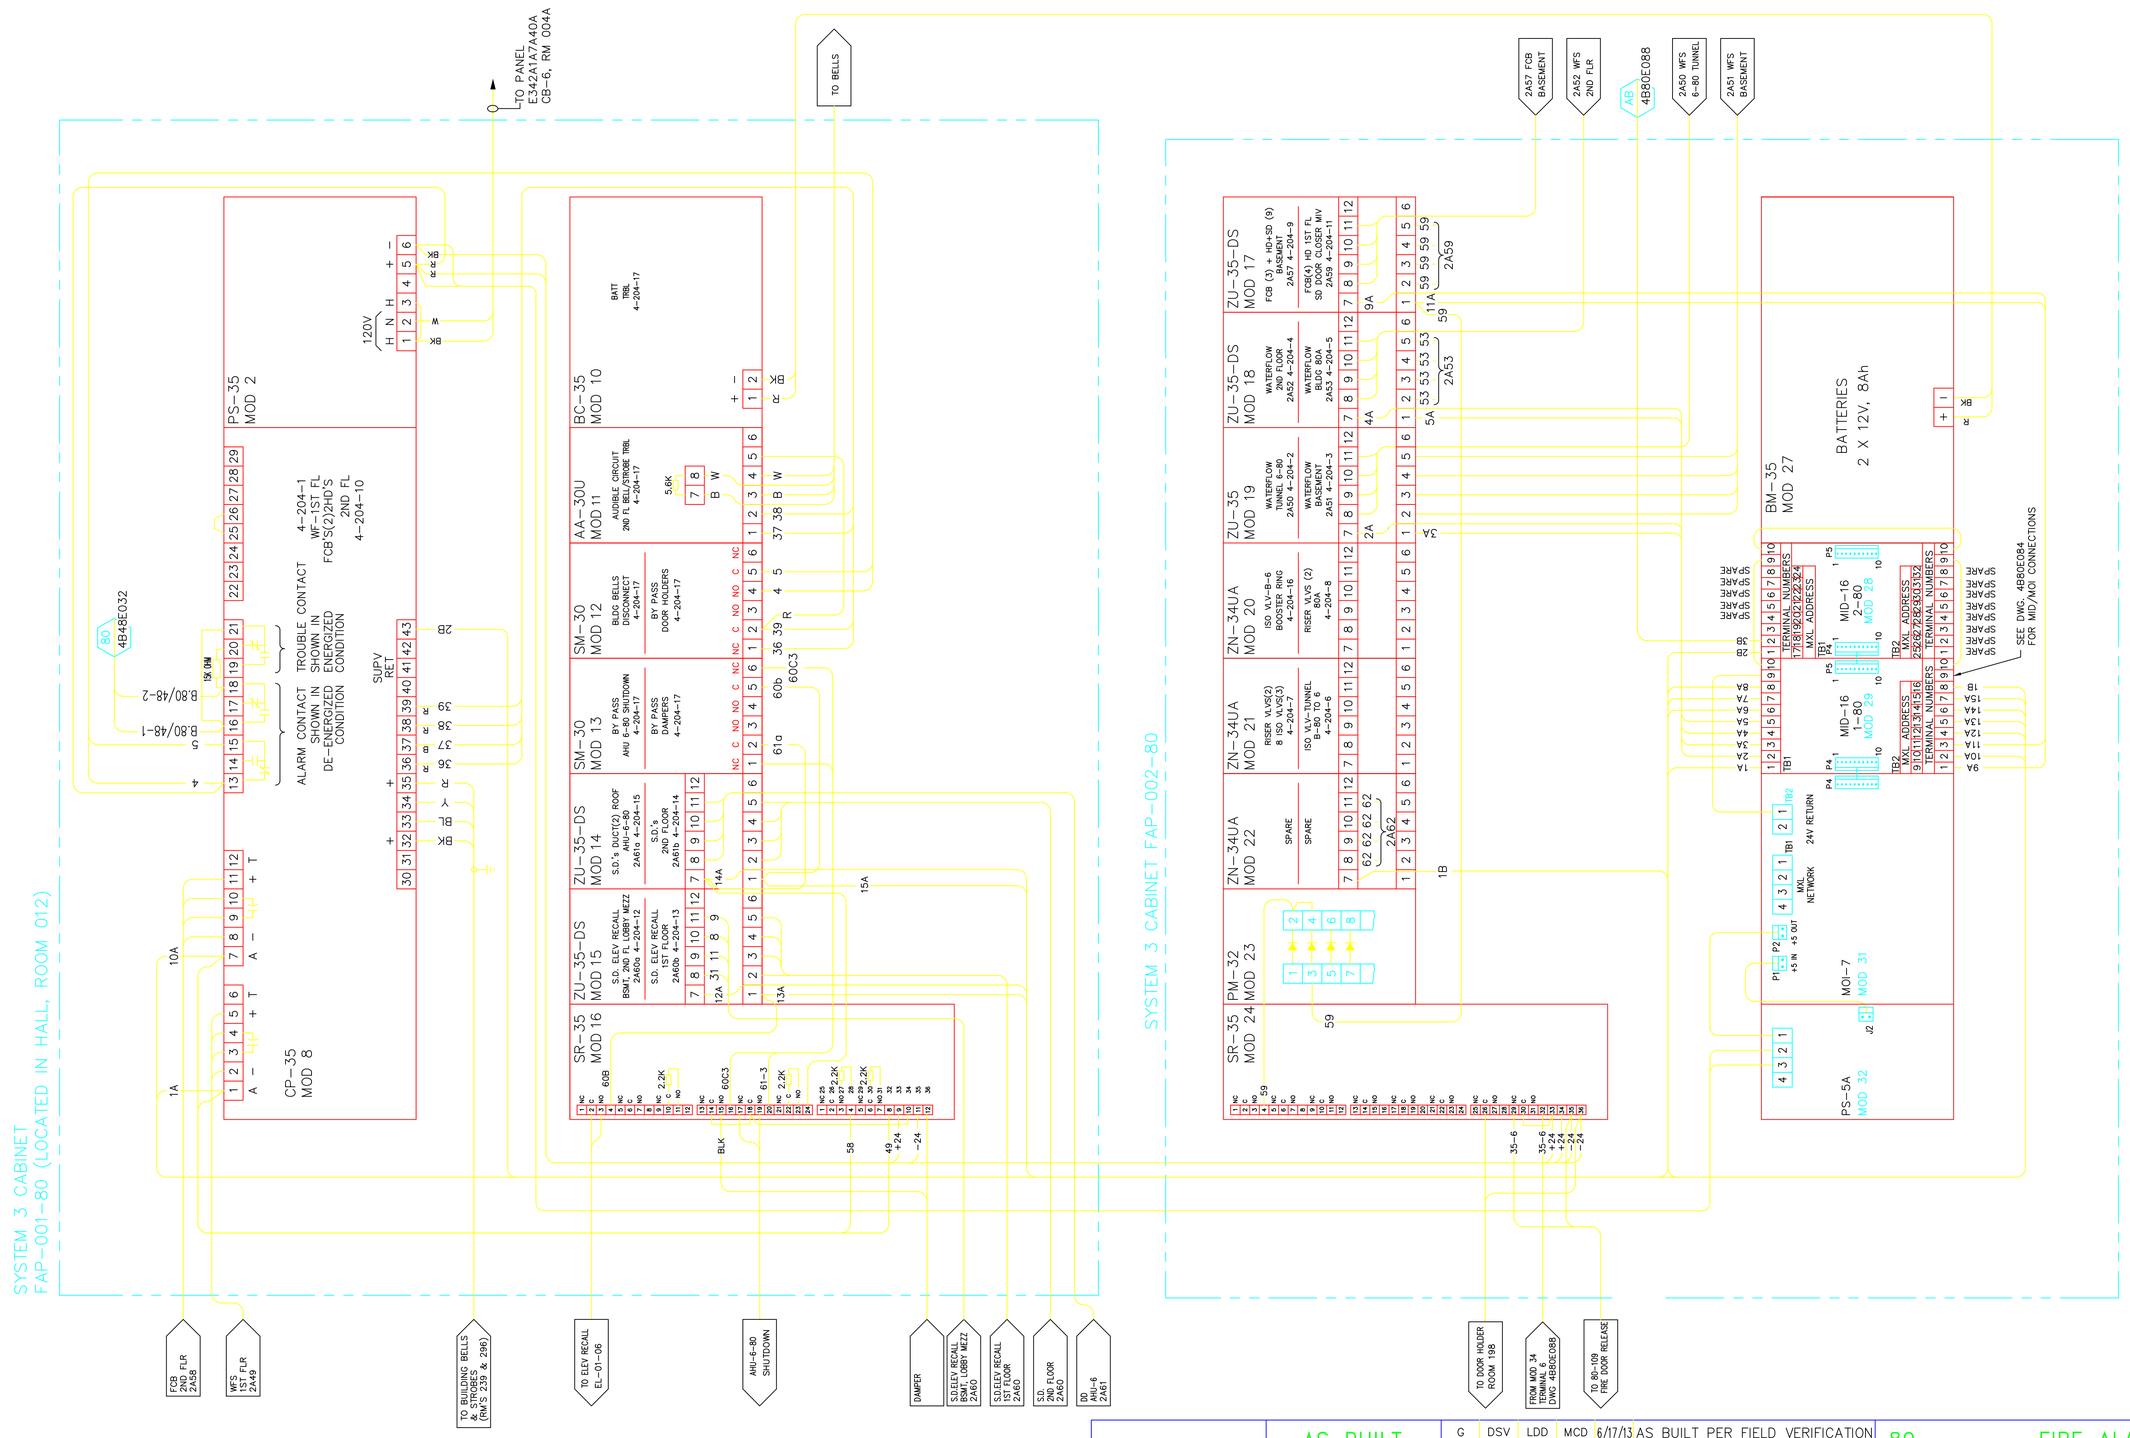

REFERENCE DRAWINGS:

4B80E083 BUILDING 80/80A LOGIC DIAGRAM

4B80E084 BUILDING 80/80A FIRE ALARM SYSTEM, MOI/MID MODULE ARRANGEMENT

4B80E088 BUILDING 80, FIRE ALARM SYSTEM 3 PANEL "FAP-003-80"

AS BUILT

G
6/18/13

REVISION NUMBER	DRAWN BY	CHECKED BY	APPR'D BY	DATE	REMARKS
G	DSV	LDD	MCD	6/17/13	AS BUILT PER FIELD VERIFICATION
F	AD	LDD	MCD	10/17/07	FIRE ALARM SYSTEM UPGRADE
E	AD	MCG	MCG	05/03/05	REVISED FOR MXL/DIGITIZE SYSTEMS
D	AD	MCG	MCG	08/19/03	AS-BUILT, PHASE II FA UPGRADE
C	AD	MCG	MCG	10/25/02	REPLACEMENT FIRE ALARM PROJECT
B	HYT	HYT	XXX	XXX	REPLACEMENT FIRE ALARM PROJECT
A	AD	ROB	MCG	1/25/00	AS BUILT

PROFESSIONAL SEAL (IF REVISION, APPLIES ONLY TO REVISED WORK)

ISSUE (PROGRESS, ESTIMATE, BID, CONSTRUCTION, CONFORMED, REVISION, RECORD)

80 FIRE ALARM SYSTEM
FAP-001-80 & FAP-002-80
SYSTEM 3 CONNECTION DIAGRAM

UNIVERSITY OF CALIFORNIA
LAWRENCE BERKELEY NATIONAL LABORATORY
FACILITIES DIVISION

		DATE
DRAWN BY	FWD	12/14/1998
CHECKED BY	ROB	12/14/1998
APPROVED BY	MCG	12/14/1998
CAD FILE PATH		
SCALE	As Noted	
DRAWING NO.	4B80E073G	SHEET 1 OF 1
PROJECT NO.	FA8040	