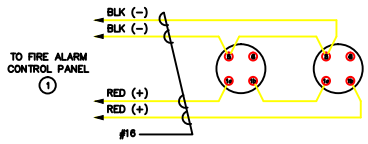

2 FIRE DOOR SMOKE DETECTORS

D1-3 IONIZATION TYPE

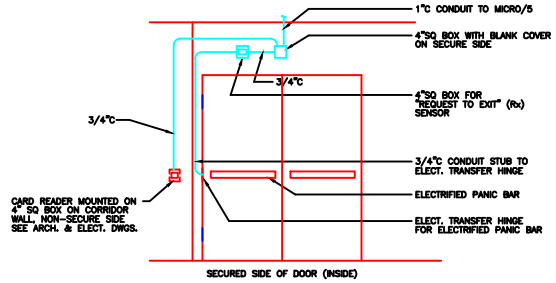

1 DOUBLE DOOR W/PANIC HARDWARE

(ACTIVE LEAF - LEFT SIDE)

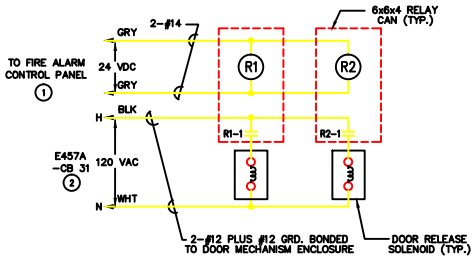

3 FIRE DOOR RELEASE SOLENOIDS

SHEET NOTES:

1. 4-#16, 3/4"C SMOKE DETECTOR CIRCUIT AND 2-#14, 3/4"C DOOR RELEASE CIRCUIT TO BUILDING FIRE ALARM CONTROL PANEL LOCATED IN BASEMENT CORRIDOR ACROSS FROM MENS' ROOM. LEAVE 6 FEET OF TAILS IN THE FIRE ALARM CONTROL PANEL. CONNECTION TO FIRE ALARM SYSTEM BY LBNL.

2. #12, #12 NEUT., #12 GRD., 3/4"C DOOR RELEASE CIRCUIT TO PANEL E457A-CB 31 IN ROOM 163.

REVISION NUMBER	DRAWN BY	CHECKED BY	APPROVED BY	DATE	REMARKS
A	LDD	MCG	MCG	8/4/02	AS BUILT

80 ALS
MODS TO ROOM 80-109
ELECT. & FIRE ALARM DETAILS

UNIVERSITY OF CALIFORNIA LAWRENCE BERKELEY LABORATORY
FACILITIES DEPARTMENT

DRAWN BY	LDD	02/16/01
CHECKED BY	LDD	03/05/01
APPROVED BY	MCG	03/06/01
CAD FILE PATH	00014628	
SCALE	AS NOTED	
DRAWING NO.	4B80E082A	SHEET E2 1 OF 1
PROJECT NO.	FX0067	