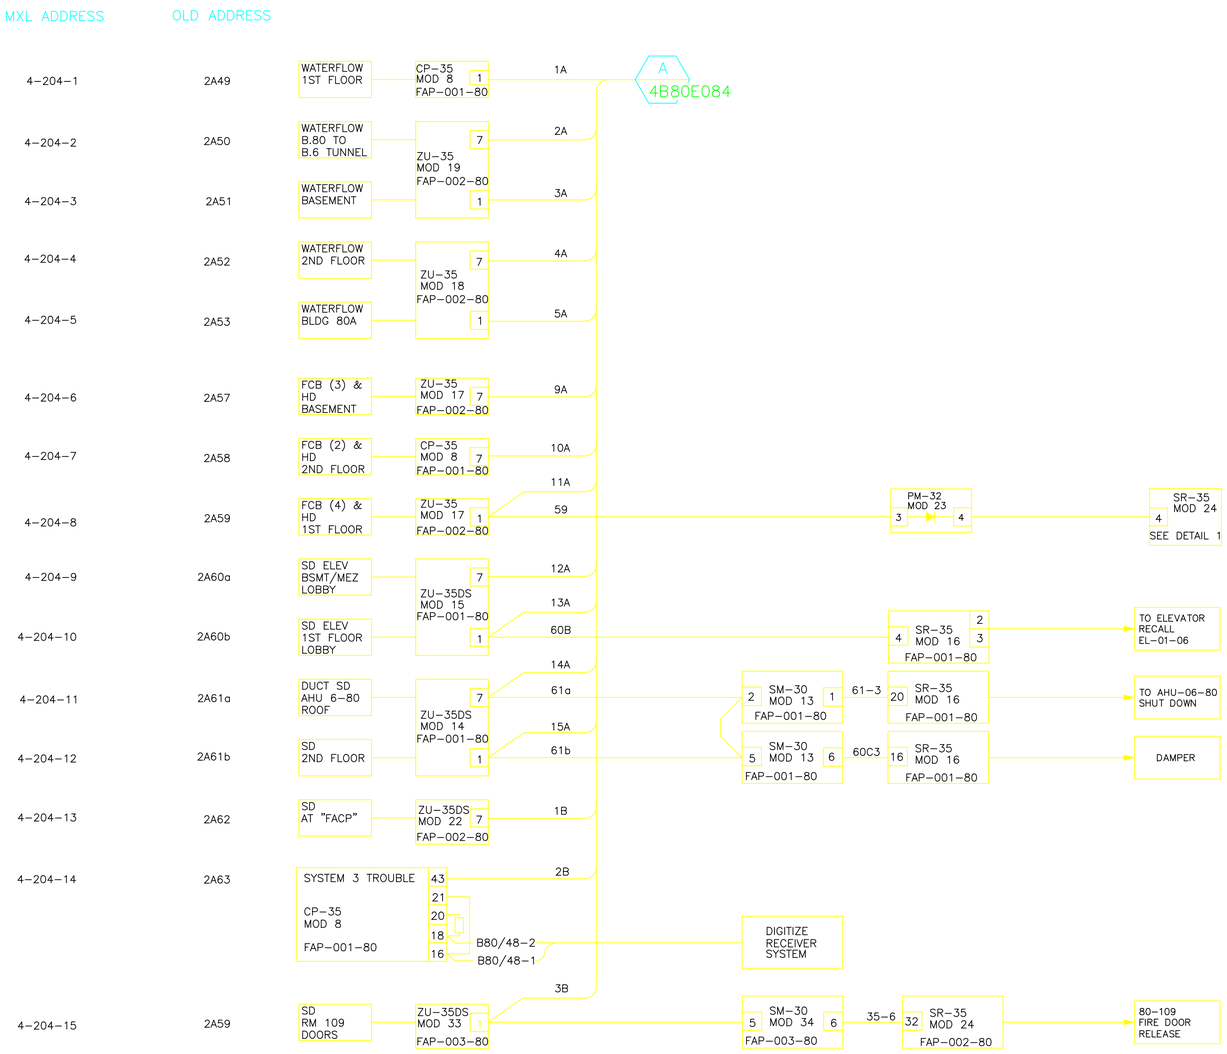

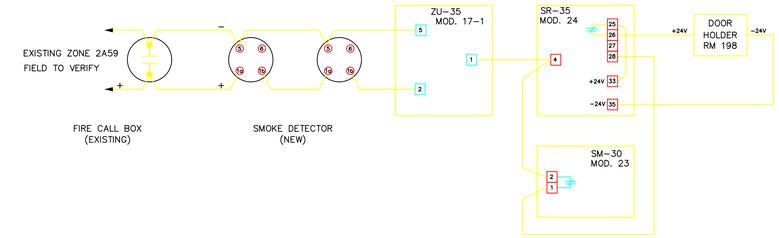

DETAIL 1

D	AD	LDD	MCD	10/12/07	FIRE ALARM SYSTEM UPGRADE	
C	AD	MCG	MCG	04/29/05	REVISED FOR MXL/DIGITIZE SYSTEM	
B	AD	MCG	MCG	08/19/03	AS-BUILT, PHASE II FA UPGRADE	
A	HYT	HYT		03/30/03	ADD NEW SR-35 MODULE	

PROFESSIONAL SEAL (IF REVISION, APPLIES ONLY TO REVISED WORK)

ISSUE (PROGRESS, ESTIMATE, BID, CONSTRUCTION, CONFORMED, REVISION, RECORD)

REVISION NUMBER | DRAWN BY | CHECKED BY | APPR'D BY | DATE | REMARKS

TITLE 2
CONSTRUCTION
D
10/12/2007

80 BLDG'S 80, 80A
REPLACEMENT FIRE ALARM SYSTEM
LOGIC

UNIVERSITY OF CALIFORNIA
LAWRENCE BERKELEY NATIONAL LABORATORY
FACILITIES DIVISION

DRAWN BY HYT 3/30/2003
CHECKED BY HYT 3/30/2003
APPROVED BY 3/30/2003
CAD FILE PATH 00022745
SCALE Full
DRAWING NO. 4B80E083D
PROJECT NO. FA8040
SHEET 1 OF 1