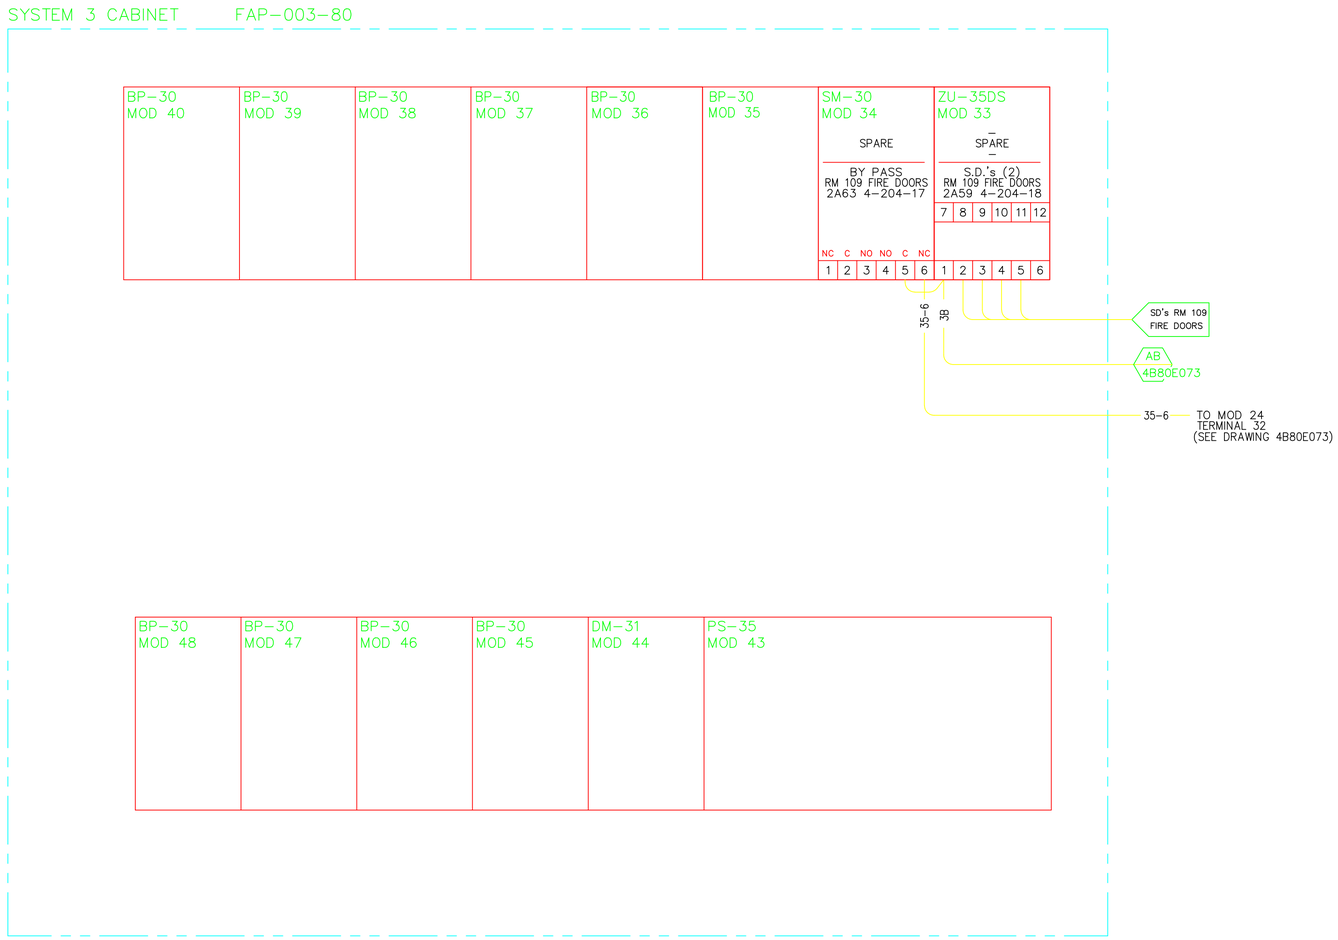

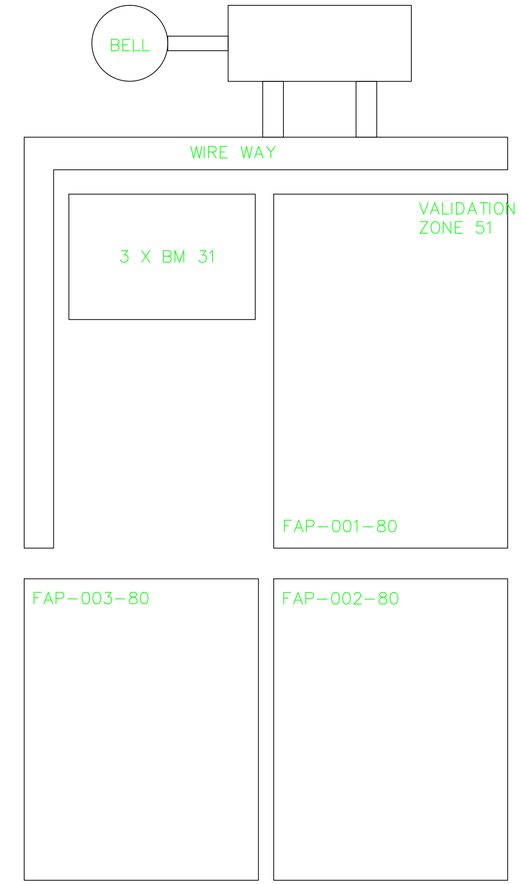

1 FIRE ALARM PANELS ELEVATION
SCALE: NTS

	AS BUILT						
	D 6/18/13	D	DSV	LDD	MCD	6/18/13	AS BUILT PER FIELD VERIFICATION
		C	AD	LDD	MCD	10/18/07	FIRE ALARM SYSTEM UPGRADE
		B	AD	MCG	MCG	05/03/05	REVISED FOR MXL/DIGITIZE SYSTEMS
		A	MRC	MCG	MCG	08/19/03	AS-BUILT PHASE II FIRE ALARM UPGRADE
PROFESSIONAL SEAL (IF REVISION, APPLIES ONLY TO REVISED WORK)	ISSUE (PROGRESS, ESTIMATE, BID, CONSTRUCTION, CONFORMED, REVISION, RECORD)	REVISION NUMBER	DRAWN BY	CHECKED BY	APPR'D BY	DATE	REMARKS

80 FAP-003-80
FIRE ALARM SYSTEM
SYSTEM 3 PANEL FAP-003-80

UNIVERSITY OF CALIFORNIA
LAWRENCE BERKELEY NATIONAL LABORATORY
FACILITIES DIVISION

DRAWN BY	LDD	DATE 12/12/2001
CHECKED BY	MCG	2/1/2002
APPROVED BY	MCG	2/1/2002
CAD FILE PATH		
SCALE	As Noted	
DRAWING NO.	4B80E088D	SHEET
PROJECT NO.	FA8040	1 OF 1