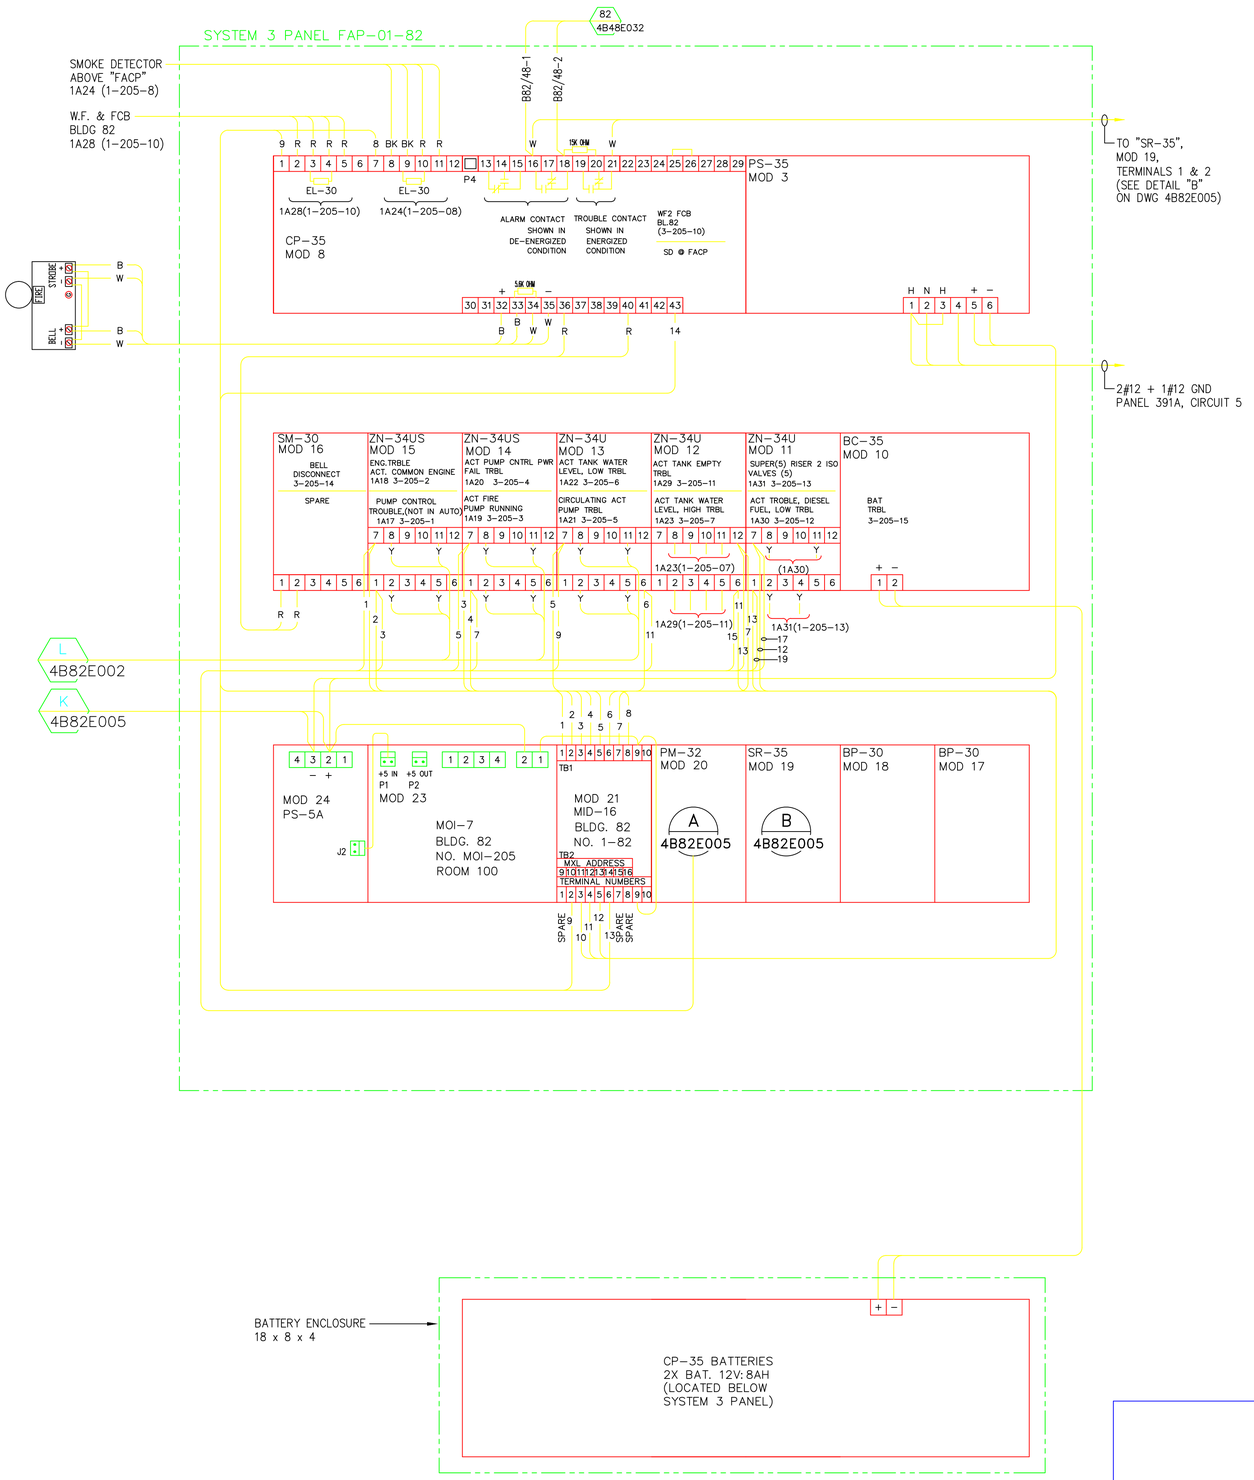

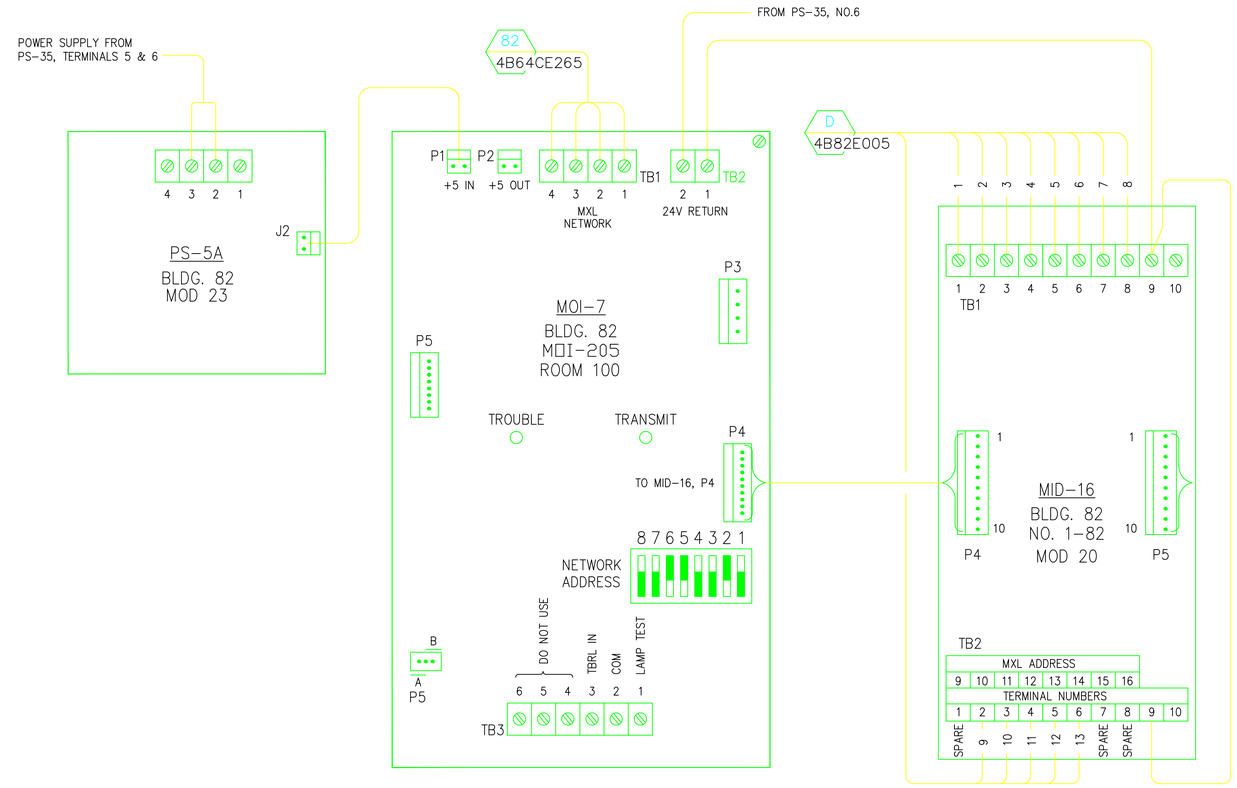

OLD ADDRESS	DESCRIPTION	MID-16 TERMINATION	MODULE TYPE & NO.	MXL 03-64C ADDRESS
1A17	PUMP CONTROLLER, NOT IN AUTOMATIC	TB1 1	MID 16 NO. 1-82	3-205-01
1A18	COMMON ENGINE TROUBLE	TB1 2	MID 16 NO. 1-82	3-205-02
1A19	FIRE PUMP RUNNING, TROUBLE	TB1 3	MID 16 NO. 1-82	3-205-03
1A20	POWER FAILURE, PUMP CONTROLLER	TB1 4	MID 16 NO. 1-82	3-205-04
1A21	CIRCULATING PUMP TROUBLE	TB1 5	MID 16 NO. 1-82	3-205-05
1A22	TANK WATER LEVEL, LOW	TB1 6	MID 16 NO. 1-82	3-205-06
1A23	TANK WATER LEVEL, HIGH	TB1 7	MID 16 NO. 1-82	3-205-07
1A24	SMOKE DETECTOR AT "FACP"	TB1 8	MID 16 NO. 1-82	3-205-08
	SPARE	TB2 1	MID 16 NO. 1-82	
1A28	BUILDING SPRINKLERS, WF	TB2 2	MID 16 NO. 1-82	3-205-09
1A29	SUPERVISION, WATER TANK EMPTY	TB2 3	MID 16 NO. 1-82	3-205-10
1A30	DIESEL FUEL LEVEL, LOW	TB2 4	MID 16 NO. 1-82	3-205-11
1A31	VALVES (5) PUMP SUCTION	TB2 5	MID 16 NO. 1-82	3-205-12
1A32	SYSTEM 3 COMMON TROUBLE	TB2 6	MID 16 NO. 1-82	3-205-13
	SPARE	TB2 7	MID 16 NO. 1-82	3-205-14
	SPARE	TB2 8	MID 16 NO. 1-82	3-205-15

ASBUILT

E
6/18/13

REVISION NUMBER	DRAWN BY	CHECKED BY	APPR'D BY	DATE	REMARKS
E	DSV	LDD	MCD	6/18/13	AS BUILT PER FIELD VERIFICATION
D	AD	LDD	MCD	11/27/07	AS-BUILT RECORD DRAWING
C	AD	LDD	MCD	10/08/07	FIRE ALARM SYSTEM UPGRADE
B	AD	LDD	MCD	03/13/06	REVISED FOR MXL COPPER LOOP
A	AD	LDD	LDD	01/18/06	REVISED AS NOTED

PROFESSIONAL SEAL (IF REVISION, APPLIES ONLY TO REVISED WORK)

ISSUE (PROGRESS, ESTIMATE, BID, CONSTRUCTION, CONFORMED, REVISION, RECORD)

82 FIRE ALARM SYSTEM
SYSTEM 3 PANEL WIRING AND MID/MOI ARRANGEMENT

UNIVERSITY OF CALIFORNIA
LAWRENCE BERKELEY NATIONAL LABORATORY
FACILITIES DIVISION

		DATE
DRAWN BY	AD	6/2/2005
CHECKED BY	MCG	6/2/2005
APPROVED BY	MCG	6/2/2005
CAD FILE PATH		
SCALE	Full	
DRAWING NO.	4B82E006E	SHEET 1 OF 1
PROJECT NO.	WN1787	