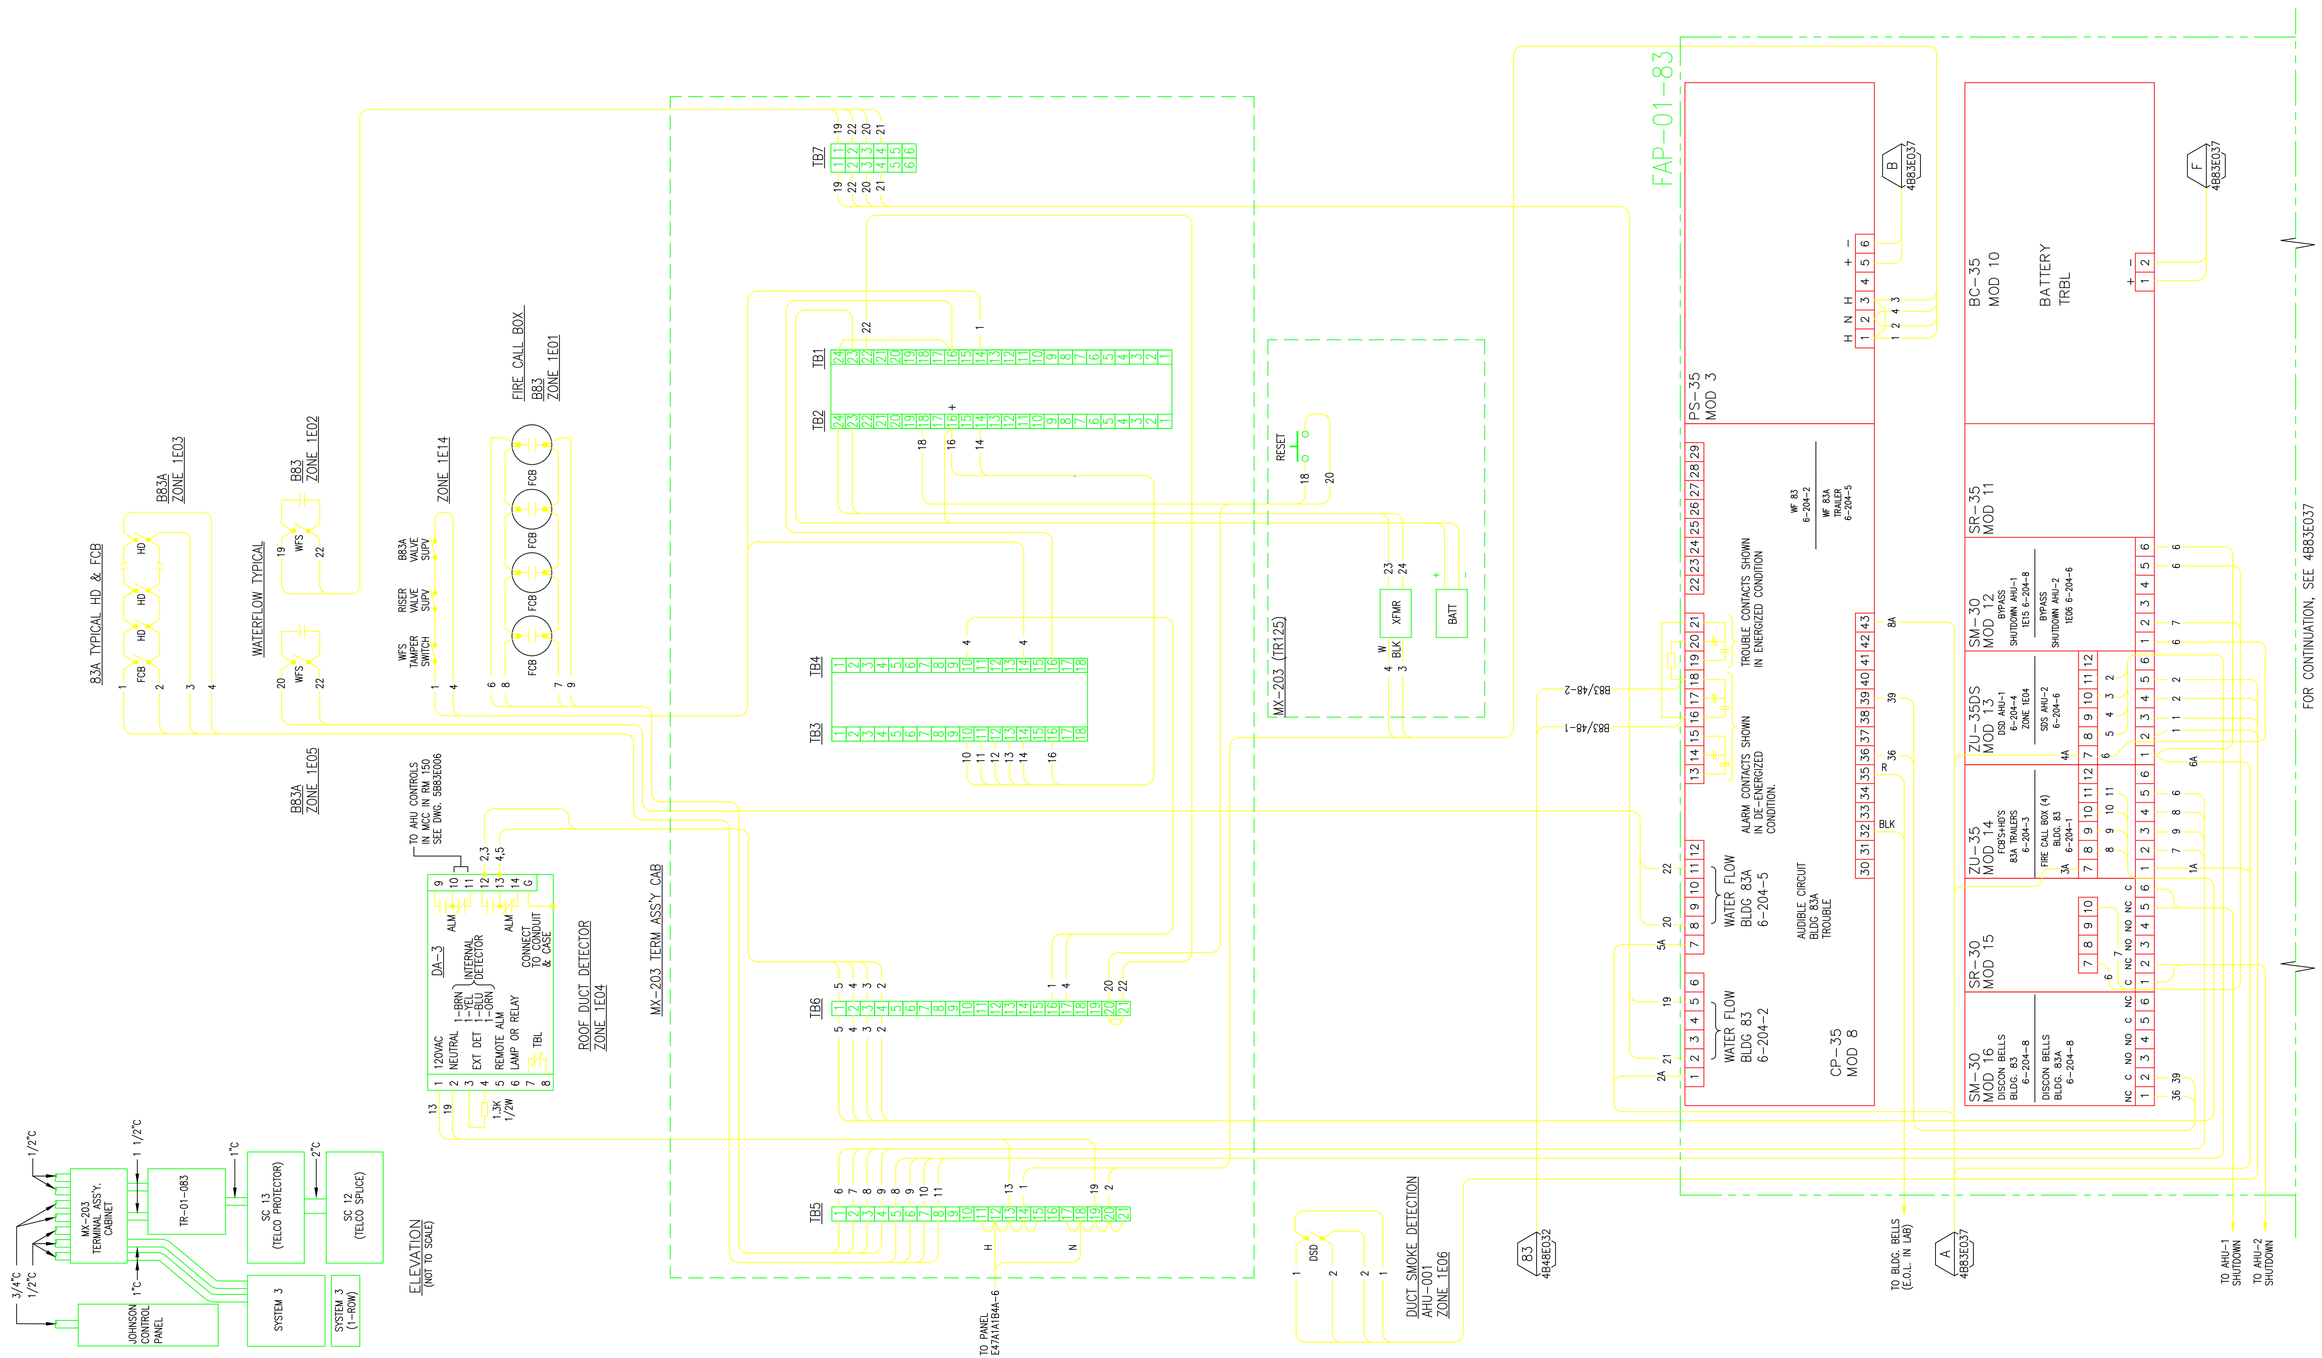

AS BUILT

M
6/18/13

REVISION NUMBER	DRAWN BY	CHECKED BY	APPR'D BY	DATE	REMARKS
M	DSV	LDD	MCD	6/18/13	AS BUILT PER FIELD VERIFICATION
L	AD	–	–	10/29/07	ISSUED FOR REFERENCE ONLY
K	AD	LDD	MCD	10/08/07	FIRE ALARM SYSTEM UPGRADE
J	RZT	MCG	MCG	4/01/05	REVISED FOR DIGITIZE SYSTEM.
I	AD	MCG	MCG	01/10/04	AS-BUILT, PHASE II FA UPGRADE
H	MRC	AD	MCG	10/23/03	AS-BUILT, PHASE II FA UPGRADE
G	HYT	HYT	–	2/12/02	REPLACEMENT FIRE ALARM PROJECT

PROFESSIONAL SEAL (IF REVISION, APPLIES ONLY TO REVISED WORK)

ISSUE (PROGRESS, ESTIMATE, BID, CONSTRUCTION, CONFORMED, REVISION, RECORD)

83

83, 83A

FIRE ALARM SYSTEM
INTERCONNECTION DIAGRAM

UNIVERSITY OF CALIFORNIA
LAWRENCE BERKELEY NATIONAL LABORATORY
FACILITIES DIVISION

DRAWN BY	LSR	DATE 1/9/1986
CHECKED BY	RG	1/9/1986
APPROVED BY	BHS	1/10/1986
CAD FILE PATH		
SCALE	As Noted	
DRAWING NO.	4B83E012M	SHEET
PROJECT NO.	FA8040	1 OF 1