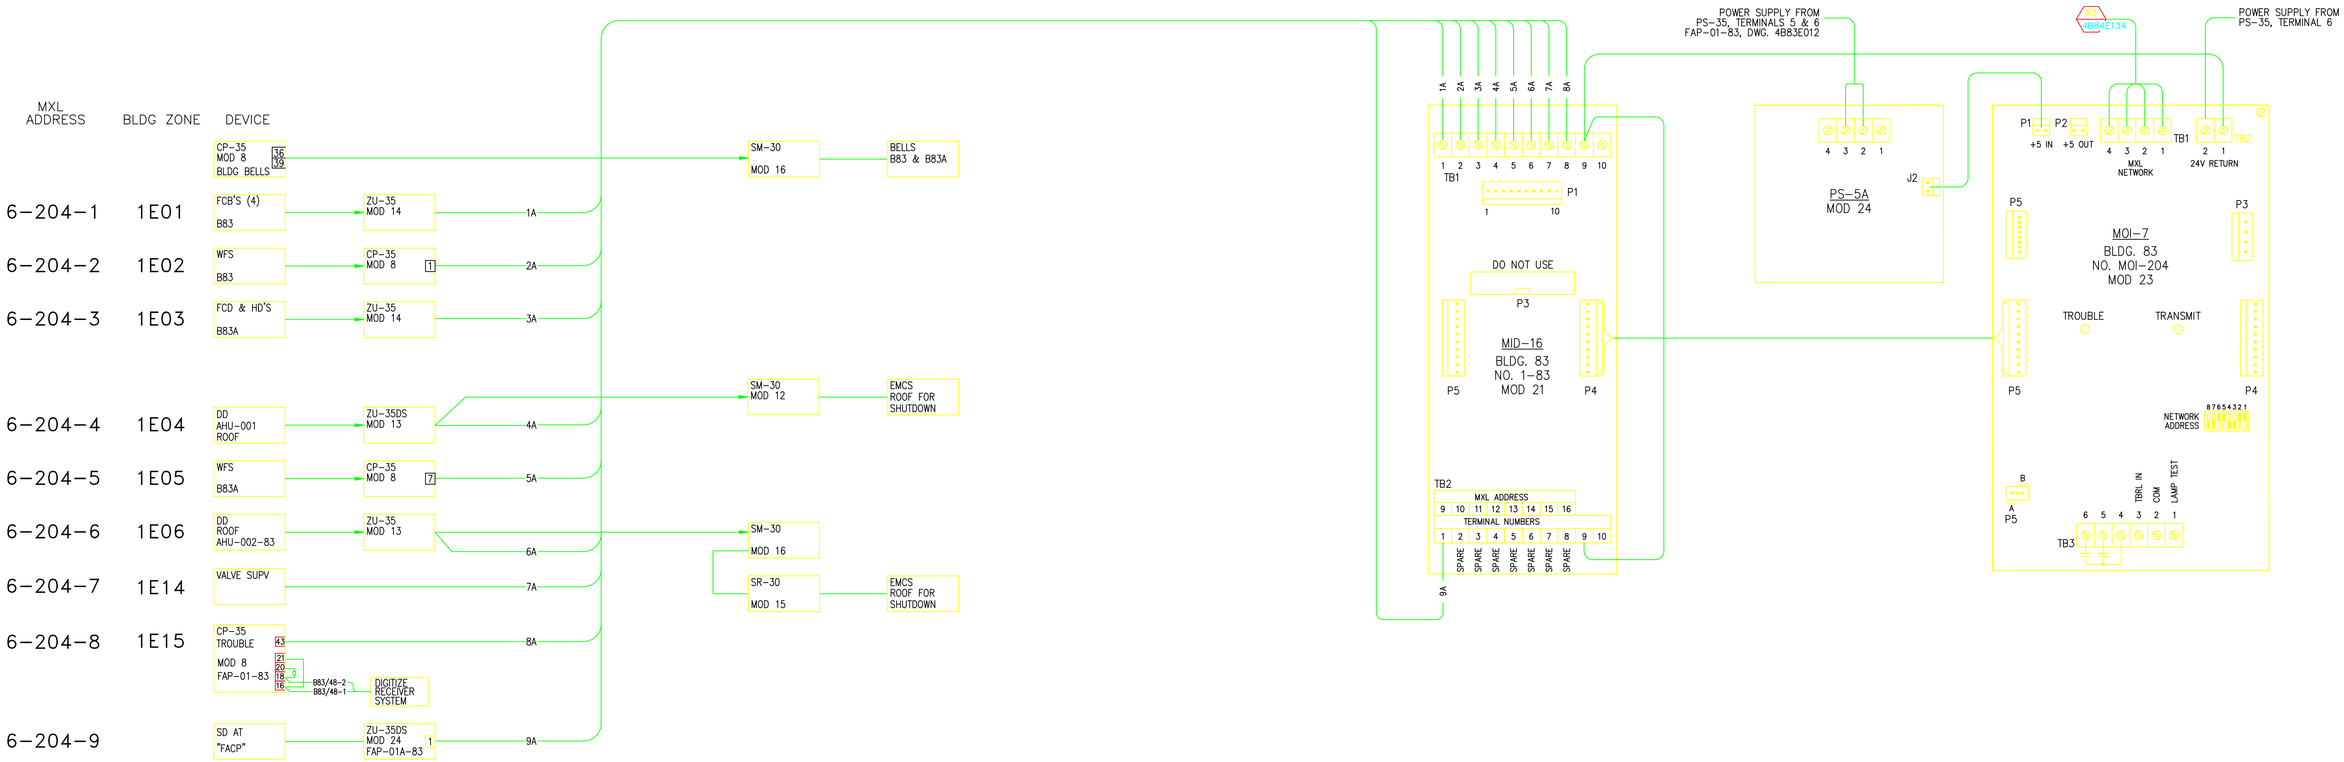

OLD ADDRESS	DESCRIPTION	MID-16 TERMINATION	MODULE TYPE & NO.	MXL NO. 6 AT B. 84 ADDRESS
1E01	FCB BLDG 83	TB. 1 NO. 1	MID-16 NO. 1-83	6-204-1
1E02	WFS BLDG 83	TB. 1 NO. 2	MID-16 NO. 1-83	6-204-2
1E03	FCB & HD'S BLDG 83A	TB. 1 NO. 3	MID-16 NO. 1-83	6-204-3
1E04	DSD AHU-001, ROOF	TB. 1 NO. 4	MID-16 NO. 1-83	6-204-4
1E05	WFS BLDG 83A	TB. 1 NO. 5	MID-16 NO. 1-83	6-204-5
1E06	DSD AHU-002, ROOF	TB. 1 NO. 6	MID-16 NO. 1-83	6-204-6
1E14	VALVE SUPERVISION	TB. 1 NO. 7	MID-16 NO. 1-83	6-204-7
1E15	SYSTEM 3 SUPERVISION	TB. 1 NO. 8	MID-16 NO. 1-83	6-204-8
N/A	SD AT "FACP"	TB. 2 NO. 1	MID-16 NO. 1-83	6-204-9
N/A	SPARE	TB. 2 NO. 2	N/A	N/A
N/A	SPARE	TB. 2 NO. 3	N/A	N/A
N/A	SPARE	TB. 2 NO. 4	N/A	N/A
N/A	SPARE	TB. 2 NO. 5	N/A	N/A
N/A	SPARE	TB. 2 NO. 6	N/A	N/A
N/A	SPARE	TB. 2 NO. 7	N/A	N/A
N/A	SPARE	TB. 2 NO. 8	N/A	N/A

AS BUILT

F
6/18/13

REVISION NUMBER	DRAWN BY	CHECKED BY	APPR'D BY	DATE	REMARKS
F	DSV	LDD	MCD	7/15/13	AS BUILT PER FIELD VERIFICATION
E	AD	–	–	10/26/07	ISSUED FOR REFERENCE ONLY
D	AD	LDD	MCD	10/08/07	FIRE ALARM SYSTEM UPGRADE
C	RZT	MCG	MCG	4/01/05	REVISED FOR DIGITIZE SYSTEM
B	AD	AD	MCG	01/10/04	AS-BUILT, PHASE II FA UPGRADE
A	AD	MCG	MCG	10/23/03	AS-BUILT, PHASE II FA UPGRADE

PROFESSIONAL SEAL (IF REVISION, APPLIES ONLY TO REVISED WORK)

ISSUE (PROGRESS, ESTIMATE, BID, CONSTRUCTION, CONFORMED, REVISION, RECORD)

83
REPLACEMENT FIRE ALARM SYSTEM
LOGIC AND FIELD CONNECTIVITY

UNIVERSITY OF CALIFORNIA
LAWRENCE BERKELEY NATIONAL LABORATORY
FACILITIES DIVISION

DRAWN BY HYT DATE 2/12/2003
CHECKED BY HYT 2/12/2003
APPROVED BY
CAD FILE PATH
SCALE As Noted
DRAWING NO. 4B83E036F
SHEET 1 OF 1
PROJECT NO. FA8040