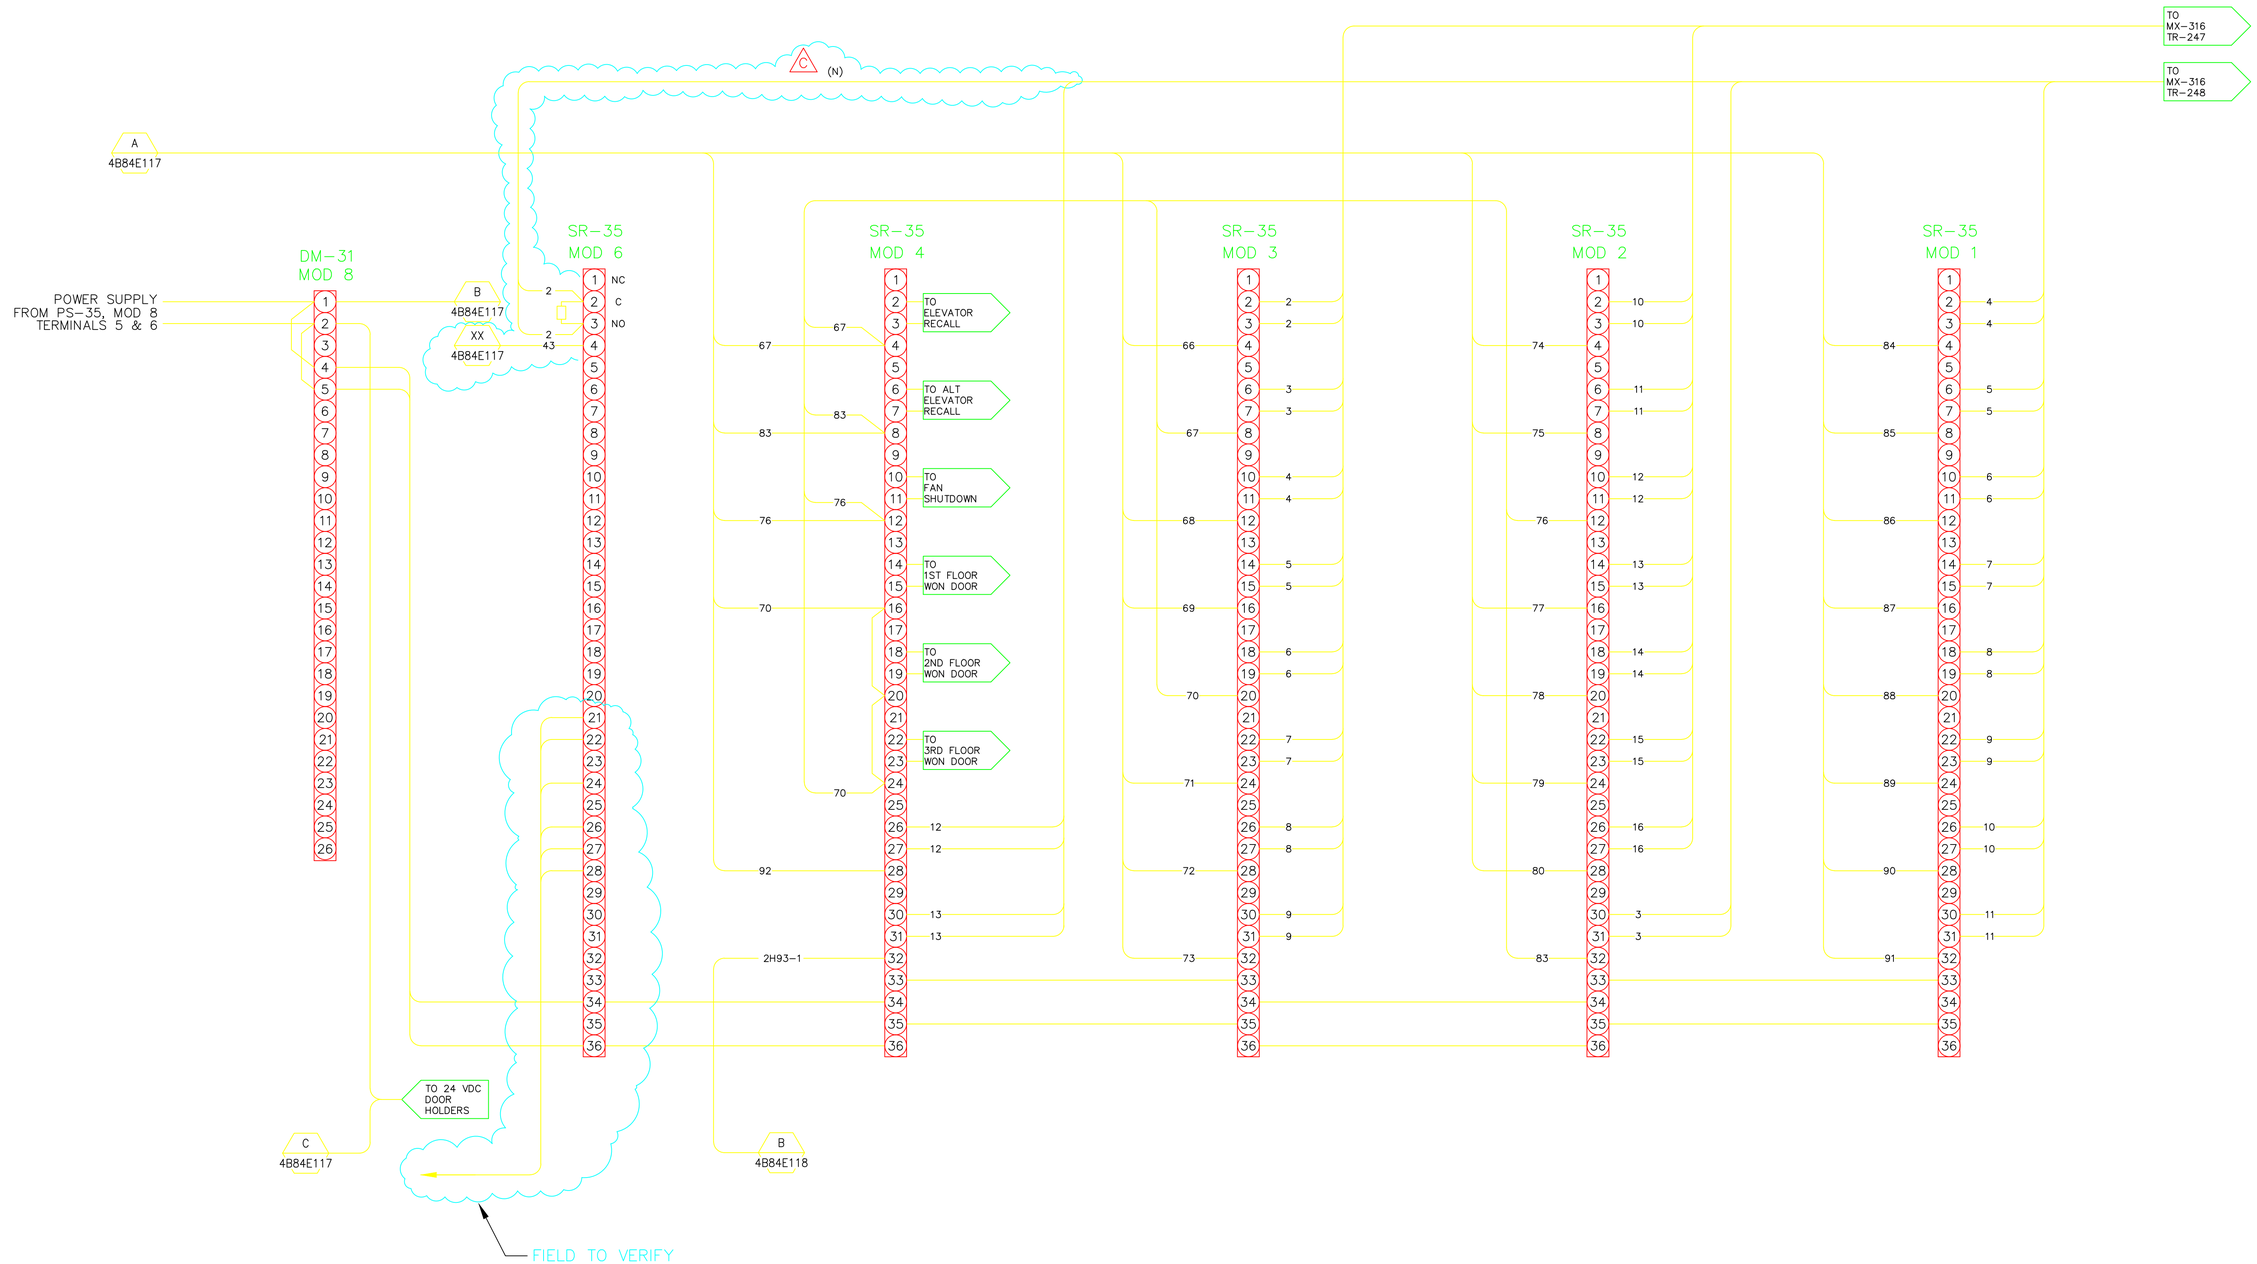

	C	RZT	MCG	MCG	4/15/05	REVISED FOR DIGITIZE SYSTEM.
	B	MRC	AD	MCG	3/15/03	PHASE II FIRE ALARM SYSTEM UPGRADE
	A	HYT	HYT	–	3/15/02	REPLACEMENT FIRE ALARM PROJECT REDRAWN ON AUTO CAD AS-BUILT
PROFESSIONAL SEAL (IF REVISION, APPLIES ONLY TO REVISED WORK)	ISSUE (PROGRESS, ESTIMATE, BID, CONSTRUCTION, CONFORMED, REVISION, AS-BUILT)	REVISION NUMBER	DRAWN BY	CHECKED BY	APPR'D BY	DATE	REMARKS

TITLE 2
CONSTRUCTION
C
4/15/2005

84 FIRE ALARM
SYS 3 PNL FAP-002-84
DM-31&SR-35 INTERCONN DIAG

UNIVERSITY OF CALIFORNIA
LAWRENCE BERKELEY NATIONAL LABORATORY
FACILITIES DEPARTMENT

DRAWN BY	LDD	DATE 3/6/2002
CHECKED BY	MCG	3/6/2002
APPROVED BY	MCG	3/8/2002
CAD FILE PATH	00019268	
SCALE	As Noted	
DRAWING NO.	4B84E119C	SHEET 1 OF 1
PROJECT NO.	WG0721	