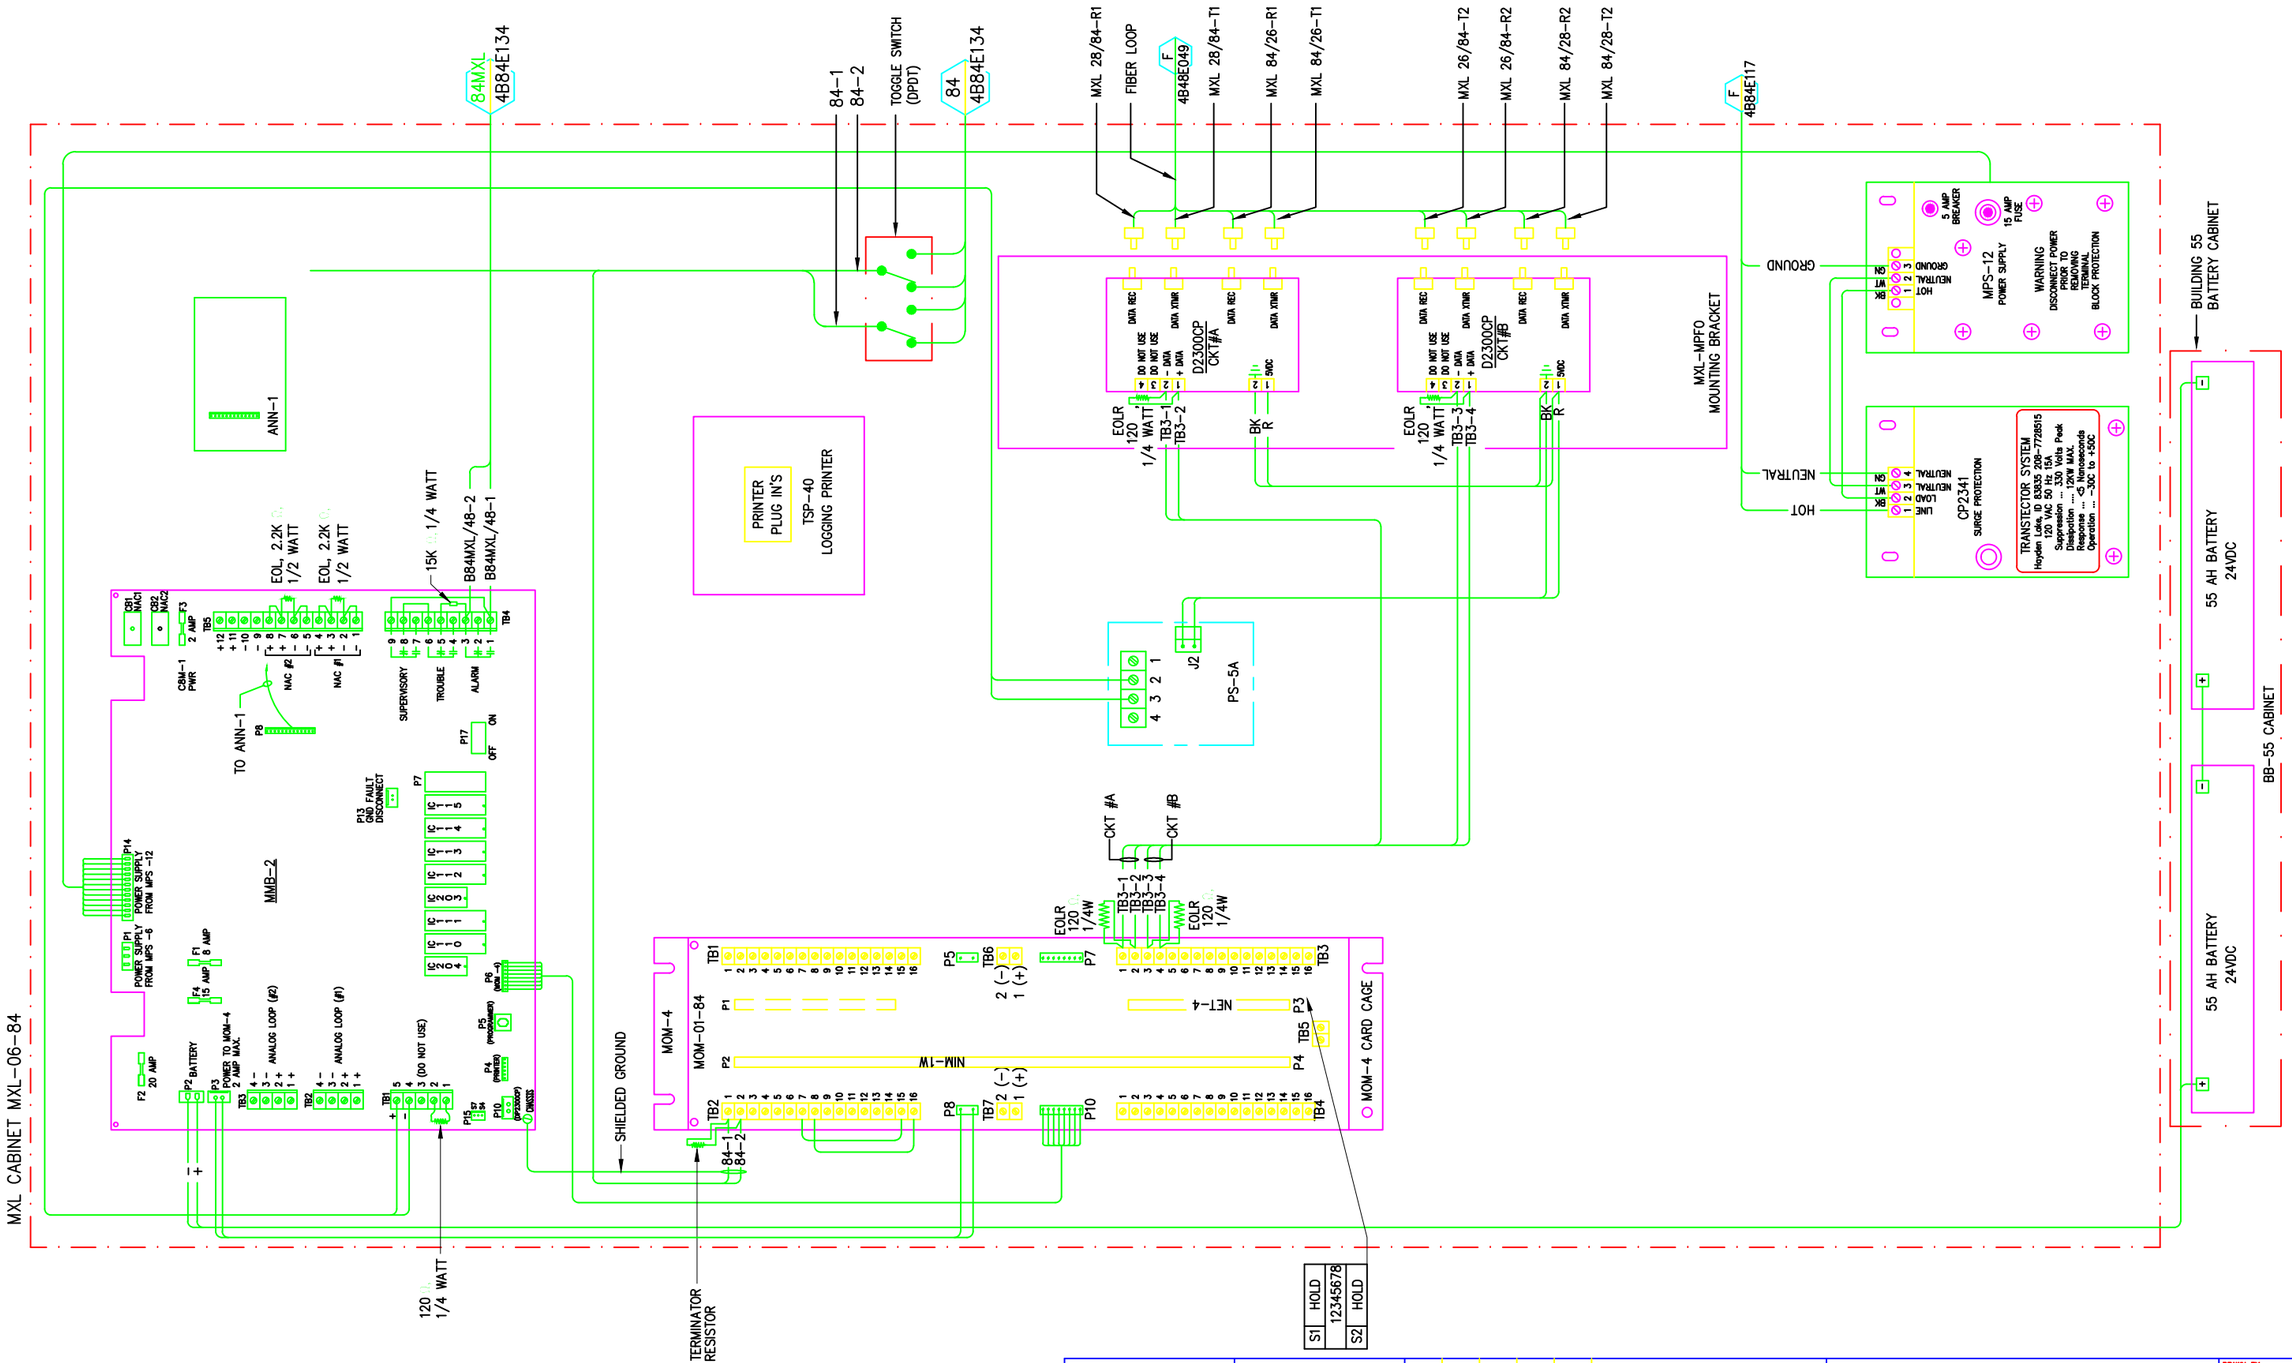

MXL ARRANGEMENT

SCALE: NONE

REVISION NUMBER	DRAWN BY	CHECKED BY	APPR'D BY	DATE	REMARKS
F	DSV	LDD	MCD	6/18/13	AS BUILT PER FIELD VERIFICATION
E	AD	LDD	MCD	02/12/07	AS-BUILT RECORD DRAWING PER CLIENT COMMENTS
D	AD	LDD	MCD	06/06/06	REVISED FOR MXL COPPER LOOP
C	AD	MCG	MCG	12/05/05	REVISED PER SIEMENS REVIEW
B	AD	MCG	MCG	04/01/05	ADDED FIBER AND COPPER LOOP
A	VDA	MCG	MCG	03/30/04	REVISE BLDG 28 FA SYSTEM TO BLDG 26 FAP-01-26 PNL

PROFESSIONAL SEAL (IF REVISION, APPLIES ONLY TO REVISED WORK)

ISSUE (PROGRESS, ESTIMATE, BID, CONSTRUCTION, CONFORMED, REVISION, RECORD)

ASBUILT

F

6/18/13

84 FIRE ALARM

MXL FIRE ALARM SYSTEM

MXL #6 FAP ARRANGEMENT/WIRING DIAG

UNIVERSITY OF CALIFORNIA
LAWRENCE BERKELEY NATIONAL LABORATORY
FACILITIES DIVISION

DRAWN BY HYT DATE 5/28/2002
CHECKED BY HYT 5/28/2002
APPROVED BY
CAD FILE PATH
SCALE As Noted
DRAWING NO. 4B84E126F
SHEET 1 OF 1
PROJECT NO. FE5200