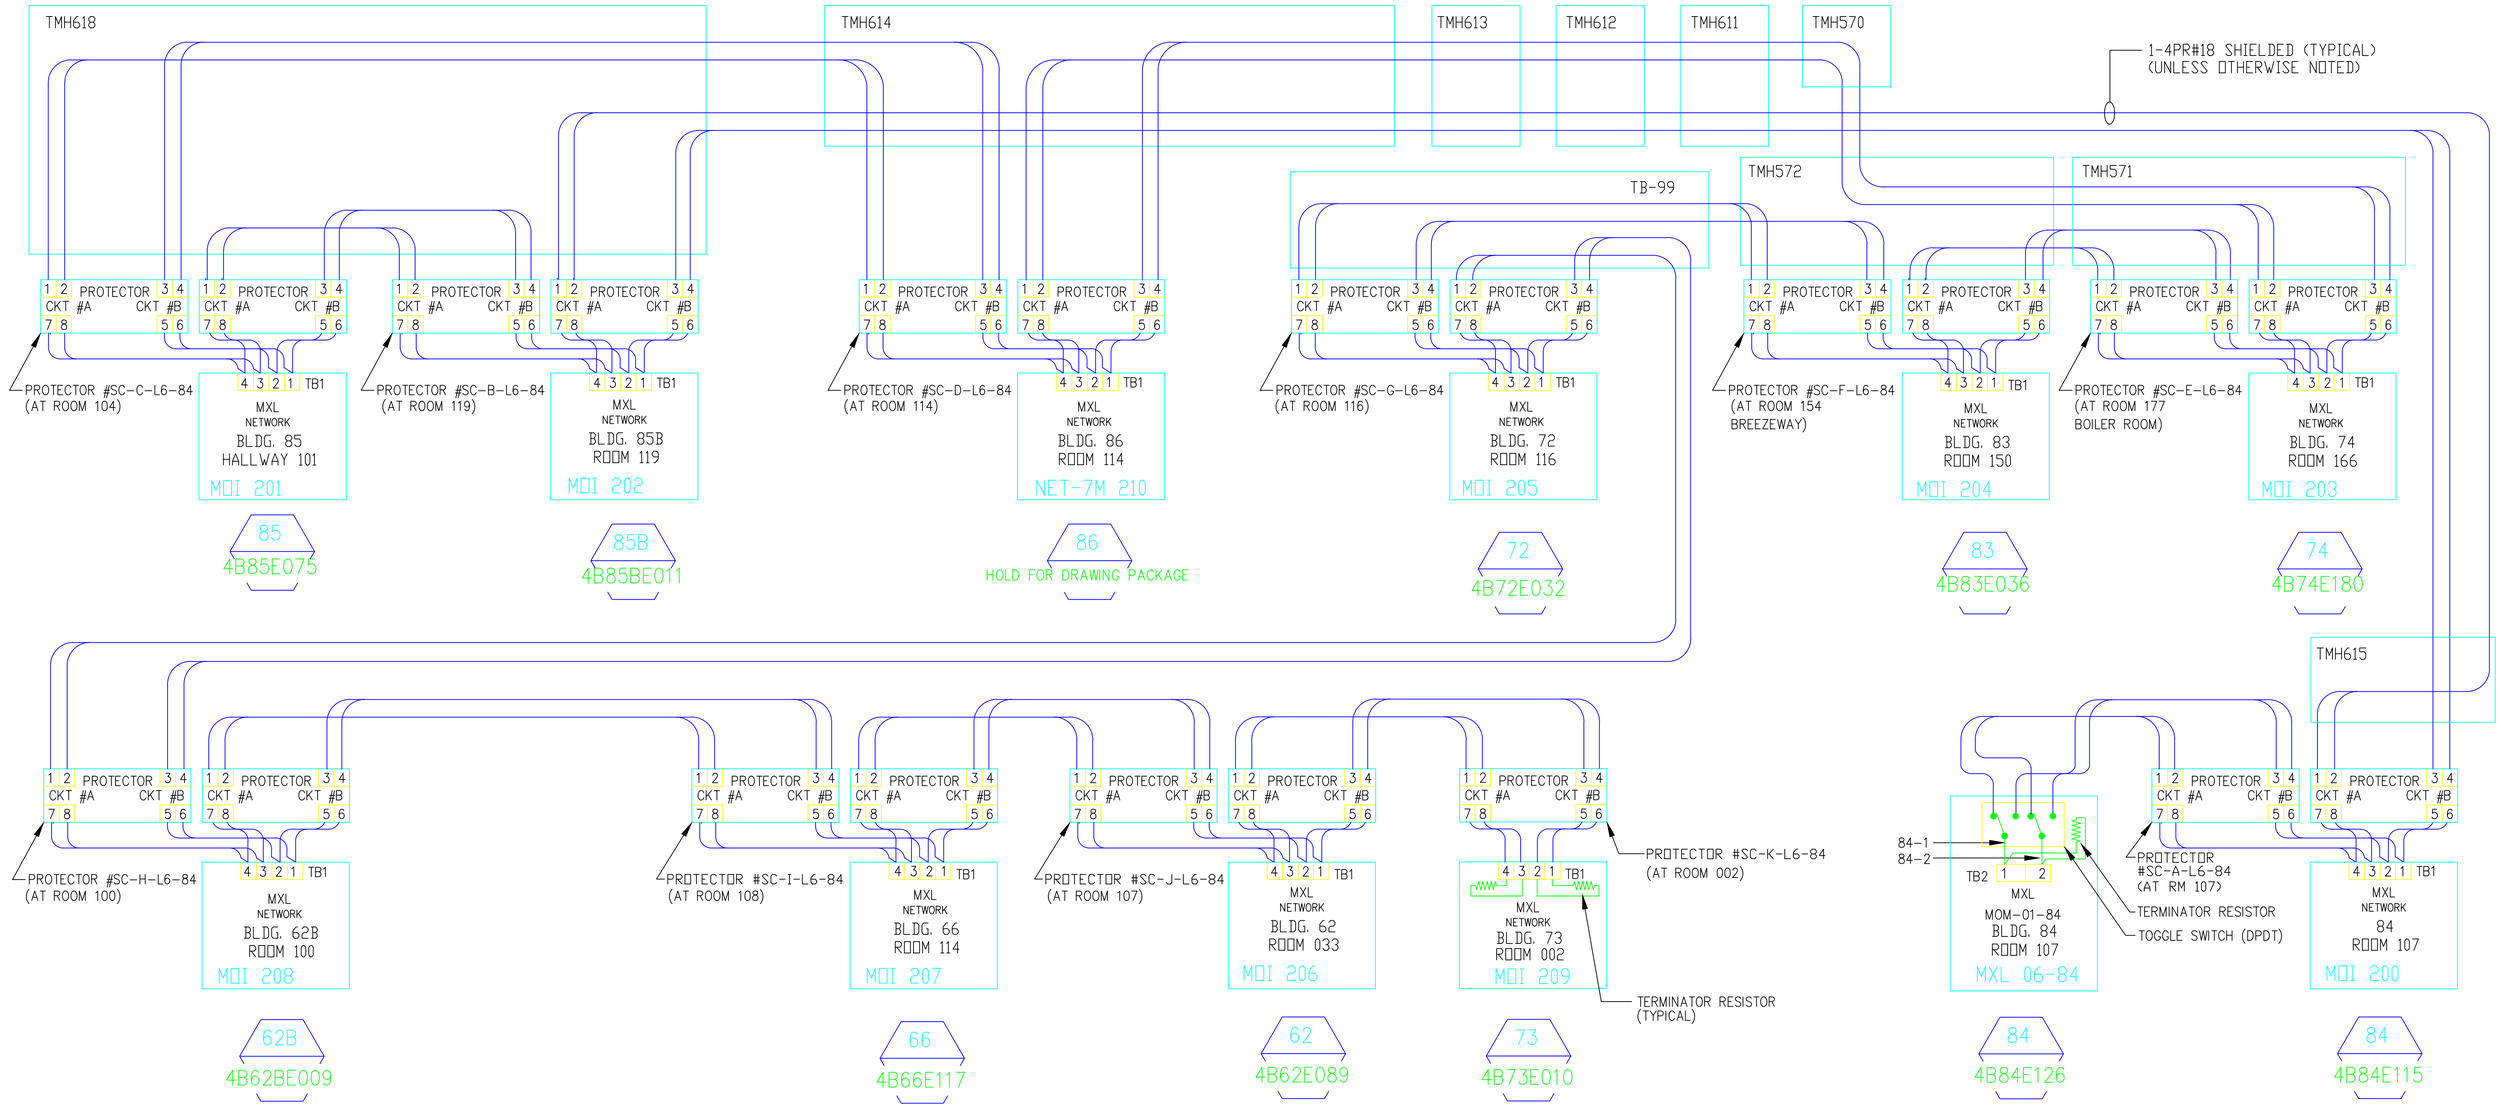

NOTES:

1. "T' TAPPING IS NOT ALLOWED.
2. GROUND ALL SHIELDS AT THE "MXL" ONLY.
3. GROUND ALL TERMINAL CABINETS.
4. GROUND ALL TERMINAL CABINETS AND DIN RAILS FOR PROTECTORS.
5. SHORT ALL UNUSED PAIRS AT EACH TERMINAL CABINET.

TITLE 2
CONSTRUCTION
A
10/16/2007

REVISION NUMBER	DRAWN BY	CHECKED BY	APPR'D BY	DATE	REMARKS
A	AD	LDD	MCD	10/16/07	AS-BUILT RECORD DRAWING

PROFESSIONAL SEAL (IF REVISION, APPLIES ONLY TO REVISED WORK)

ISSUE (PROGRESS, ESTIMATE, BID, CONSTRUCTION, CONFORMED, REVISION, RECORD)

84 COPPER LOOP
MXL/MOI COPPER LOOP NO. 6
NETWORK BLOCK DIAGRAM

UNIVERSITY OF CALIFORNIA
LAWRENCE BERKELEY NATIONAL LABORATORY
FACILITIES DIVISION

		DATE
DRAWN BY	AD	1/3/2006
CHECKED BY	AD	1/3/2006
APPROVED BY	LDD	1/3/2006
CAD FILE PATH	00022748	
SCALE	Full	

DRAWING NO. 4B84E134A
SHEET 1 OF 1
PROJECT NO. FR1015