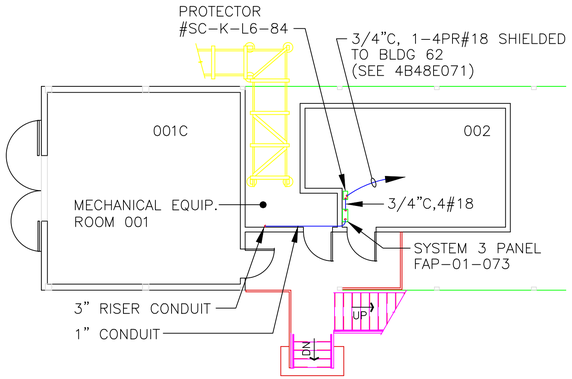

BUILDING 73 PARTIAL PLAN

SCALE: 1/8" =1'-0"

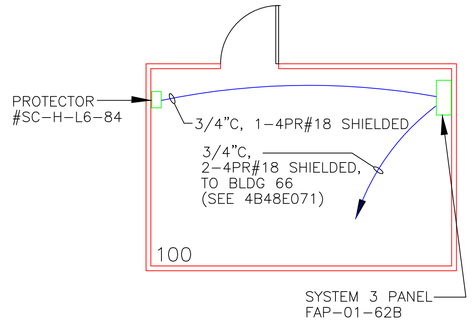

BUILDING 62B PARTIAL PLAN

SCALE: 1/4" =1'-0"

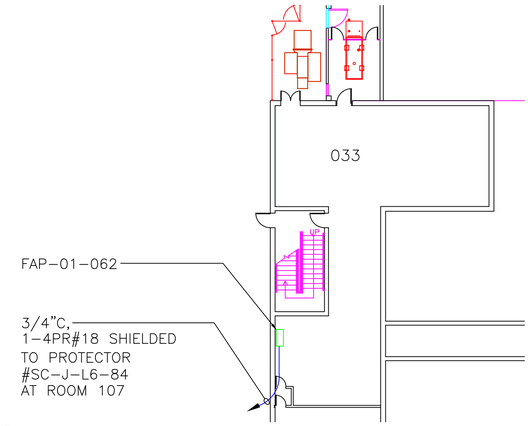

BUILDING 62 PARTIAL PLAN

SCALE: 1/16" =1'-0"

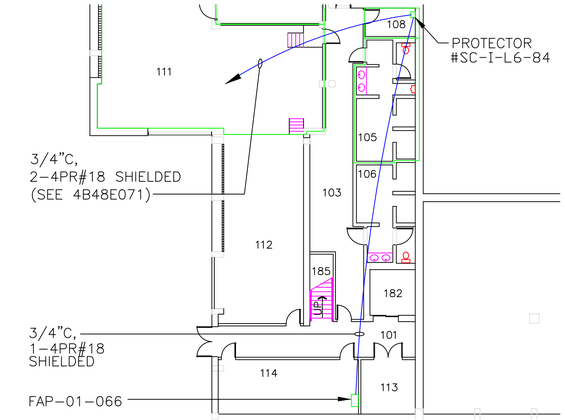

BUILDING 66 PARTIAL PLAN

SCALE: 1/16" =1'-0"

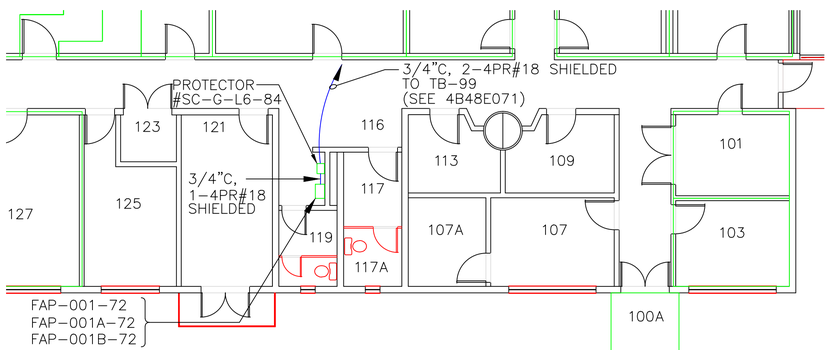

BUILDING 72 PARTIAL PLAN

SCALE: 1/8" =1'-0"

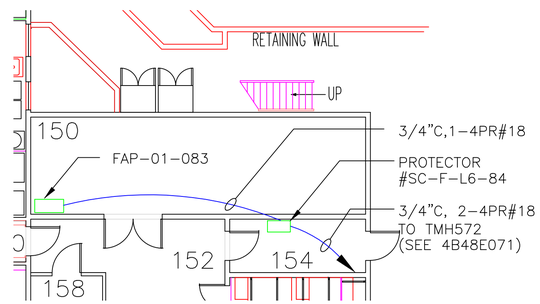

BUILDING 83 PARTIAL PLAN

SCALE: 1/8" =1'-0"

HOLD

BUILDING 86 PARTIAL PLAN

(HOLD FOR ARCHITECTURAL PLANS)

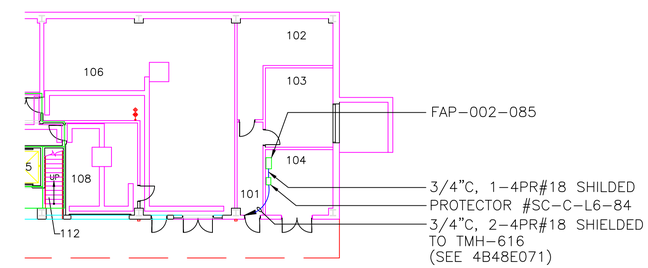

BUILDING 85 PARTIAL PLAN

SCALE: 1/16" =1'-0"

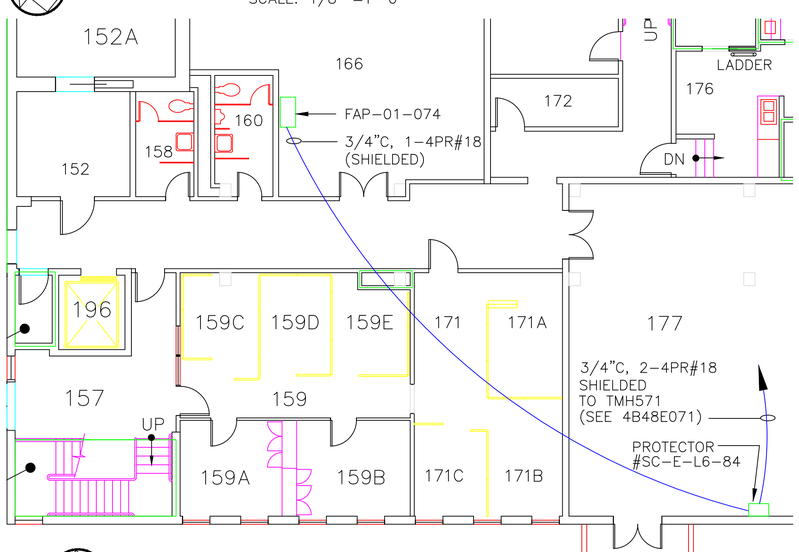

BUILDING 74 PARTIAL PLAN

SCALE: 1/8" =1'-0"

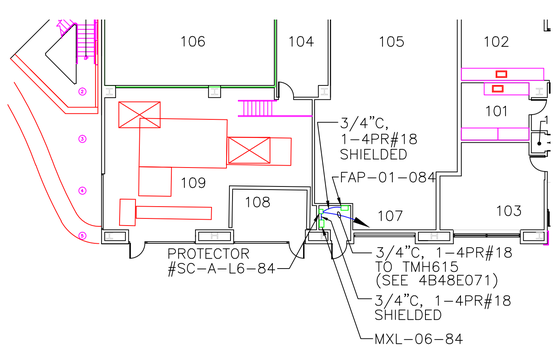

BUILDING 84 PARTIAL PLAN

SCALE: 1/16" =1'-0"

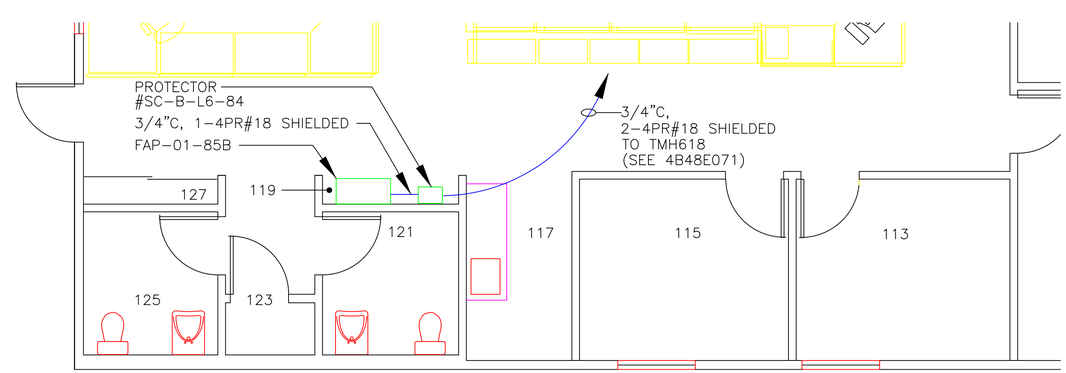

BUILDING 85B PARTIAL PLAN

SCALE: 1/4" =1'-0"

PROFESSIONAL SEAL (IF REVISION, APPLIES ONLY TO REVISED WORK)	ISSUE (PROGRESS, ESTIMATE, BID, CONSTRUCTION, CONFORMED, REVISION, RECORD)	REVISION NUMBER	DRAWN BY	CHECKED BY	APPR'D BY	DATE	REMARKS
	ASBUILT REVISION A 10/19/2007	A	AD	LDD	MCD	10/19/2007	AS-BUILT RECORD DRAWING

84 FIRE ALARM

MXL/MOI COPPER LOOP NO. 6

PLAN DRAWINGS

UNIVERSITY OF CALIFORNIA
LAWRENCE BERKELEY NATIONAL LABORATORY
FACILITIES DIVISION

		DATE
DRAWN BY	AD	3/21/2006
CHECKED BY	AD	3/21/2006
APPROVED BY	LDD	3/21/2006
CAD FILE PATH	00022755	
SCALE	As Noted	
DRAWING NO.	4B84E135A	SHEET 1 OF 1
PROJECT NO.	FR1015	