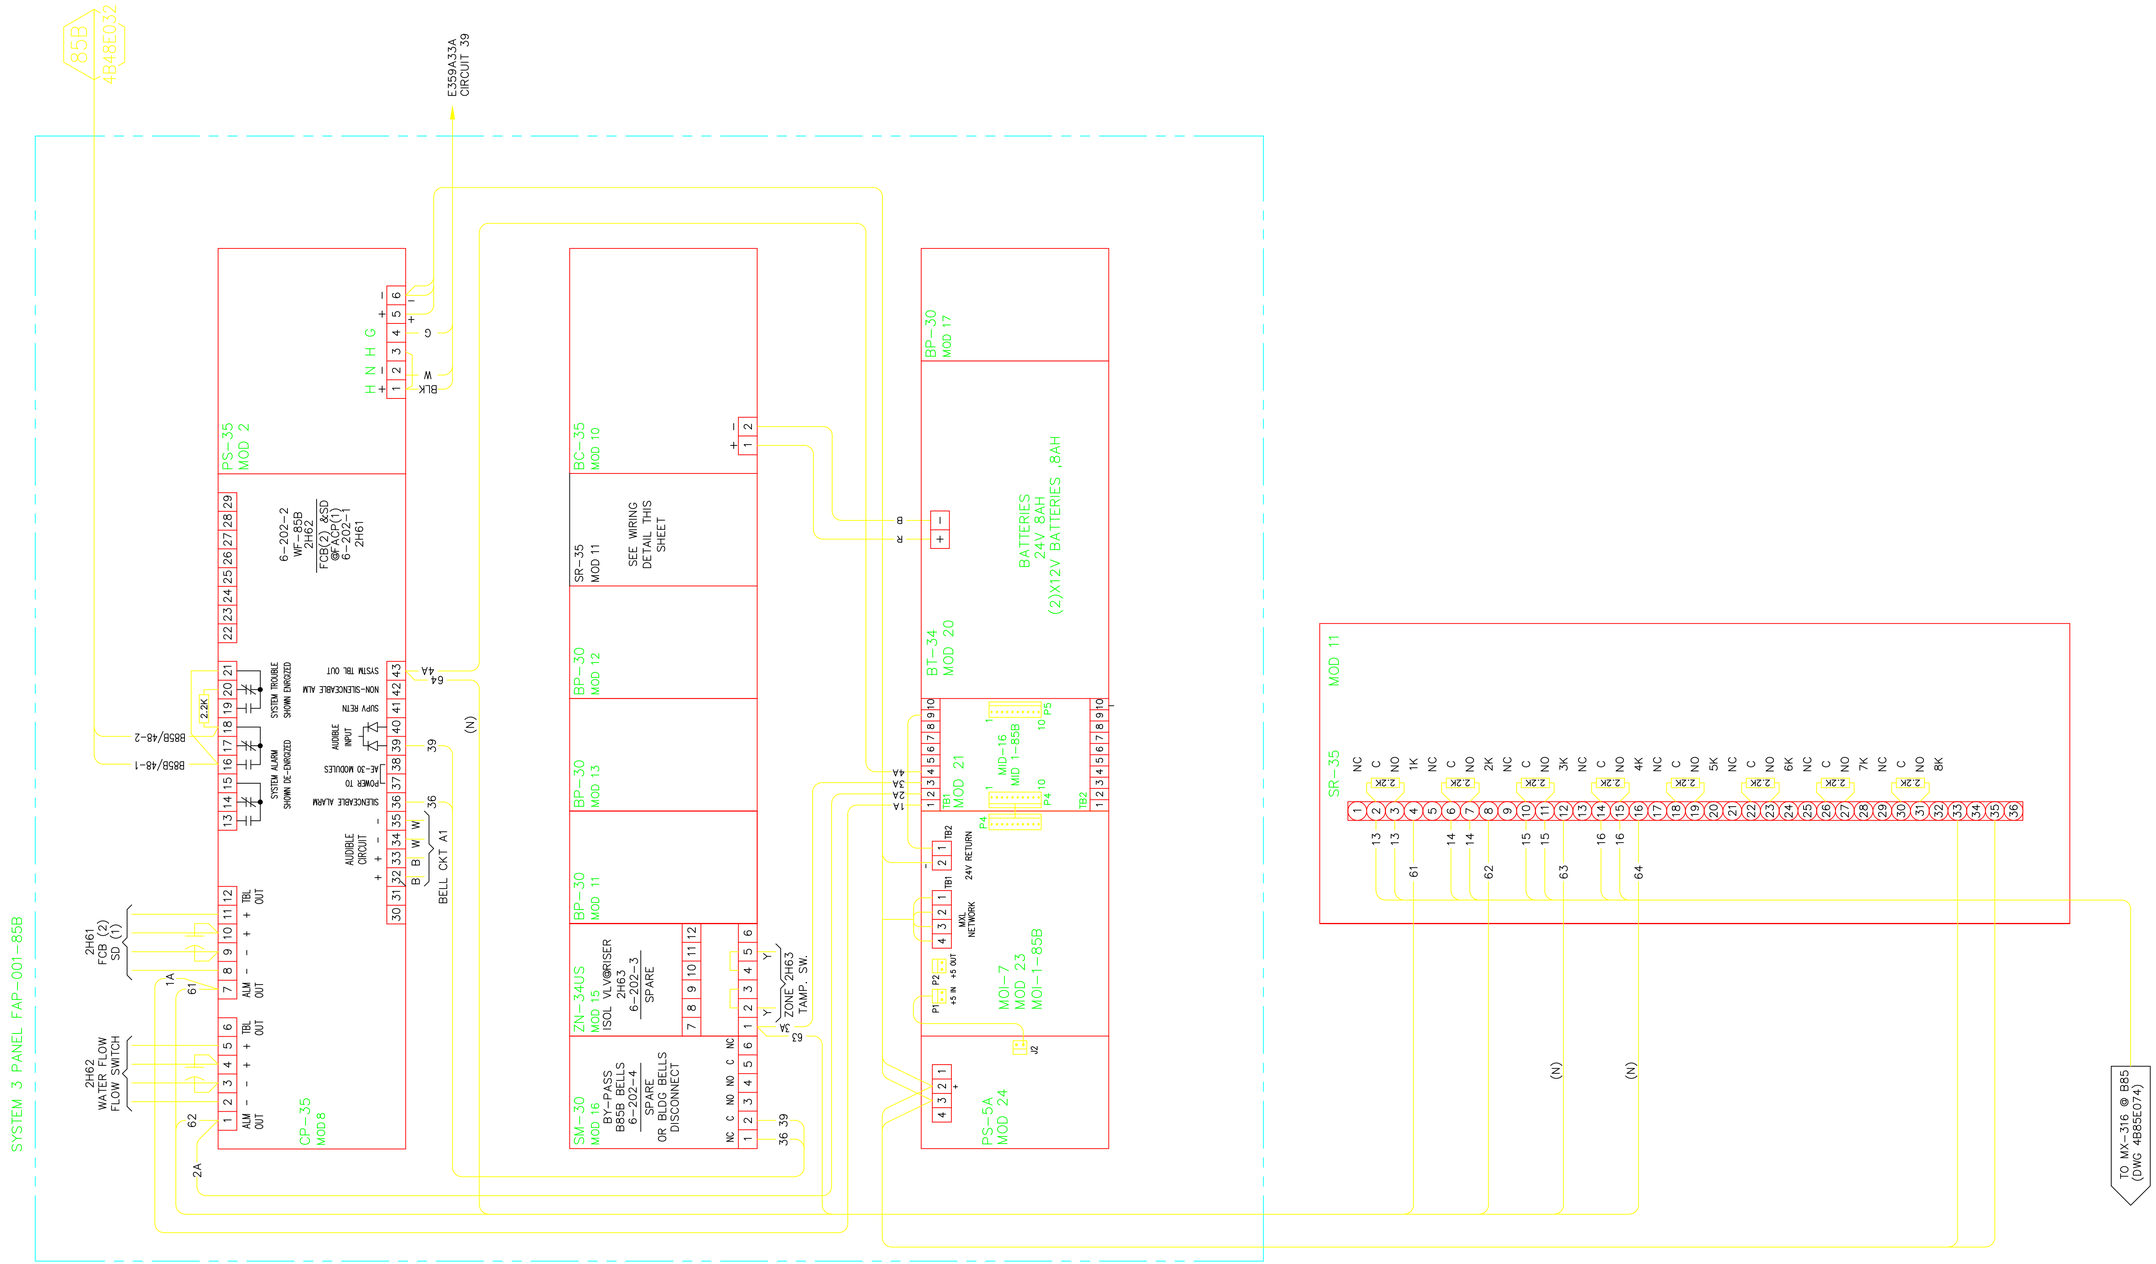

REFERENCE DRAWINGS

4B85E074 ZONE LOGIC DIAGRAM
4B85BE011 MOI/MID MODULE ARRANGEMENT

	AS BUILT						
	C	C	DSV	LDD	MCD	6/20/13	AS BUILT PER FIELD VERIFICATION
	6/20/13	B	RZT	MCG	MCG	3/29/05	REVISED AND ADDED DIGITIZE ALARM.
		A	AD	AD	MCG	10/14/03	AS-BUILT, PHASE II FA UPGRADE
PROFESSIONAL SEAL (IF REVISION, APPLIES ONLY TO REVISED WORK)	ISSUE (PROGRESS, ESTIMATE, BID, CONSTRUCTION, CONFORMED, REVISION, RECORD)	REVISION NUMBER	DRAWN BY	CHECKED BY	APPR'D BY	DATE	REMARKS

85B FIRE ALARM
SYSTEM 3 PANEL FAP-001-85B
INTERCONNECTION DIAGRAM

UNIVERSITY OF CALIFORNIA
LAWRENCE BERKELEY NATIONAL LABORATORY
FACILITIES DIVISION

DRAWN BY	AD	DATE 11/2/2000
CHECKED BY	MCG	11/2/2000
APPROVED BY	MCG	11/2/2000
CAD FILE PATH		
SCALE	Full	
DRAWING NO.	4B85BE005C	SHEET 1 OF 1
PROJECT NO.	FA8040	