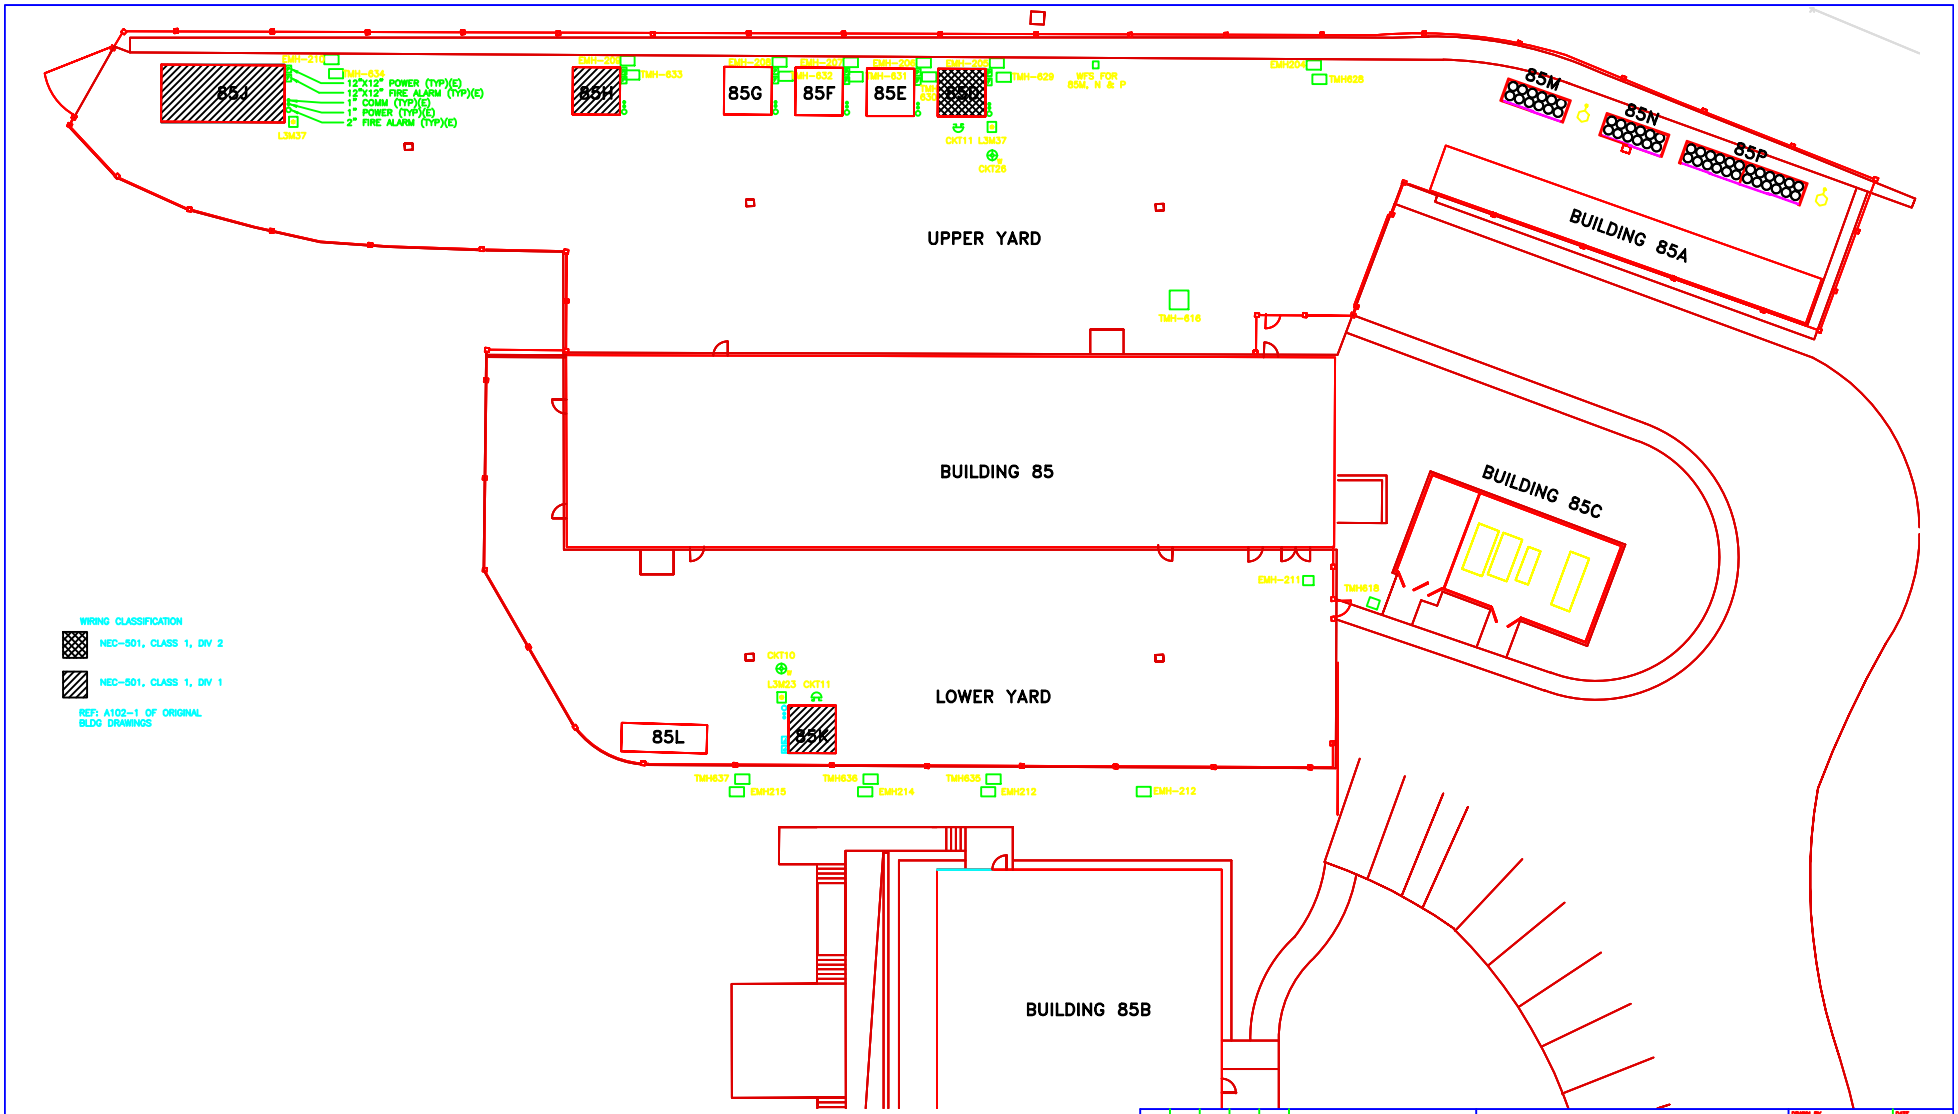


| REVISION NUMBER | DRAWN BY | CHECKED BY | APPR'D BY | DATE | REMARKS |
|---|---|---|---|---|---|
| C | ROB | MCG | MCG | 03/17/98 | AS-BUILT |
| B | ROB | MCG | MCG | 8/7/96 | ADD 85M, N & P CONTAINERS |
| A | ROB | MCG | MCG | 6/15/97 | AS-BUILT |

85
STORAGE CONTAINERS
ELECTRICAL SITE PLAN

UNIVERSITY OF CALIFORNIA LAWRENCE BERKELEY LABORATORY
FACILITIES DEPARTMENT

| | | |
|---|---|---|
| DRAWN BY | ROB | DATE 04/15/97 |
| CHECKED BY | MCG | 04/15/97 |
| APPROVED BY | MCG | 04/15/97 |
| CAD FILE PATH | 00010531 | |
| SCALE | As Noted | |
| DRAWING NO. | 4B85E009C | SHEET E1 1 OF 1 |
| PROJECT NO. | FX9026 | |