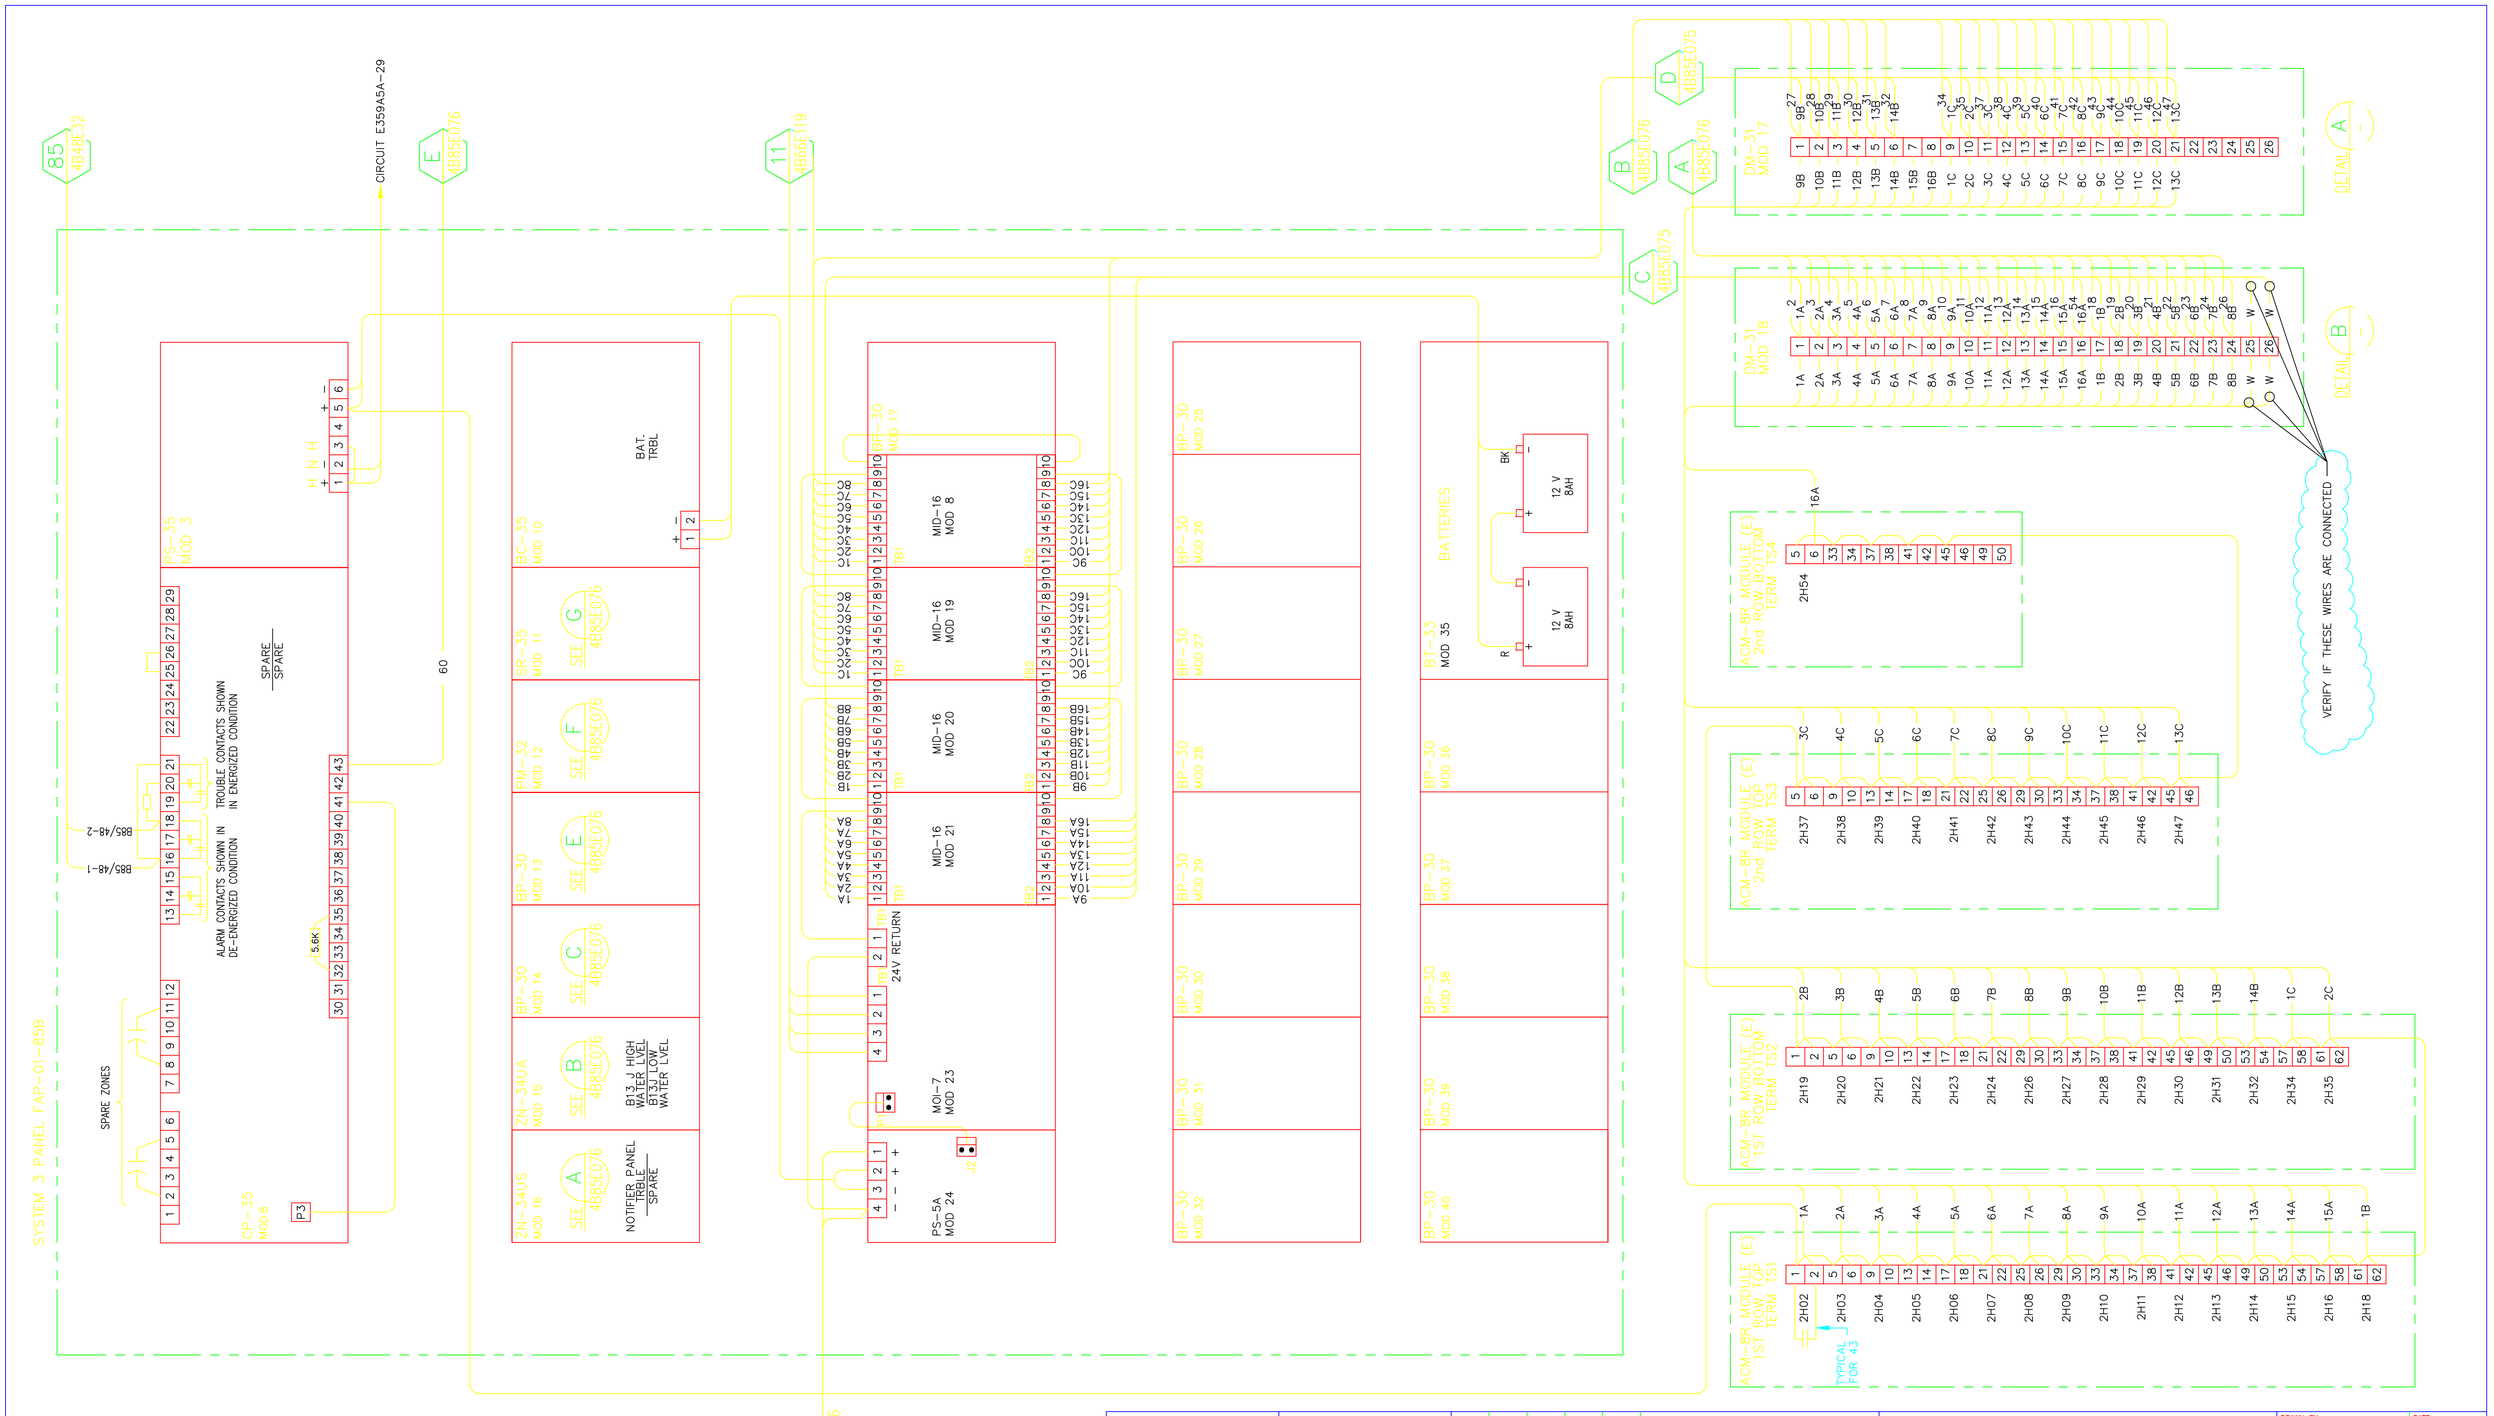

AS BUILT

D
6-20-13

REVISION NUMBER	DRAWN BY	CHECKED BY	APPR'D BY	DATE	REMARKS
D	DSV	LDD	MCD	6/20/13	AS BUILT PER FIELD VERIFICATION
C	RZT	MCG	MCG	3/28/05	ADDED ALARM FOR DIGITIZER RECEIVER.
B	AD	AD	MCG	10/13/03	AS-BUILT, PHASE II FA UPGRADE
A	HYT	HYT	–	3/15/02	REPLACEMENT FIRE ALARM PROJECT REDRAWN ON AUTO CAD AS-BUILT

PROFESSIONAL SEAL (IF REVISION, APPLIES ONLY TO REVISED WORK)

ISSUE (PROGRESS, ESTIMATE, BID, CONSTRUCTION, CONFORMED, REVISION, RECORD)

85 FIRE ALARM

SYSTEM 3 PANEL
INTERCONNECTION DIAGRAM

UNIVERSITY OF CALIFORNIA
LAWRENCE BERKELEY NATIONAL LABORATORY
FACILITIES DIVISION

DRAWN BY	HYT	DATE 3/20/2002
CHECKED BY	HYT	3/20/2002
APPROVED BY		
CAD FILE PATH		
SCALE	As Noted	
DRAWING NO.	4B85E072D	SHEET 1 OF 1
PROJECT NO.	FA8040	