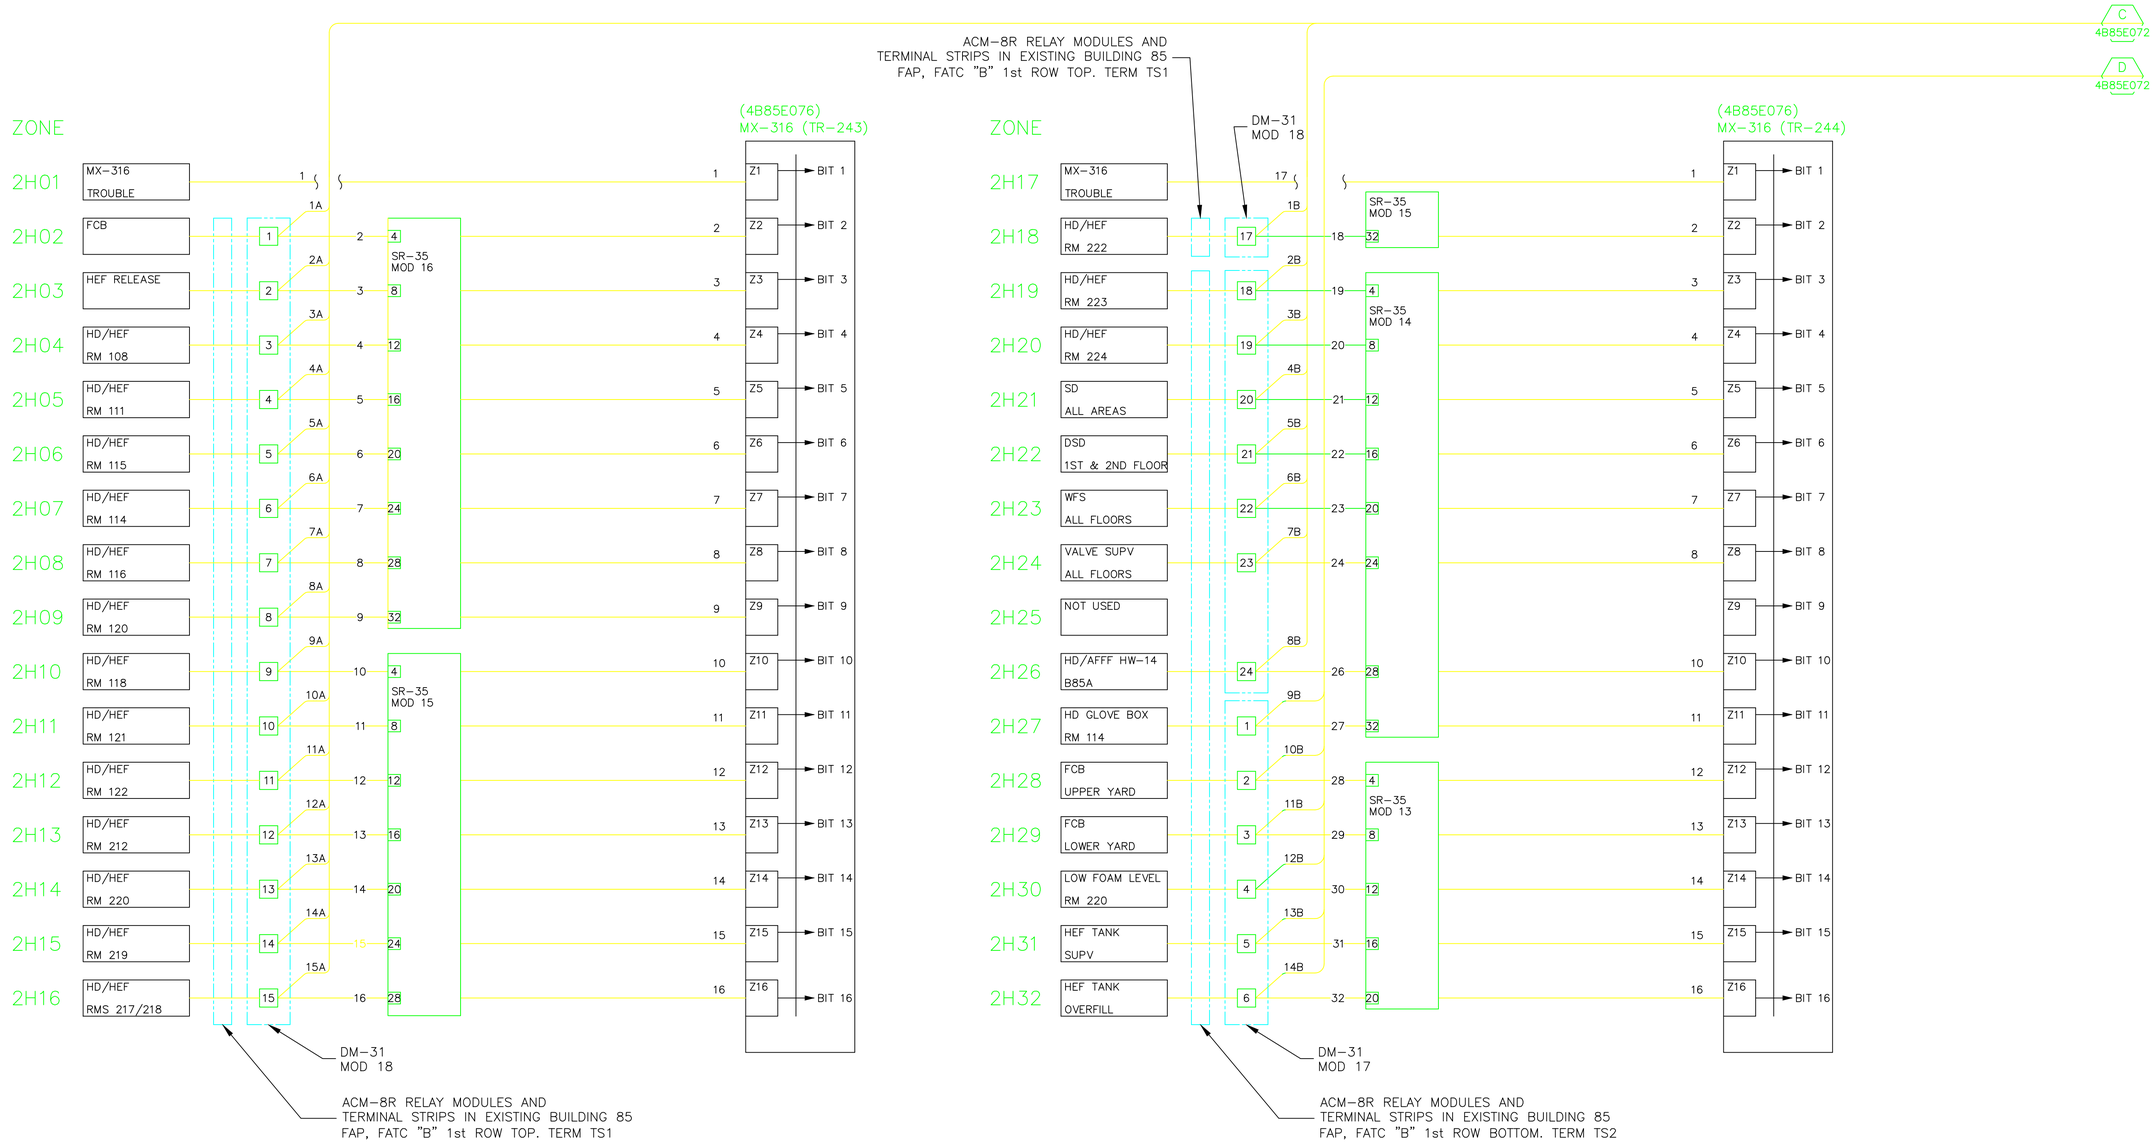

PROFESSIONAL SEAL (IF REVISION, APPLIES ONLY TO REVISED WORK)	ISSUE (PROGRESS, ESTIMATE, BID, CONSTRUCTION, CONFORMED), REVISION, RECORD)	REVISION NUMBER	DRAWN BY	CHECKED BY	APPR'D BY	DATE	REMARKS
	ASBUILT REVISION A 10/13/2003		AD	MCG	MCG	10/13/03	AS-BUILT, PHASE II FA UPGRADE

85 FIRE ALARM SYSTEM
REPLACEMENT FIRE ALARM SYSTEM
LOGIC DIAGRAM

UNIVERSITY OF CALIFORNIA
LAWRENCE BERKELEY NATIONAL LABORATORY
FACILITIES DIVISION

DRAWN BY HYT	DATE 3/20/2002
CHECKED BY HYT	3/20/2002
APPROVED BY	
CAD FILE PATH 00016649	
SCALE As Noted	
DRAWING NO. 4B85E073A	SHEET 1 OF 1
PROJECT NO. FA8040	