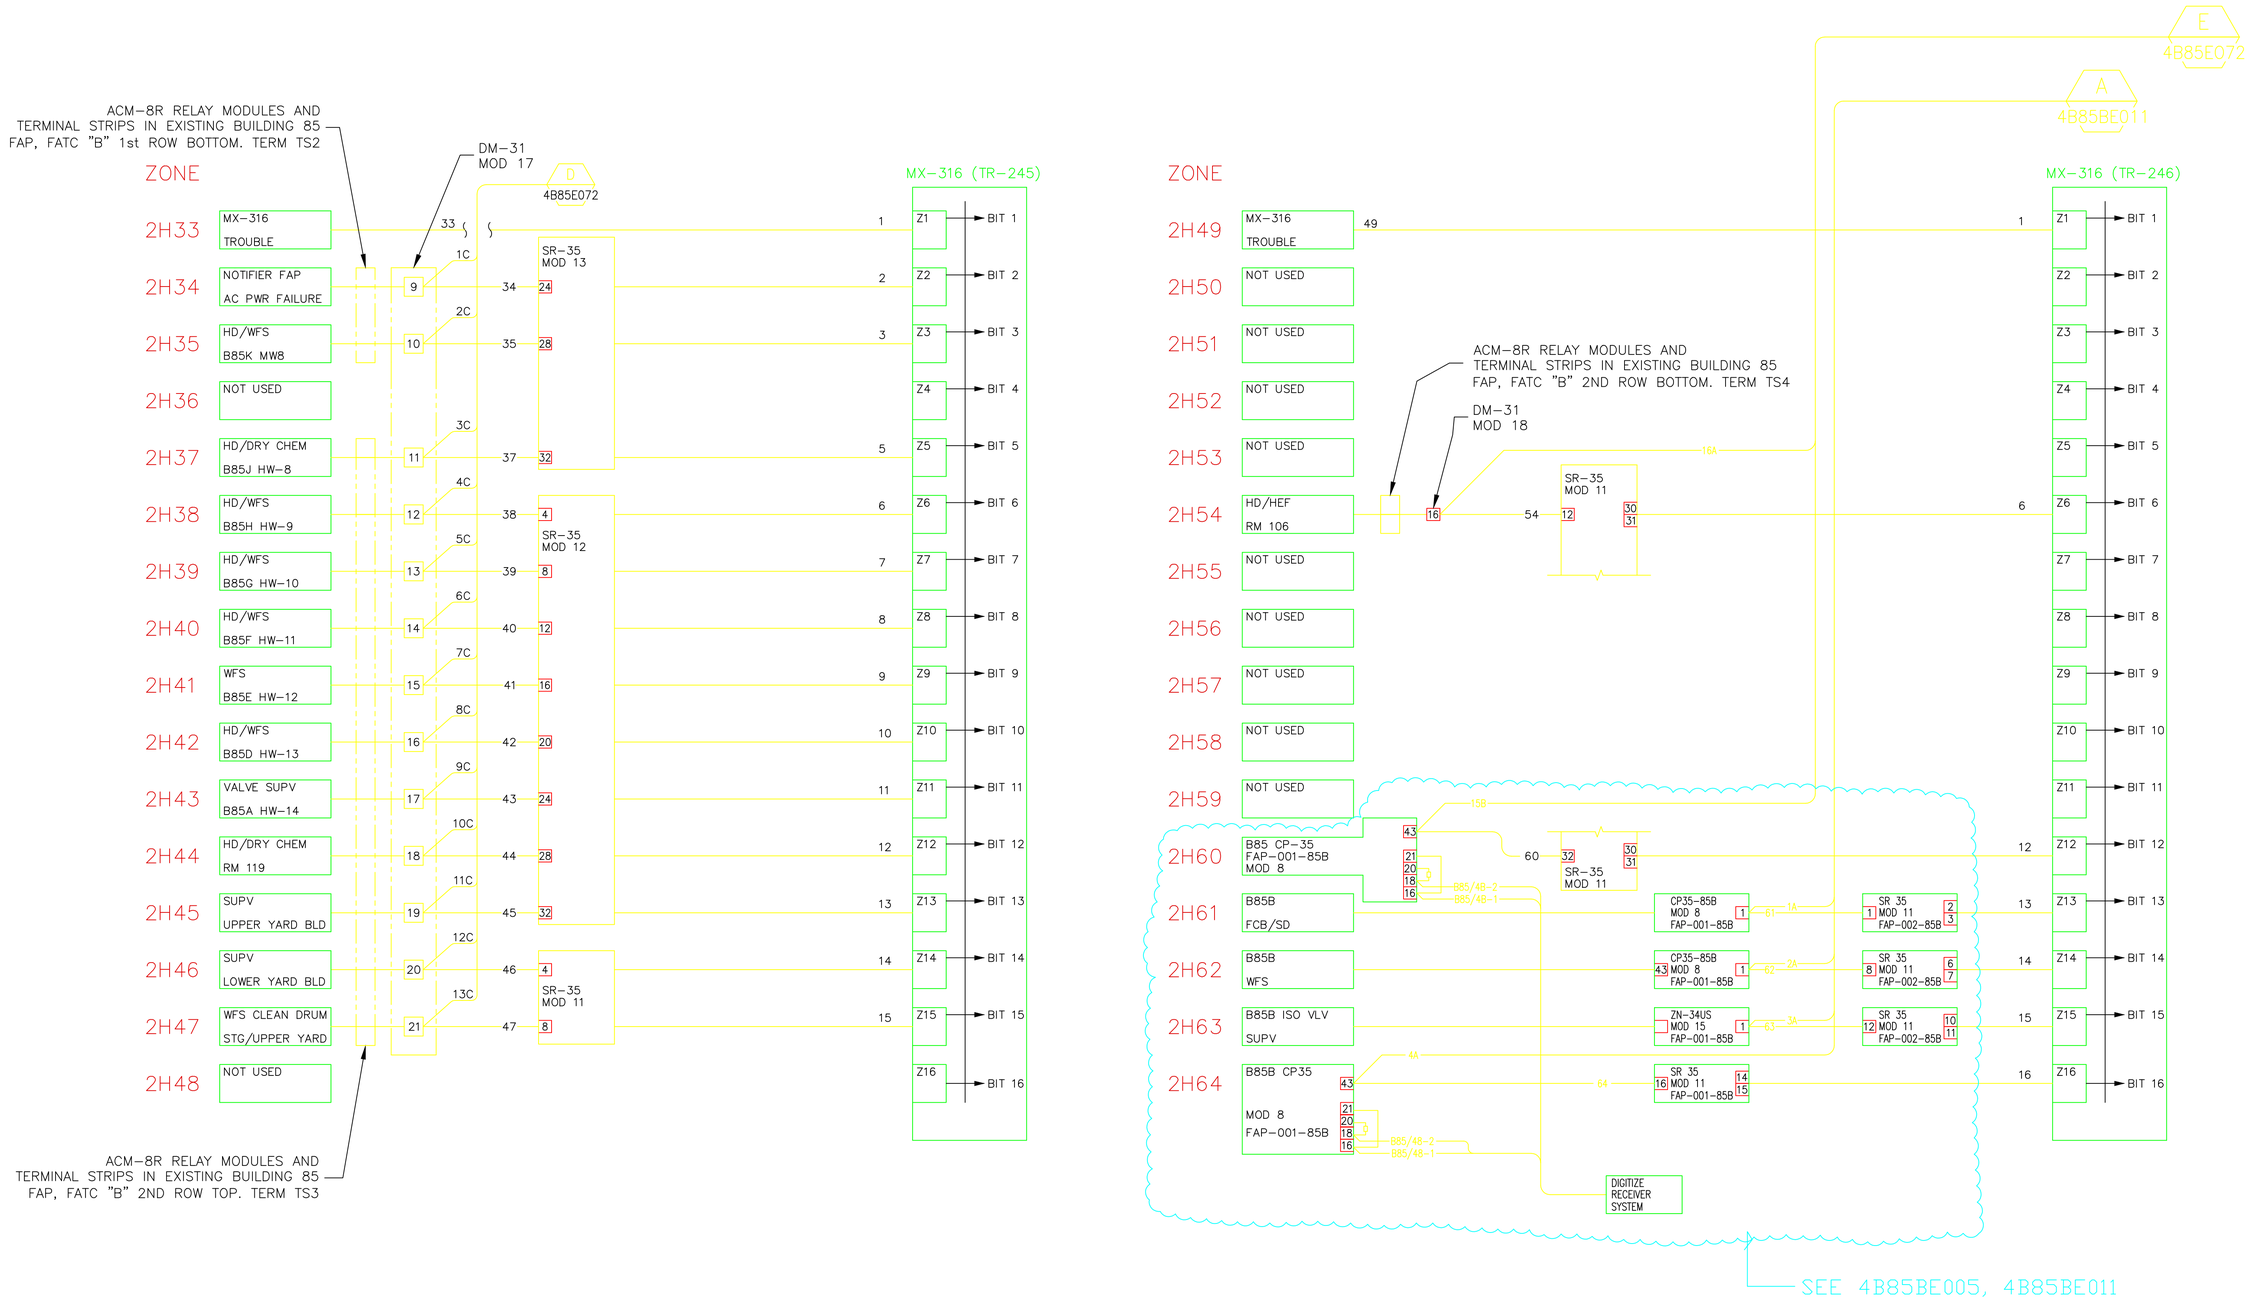

C	LDD	LDD	MCD	10/23/13	AS-BUILT PER FIELD VERIFICATIONS
B	RZT	MCG	MCG	3/28/05	GEN. REVISION FOR DIGITIZE SYSTEM.
A	AD	AD	MCG	10/13/03	AS-BUILT, PHASE II FA UPGRADE
REVISION NUMBER	DRAWN BY	CHECKED BY	APPR'D BY	DATE	REMARKS

PROFESSIONAL SEAL (IF REVISION, APPLIES ONLY TO REVISED WORK)

ISSUE (PROGRESS, ESTIMATE, BID, CONSTRUCTION, CONFORMED, REVISION, RECORD)

AS BUILT
–
C
10/23/13

85 FIRE ALARM
TR-245 AND TR-246 BLOCK DIAGRAM
ZONE LOGIC DIAGRAM

UNIVERSITY OF CALIFORNIA
LAWRENCE BERKELEY NATIONAL LABORATORY
FACILITIES DIVISION

DRAWN BY	HYT	DATE 2/20/2002
CHECKED BY	ONS	2/20/2002
APPROVED BY		
CAD FILE PATH		
SCALE	As Noted	
DRAWING NO.	4B85E074C	SHEET FA
PROJECT NO.	FA8040	1 OF 1