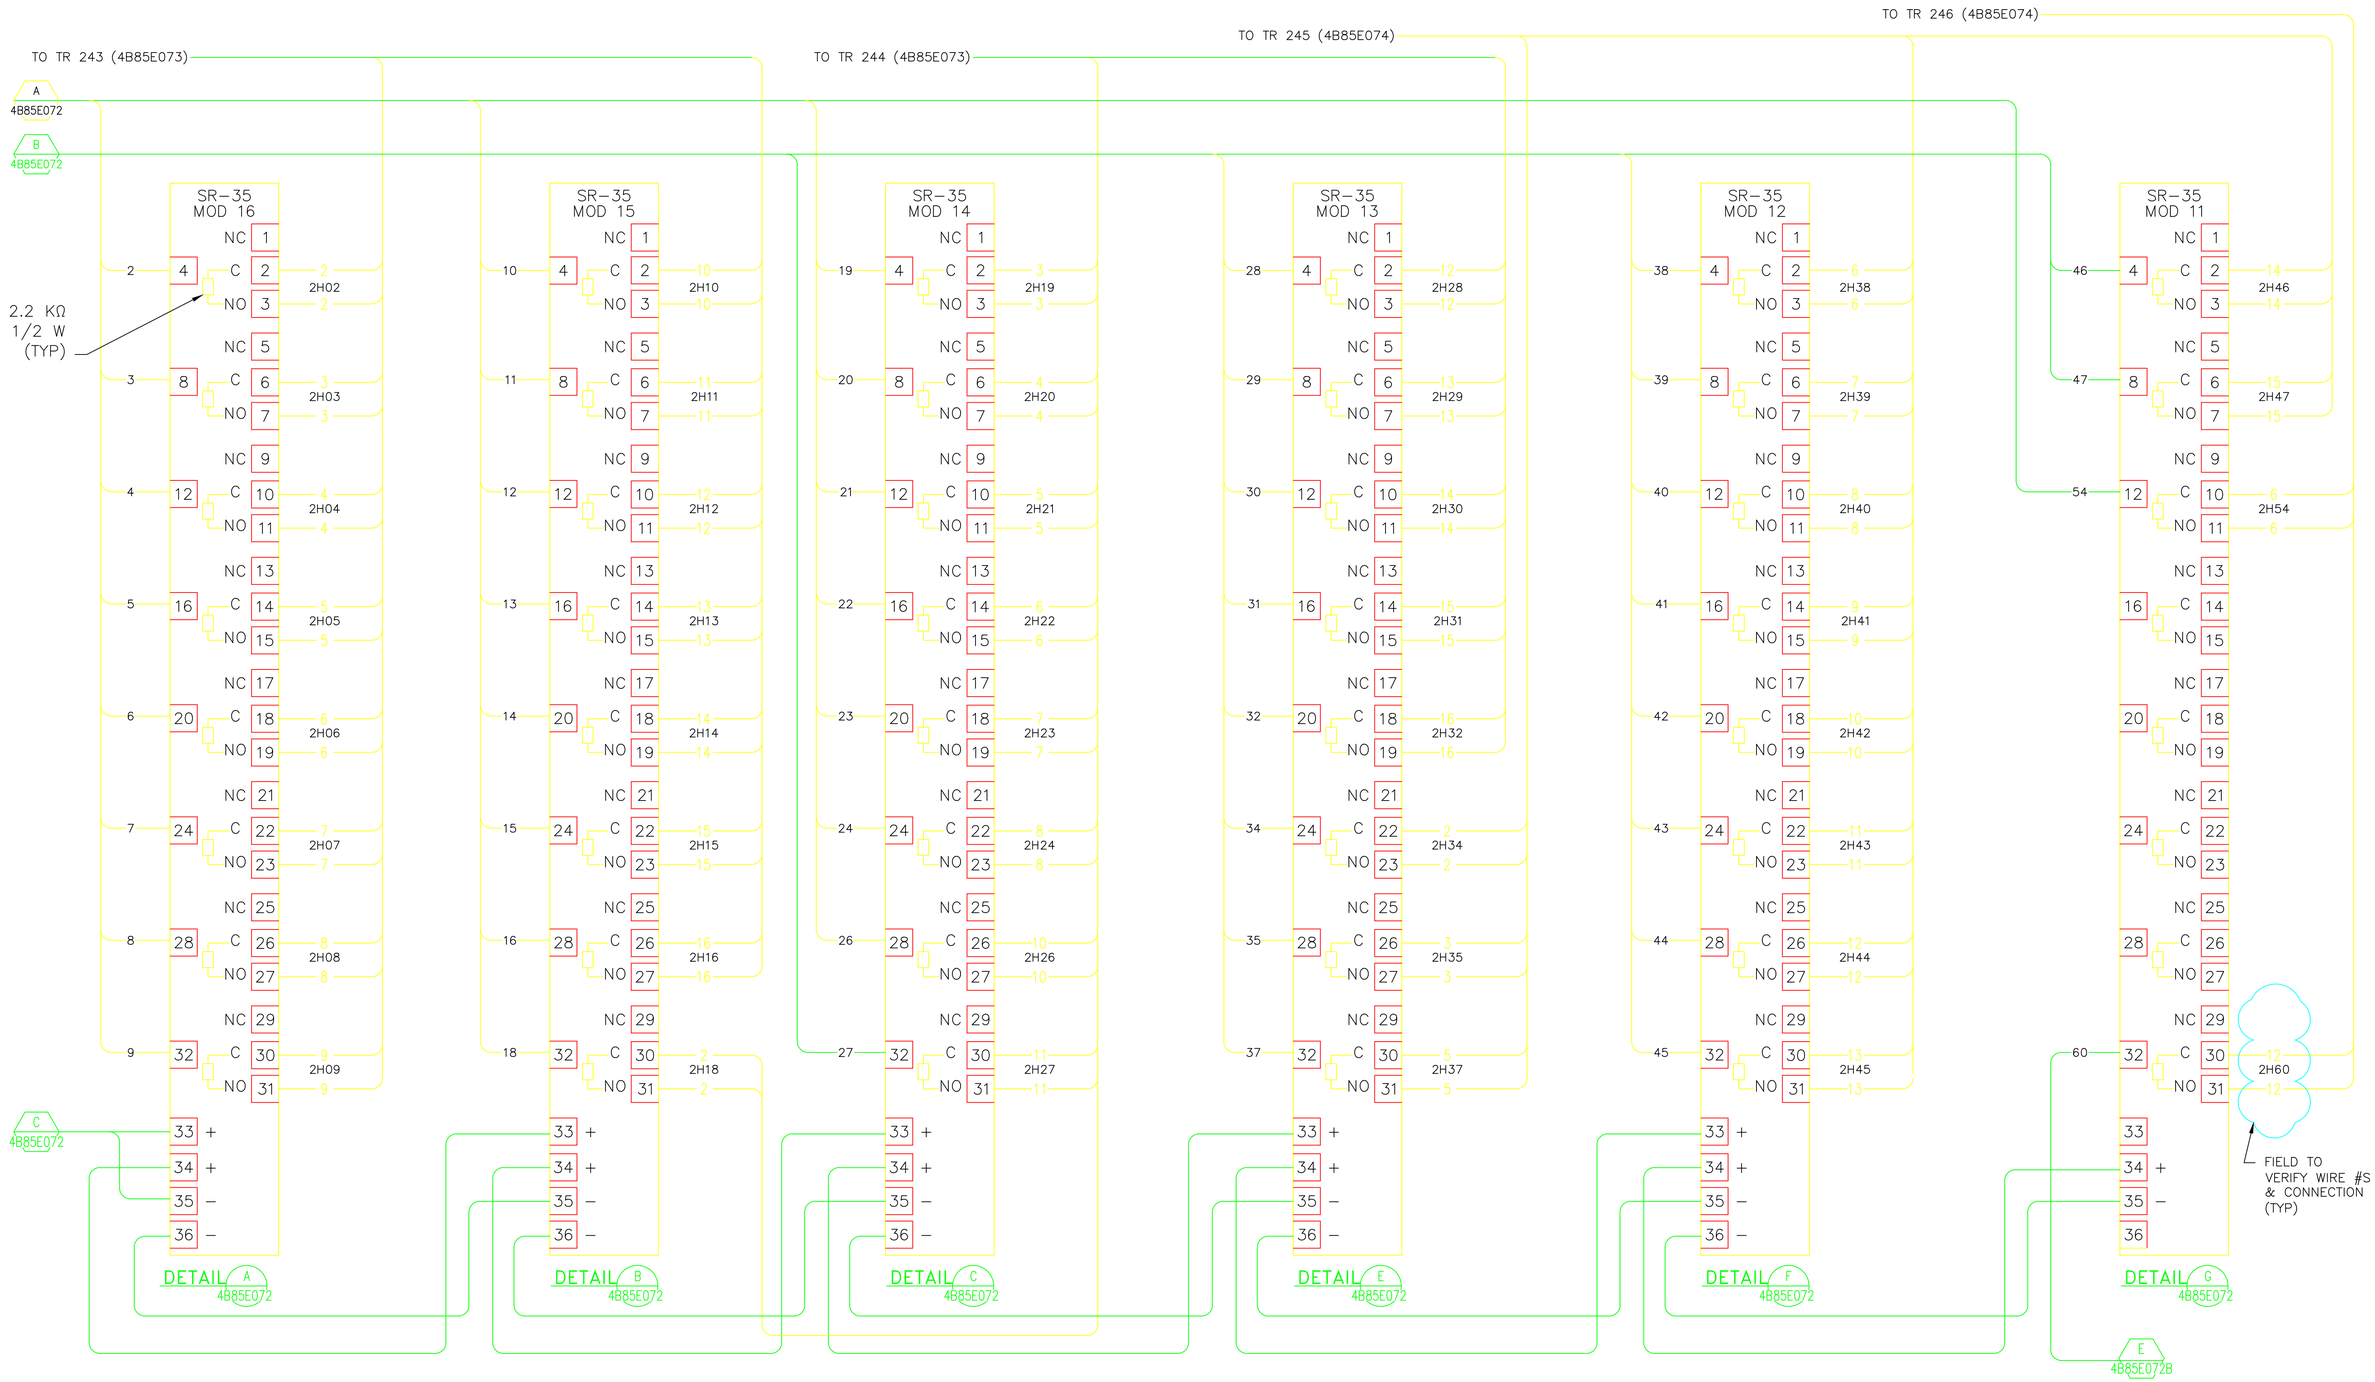

CONSTRUCTION REVISION B 3/28/2005

REVISION NUMBER	DRAWN BY	CHECKED BY	APPR'D BY	DATE	REMARKS
B	RZT	MCG	MCG	3/28/05	GEN. REV. PHASE III FA UPGRADE.
A	MRC	AD	MCG	10/13/2003	AS-BUILT, PHASE II FA UPGRADE

PROFESSIONAL SEAL (IF REVISION, APPLIES ONLY TO REVISED WORK)

ISSUE (PROGRESS, ESTIMATE, BID, CONSTRUCTION, CONFORMED, REVISION, AS-BUILT)

85 FIRE ALARM

SR-35 RELAYS

INTERCONNECTION DIAGRAM

UNIVERSITY OF CALIFORNIA
LAWRENCE BERKELEY NATIONAL LABORATORY
FACILITIES DEPARTMENT

DRAWN BY HYT	DATE 5/3/2002	
CHECKED BY HYT	5/3/2002	
APPROVED BY		
CAD FILE PATH 00019143		
SCALE As Noted		
DRAWING NO. 4B85E076B	SHEET 1 OF 1	
PROJECT NO. FA8040		