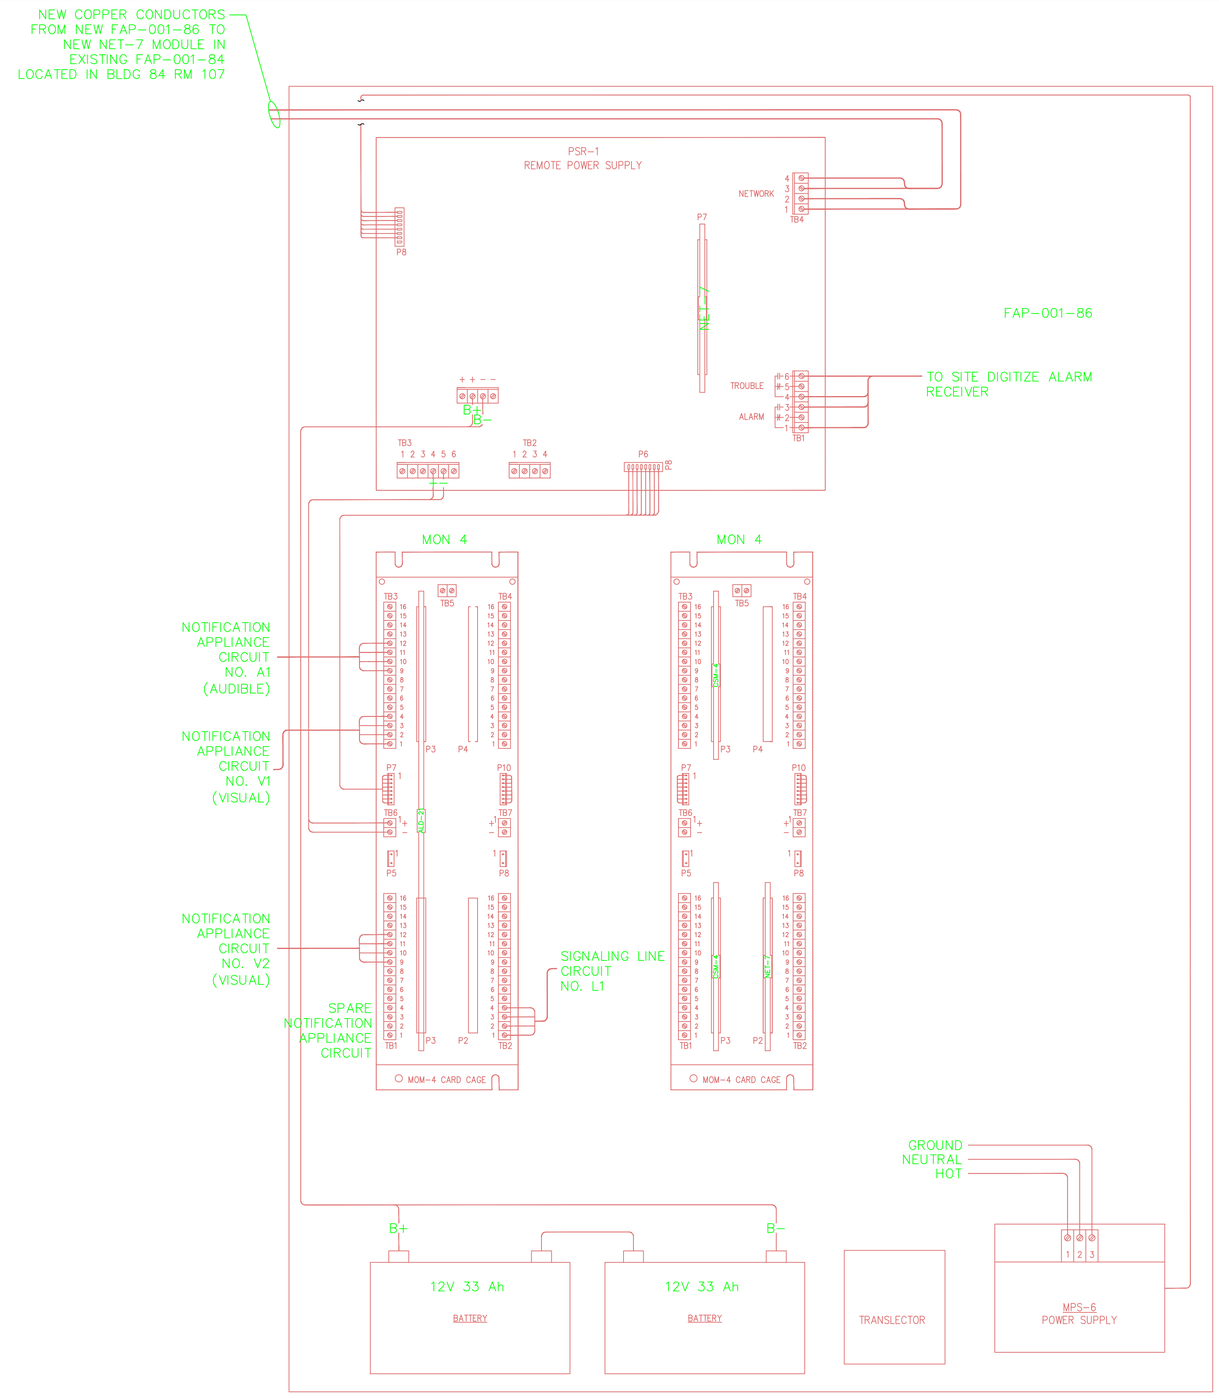

PROFESSIONAL SEAL (IF REVISION, APPLIES ONLY TO REVISED WORK)	AS BUILT — 07/19/2013						
	ISSUE (PROGRESS, ESTIMATE, BID, CONSTRUCTION, CONFORMED, REVISION, RECORD)	REVISION NUMBER	DRAWN BY	CHECKED BY	APPR'D BY	DATE	REMARKS
		_	DSV	LDD	MCD	7-19-13	AS BUILT FROM A/E RECORD DWG

BLDG 86 FIRE ALARM

MXL- FAP-001-86

UNIVERSITY OF CALIFORNIA
LAWRENCE BERKELEY NATIONAL LABORATORY
FACILITIES DIVISION

DRAWN BY DSV	DATE 07/19/2013	
CHECKED BY LDD	07/23/2013	
APPROVED BY MCD	07/23/2013	
SCALE AS NOTED		
DRAWING NO. 4B86E026_		SHEET 2
PROJECT NO. FM5500		2 OF 4