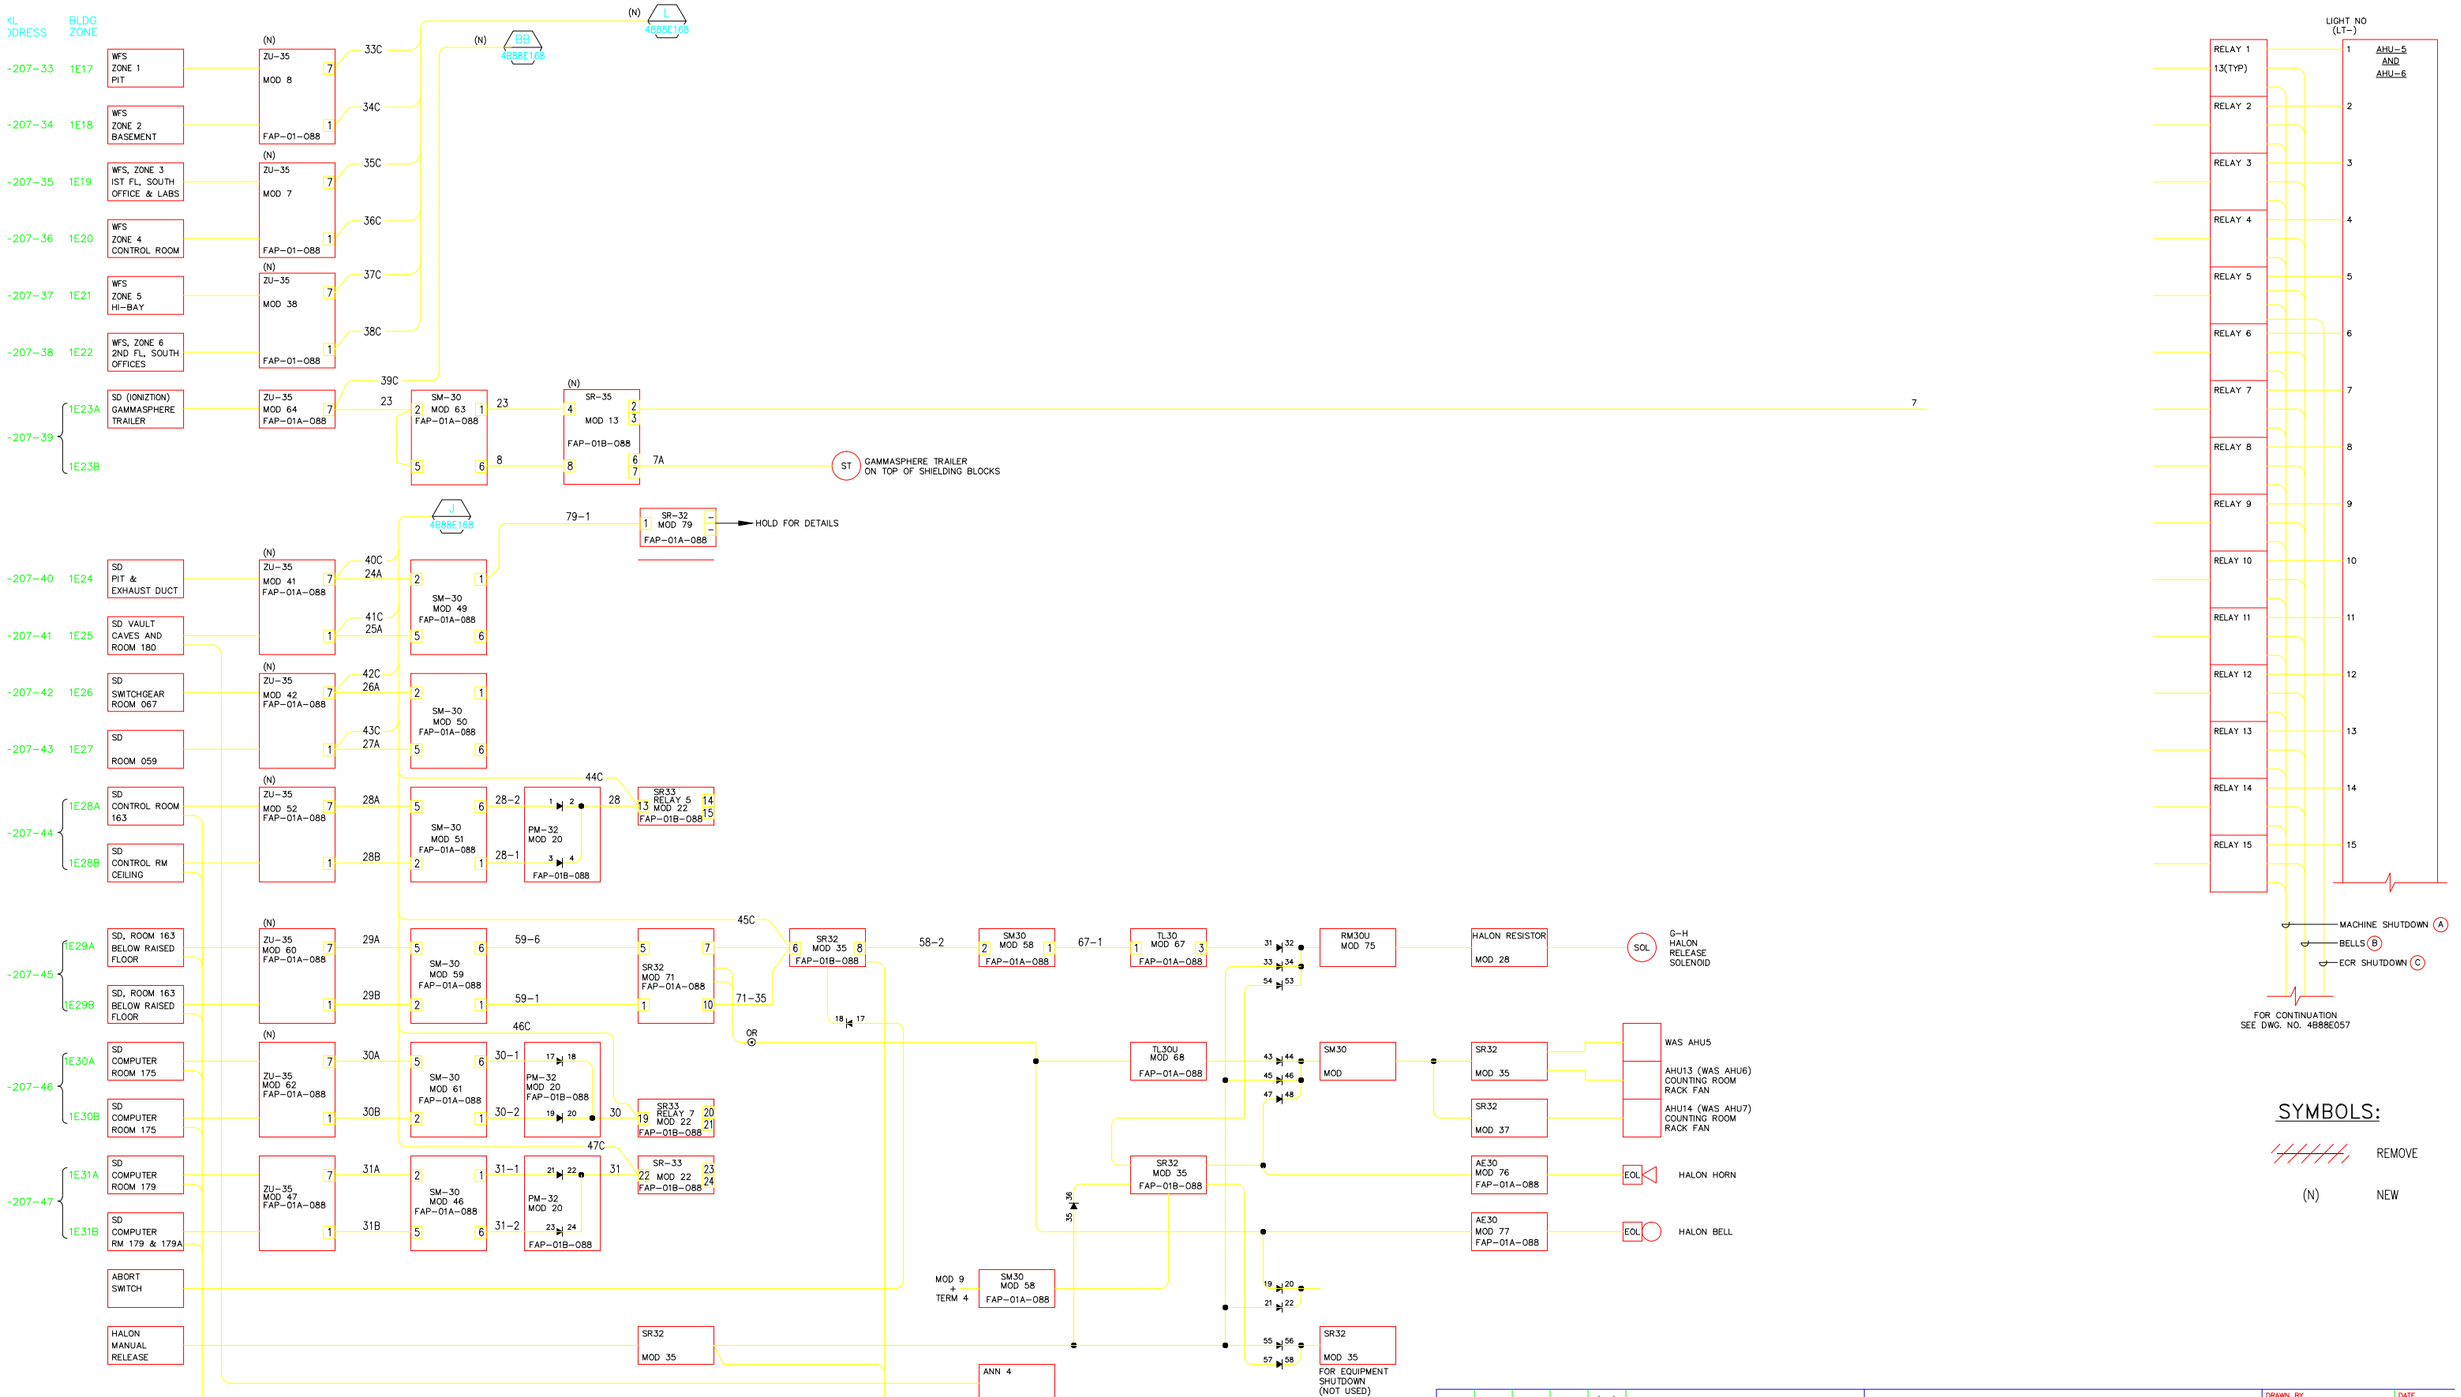

REVISION NUMBER	DRAWN BY	CHECKED BY	APPR'D BY	DATE	REMARKS
K				5/15/09	AS BUILT
J				9/30/08	AS BUILT
H	AD	LDD	MCD	7/09/07	FIRE ALARM SYSTEM UP-GRADE
G	MRC	AD	MCG	9/15/04	PHASE III FIRE ALARM SYSTEM UP-GRADE
F	LDD		MCG	9/22/99	FIELD VERIFIED AS-BUILT
E	LM		MCG	6/25/98	CONSTRUCTION COMPLETE, FIELD TO VERIFY
D	LM		MG	3-11-97	REDRAWN ON AUTOCAD

88 FIRE ALARM SYSTEM
LOGIC DIAGRAM, ZONE E17-32

UNIVERSITY OF CALIFORNIA LAWRENCE BERKELEY LABORATORY
FACILITIES DEPARTMENT

DRAWN BY LDD	DATE 9/16/19	
CHECKED BY		
APPROVED BY MCG	9/16/19	
CAD FILE PATH 00022467		
SCALE As Noted		
DRAWING NO. 4B88E056K	SHEET 1 OF 1	
PROJECT NO. FB4010		