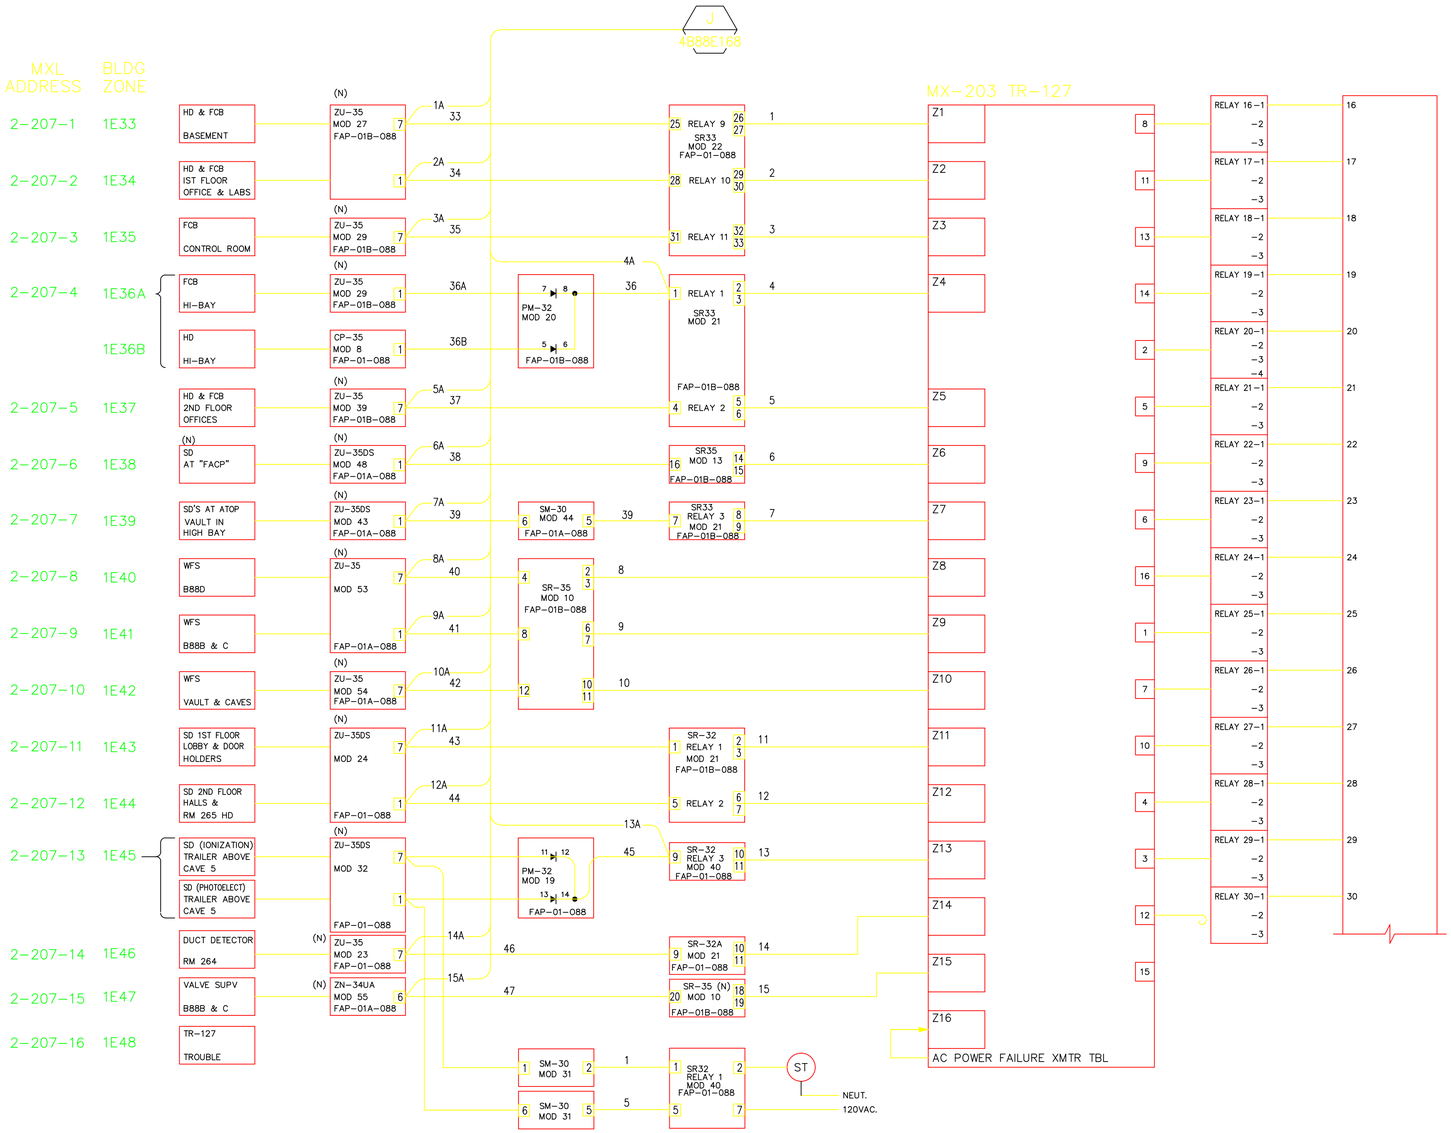

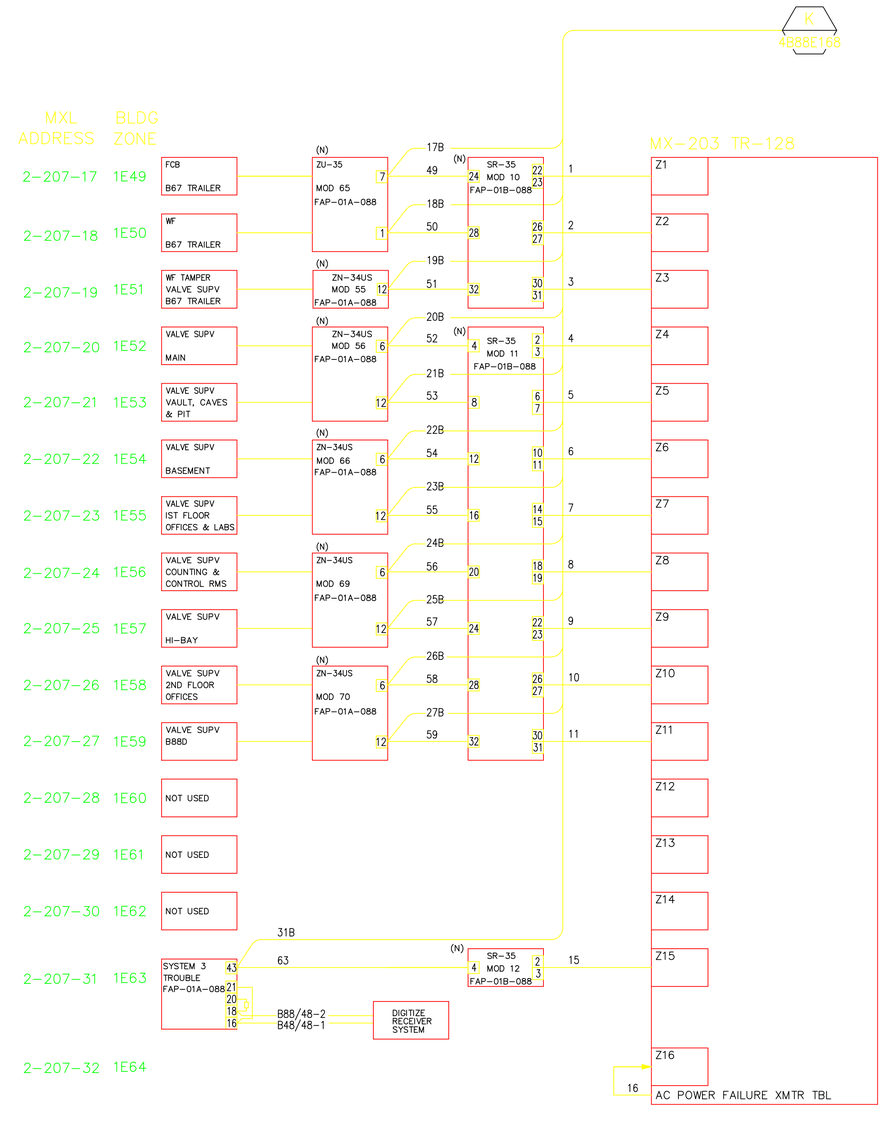

LEGEND:

(N) NEW

PROFESSIONAL SEAL (IF REVISION, APPLIES ONLY TO REVISED WORK)	ISSUE (PROGRESS, ESTIMATE, BID, CONSTRUCTION, CONFORMED, REVISION, RECORD)	REVISION NUMBER	DRAWN BY	CHECKED BY	APPR'D BY	DATE	REMARKS
	TITLE 2 CONSTRUCTION J 7/10/2007	J	AD	LDD	MCD	7/10/07	FIRE ALARM SYSTEM UP GRADE
		I	MRC	MCG	MCG	9/14/04	AS BUILT FE4002
		H	LDD		MCG	9/27/99	FIELD VERIFIED AS-BUILT
		G					REDRAWN ON AUTOCAD

88 FIRE ALARM SYSTEM
LOGIC DIAGRAM

UNIVERSITY OF CALIFORNIA
LAWRENCE BERKELEY NATIONAL LABORATORY
FACILITIES DIVISION

DRAWN BY LDD	DATE 9/16/1999	
CHECKED BY		
APPROVED BY MCG	9/16/1999	
CAD FILE PATH 00022476		
SCALE Full		
DRAWING NO. 4B88E057J	SHEET 1 OF 1	
PROJECT NO. FB4010		