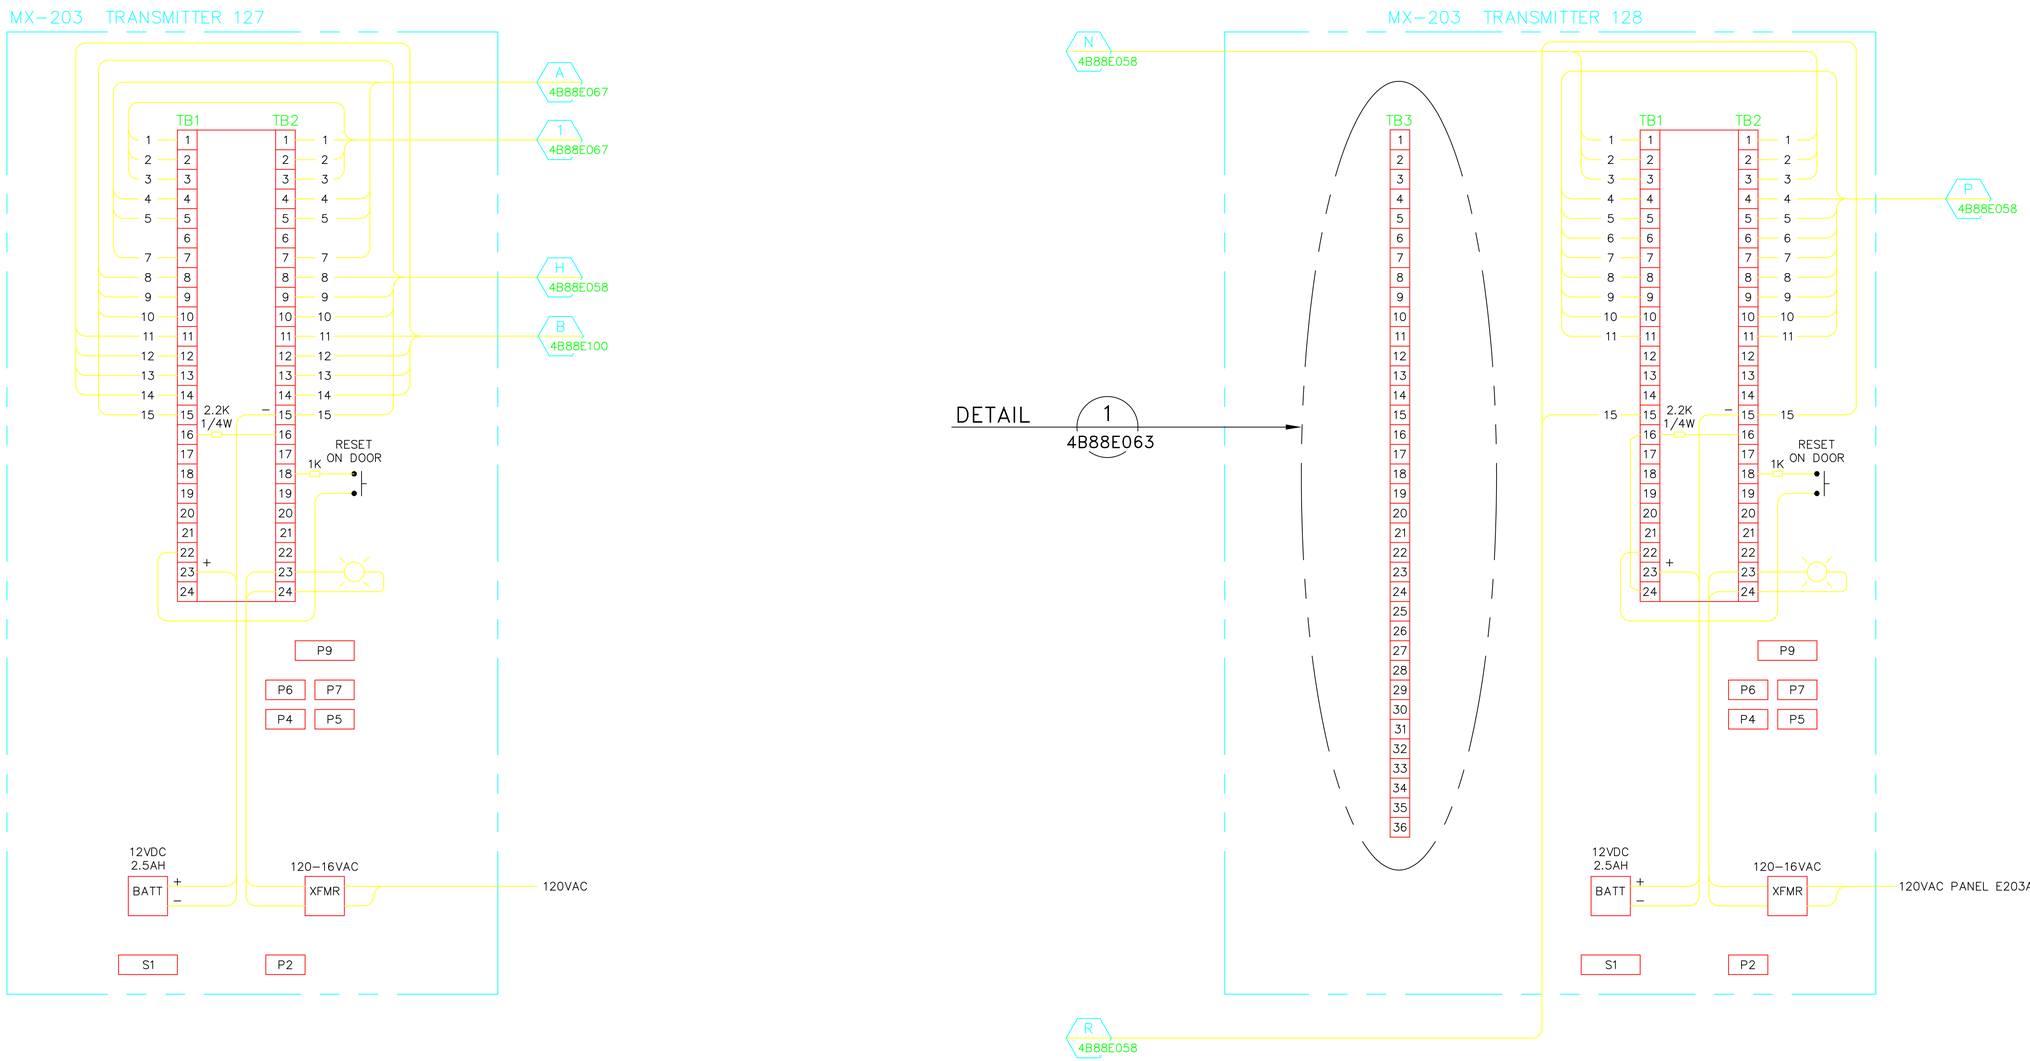

	TITLE 2 CONSTRUCTION K 7/23/2007						
		K	AD	LDD	MCD	7/23/07	FIRE ALARM SYSTEM UP-GRADE
		J	AD	AD	MCG	5/10/04	PHASE III FIRE ALARM SYSTEM UP-GRADE
		I	MRC	AD	MCG	3/20/04	PHASE III FIRE ALARM SYSTEM UP-GRADE
		H	LDD	MCG	MCG	9/28/99	FIELD VERIFIED AS-BUILT
		G	LM		MCG	8/11/98	REDRAWN ON AUTOCAD
PROFESSIONAL SEAL (IF REVISION, APPLIES ONLY TO REVISED WORK)	ISSUE (PROGRESS, ESTIMATE, BID, CONSTRUCTION, CONFORMED, REVISION, RECORD)	REVISION NUMBER	DRAWN BY	CHECKED BY	APPR'D BY	DATE	REMARKS

88 FIRE ALARM SYSTEM

MX-203 CABINET XMTR'S 127 & 128 INTERCONNECTION DIAGRAM

UNIVERSITY OF CALIFORNIA
LAWRENCE BERKELEY NATIONAL LABORATORY
FACILITIES DIVISION

DRAWN BY LM		DATE 8/11/1998
CHECKED BY		
APPROVED BY MCG		8/11/1998
CAD FILE PATH 00022491		
SCALE Full		
DRAWING NO. 4B88E060K		SHEET 1 OF 1
PROJECT NO. FB4010		