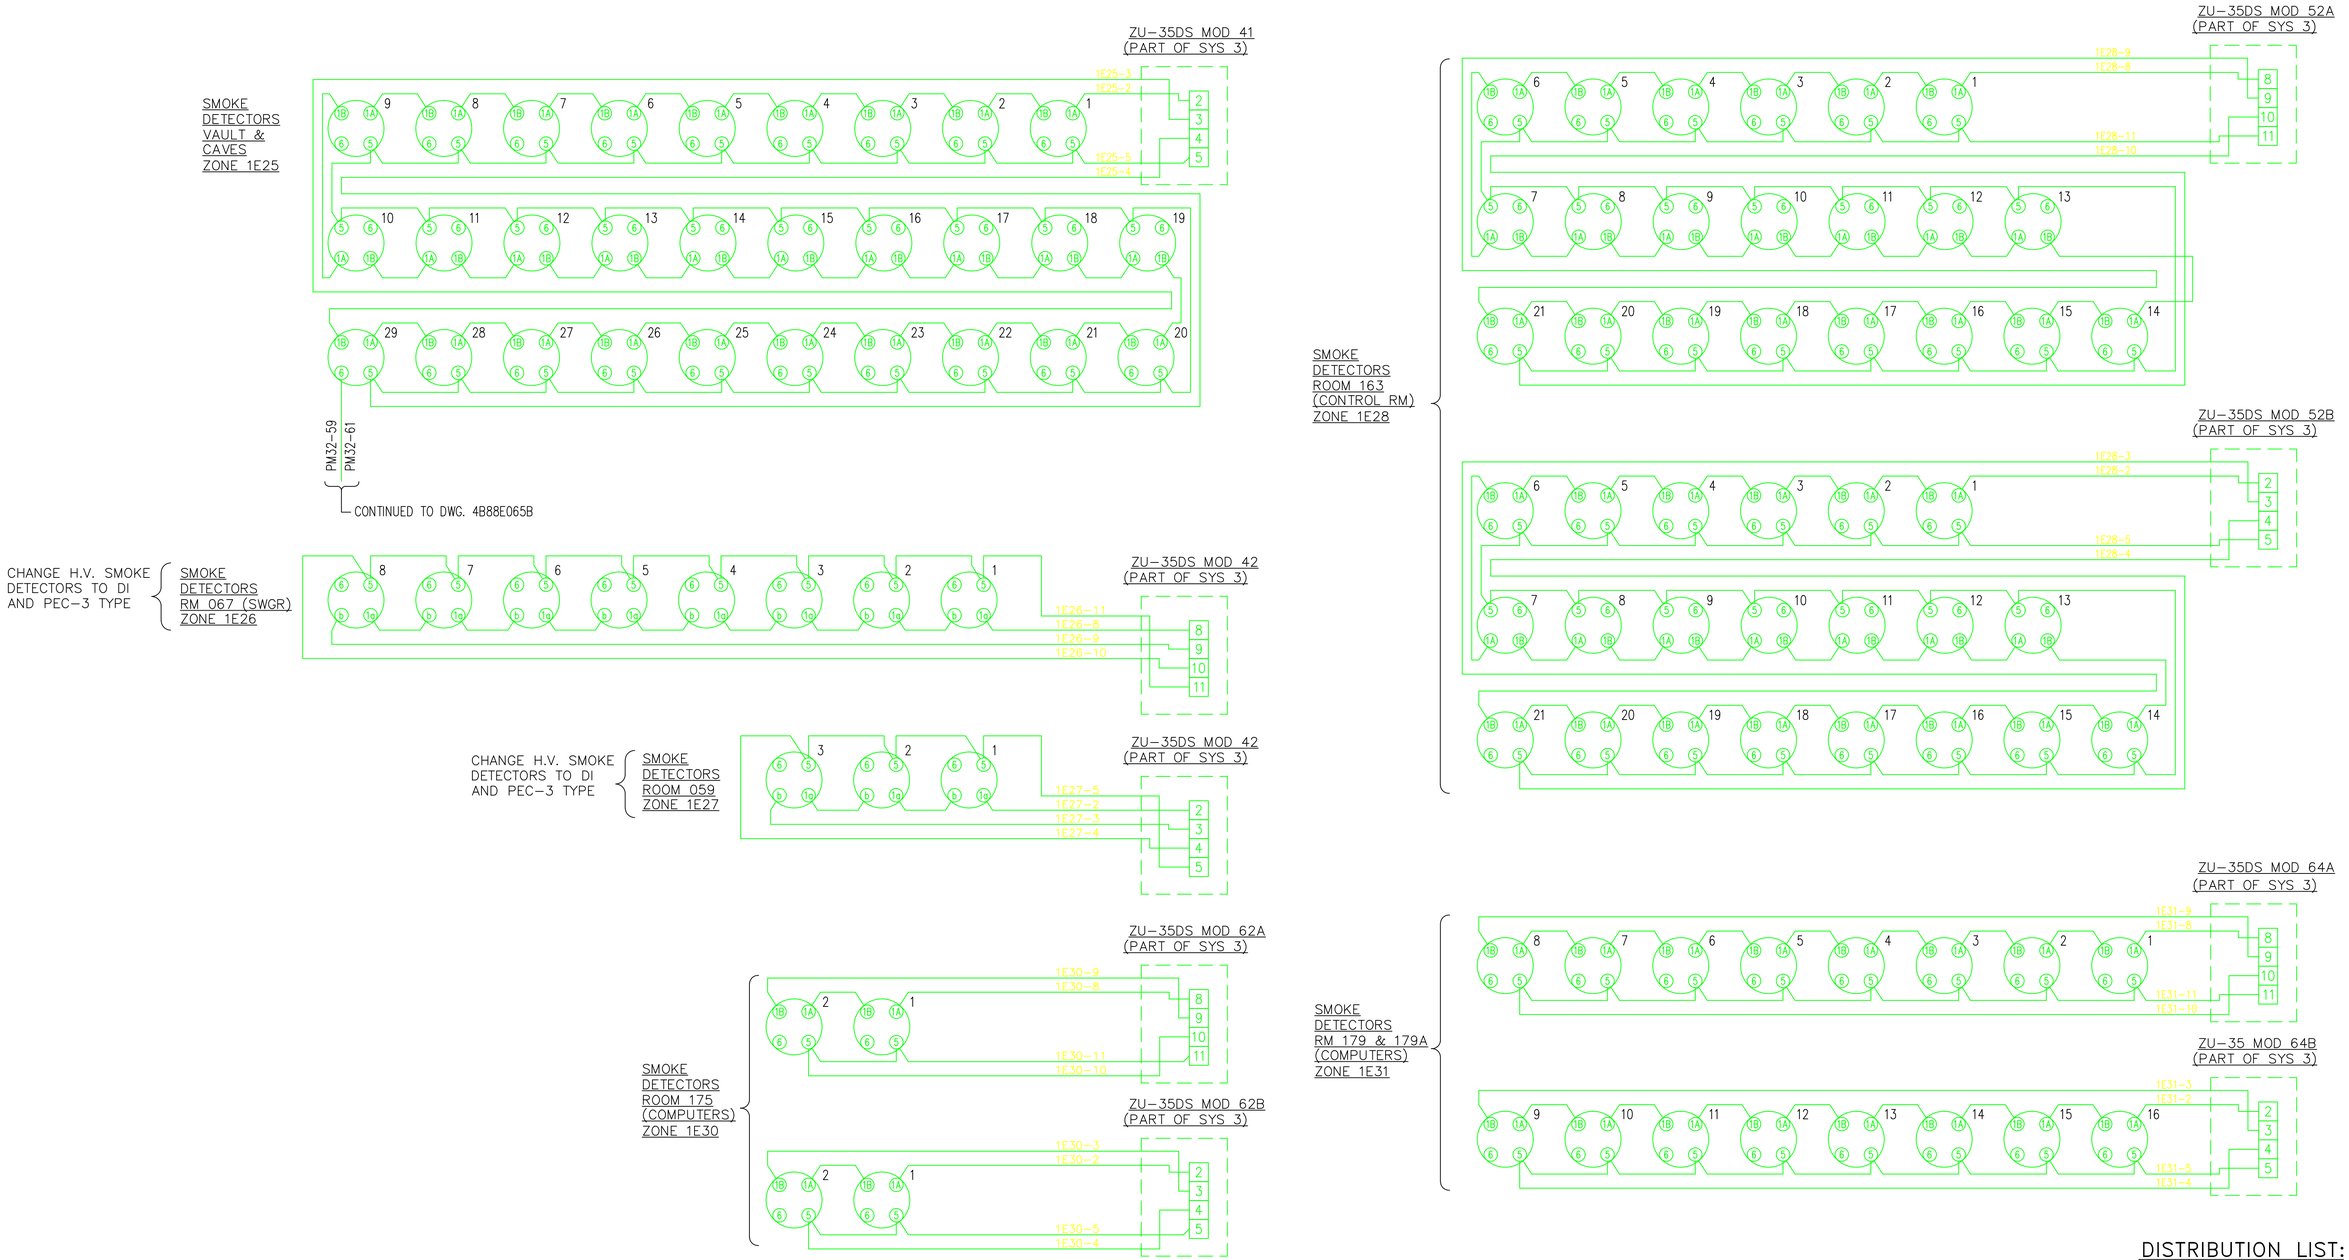


## DISTRIBUTION LIST:

1 - ELECTRIC SHOP B76 (FILE I )
1 - STICK FILE
ORIGINAL - FLAT FILE B90F

FOR REFERENCE DRAWINGS SEE DWG. 4B88E054

| REVISION NUMBER | DRAWN BY | CHECKED BY | APPR'D BY | DATE | REMARKS |
|---|---|---|---|---|---|
| E | RZT | MCG | MCG | 3/28/05 | PHASE III FA UPGRADES |
| D | LDD | | MCG | 9/21/99 | FIELD VERIFIED AS-BUILT |
| C | LM | | MCG | 8/11/98 | AUTOCAD CONVERSION |
| B | VA | MG | | 2/11/98 | REVISED AS NOTED |
| A | RG | BHS | | 5/86 | ZONE 1E21/1E41 COORDINATION |

88 FIRE ALARM
INTERCONN DIAGRAM DEVICES
ZONE E25-28,30,31

UNIVERSITY OF CALIFORNIA LAWRENCE BERKELEY LABORATORY
FACILITIES DEPARTMENT

| | | | |
|---|---|---|---|
| DRAWN BY | LSR | DATE | 6-1-84 |
| CHECKED BY | HT | | – |
| APPROVED BY | – | | – |
| CAD FILE PATH | 00019120.DWG | | |
| SCALE | – | | |
| DRAWING NO. | 4B88E061E | SHEET | — |
| PROJECT NO. | 153794 | | 1 OF 1 |