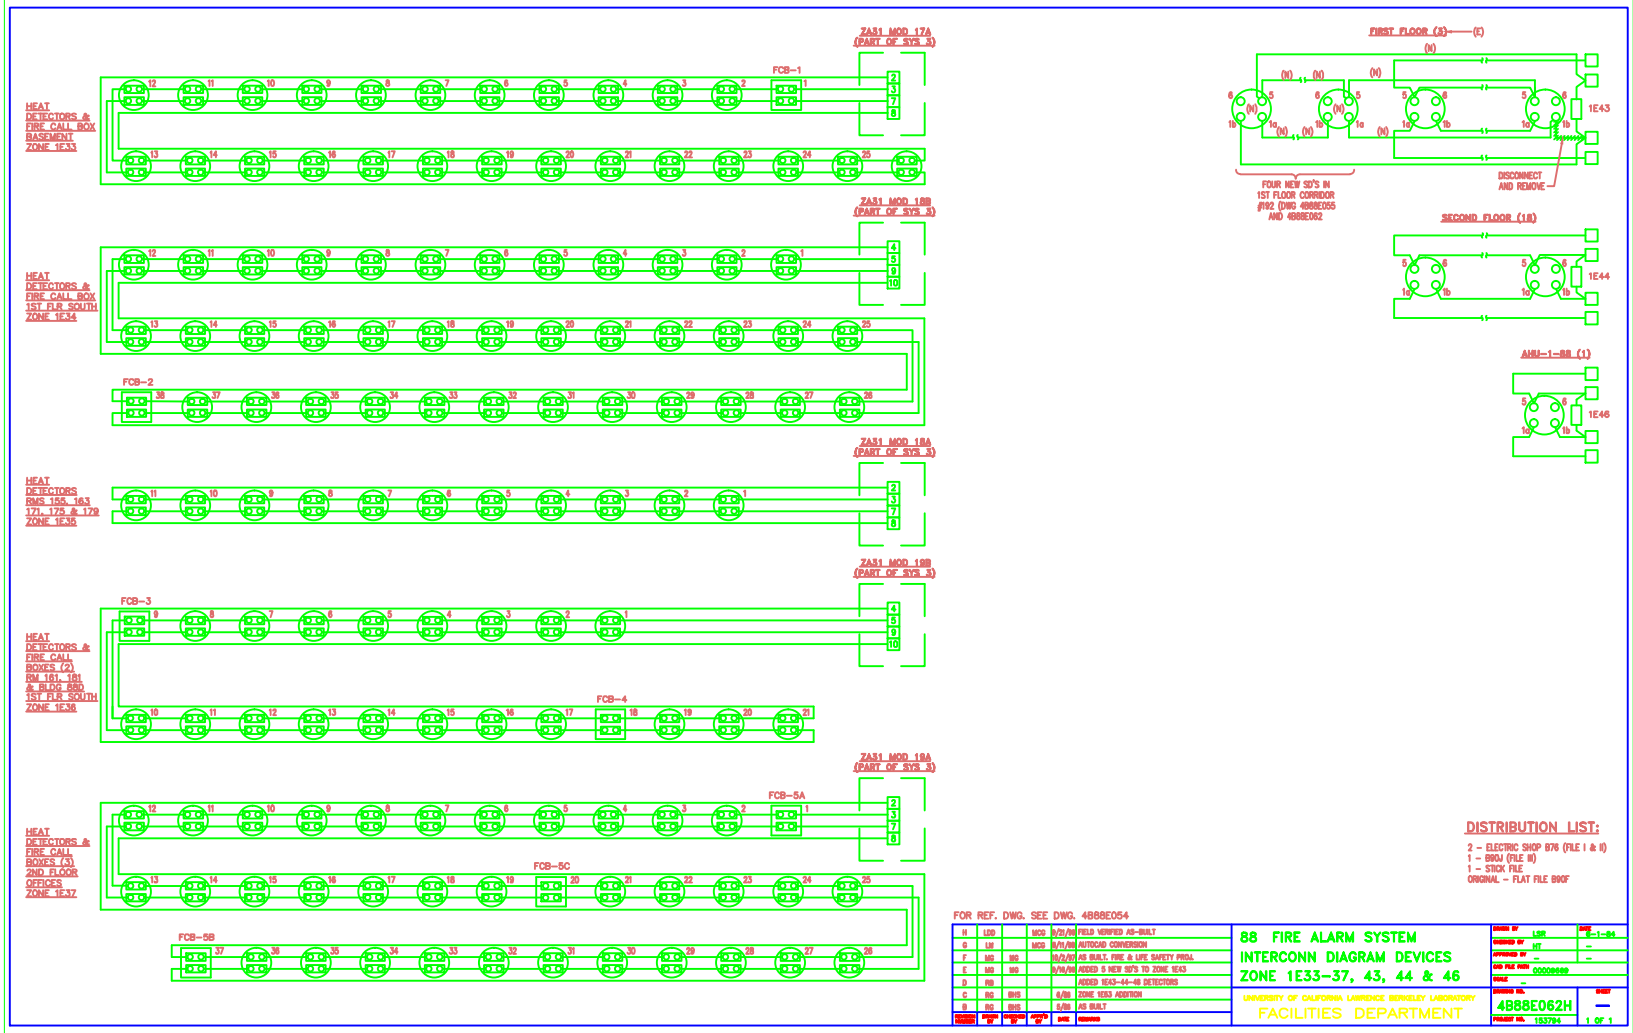

DISTRIBUTION LIST:

2 - ELECTRIC SHOP B76 (FILE I & II)
1 - B90J (FILE III)
1 - STICK FILE
ORIGINAL - FLAT FILE B90F

FOR REF. DWG. SEE DWG. 4B88E054

H	LDD		MCG	9/21/94	FIELD VERIFIED AS-BUILT
G	LH		MCG	9/11/94	AUTOCAD CONVERSION
F	MG	MG		10/3/90	AS BUILT, FIRE & LIFE SAFETY PROJ.
E	MG	MG		9/16/94	ADDED 5 NEW SD'S TO ZONE 1E43
D	RB				ADDED 1E43-44-46 DETECTORS
C	RG	BHS		6/88	ZONE 1E53 ADDITION
B	RG	BHS		5/88	AS BUILT
REVISION	DRAWN BY	CHECKED BY	APPROVED BY	DATE	REMARKS

88 FIRE ALARM SYSTEM
INTERCONN DIAGRAM DEVICES
ZONE 1E33-37, 43, 44 & 46

UNIVERSITY OF CALIFORNIA LAWRENCE BERKELEY LABORATORY
FACILITIES DEPARTMENT

DRAWN BY	LSR	DATE	12-1-84
CHECKED BY	HT		--
APPROVED BY	--		--
CAD FILE NAME	00009669		
SCALE	--		
DRAWING NO.	4B88E062H	SHEET	--
PROJECT NO.	153784		1 OF 1