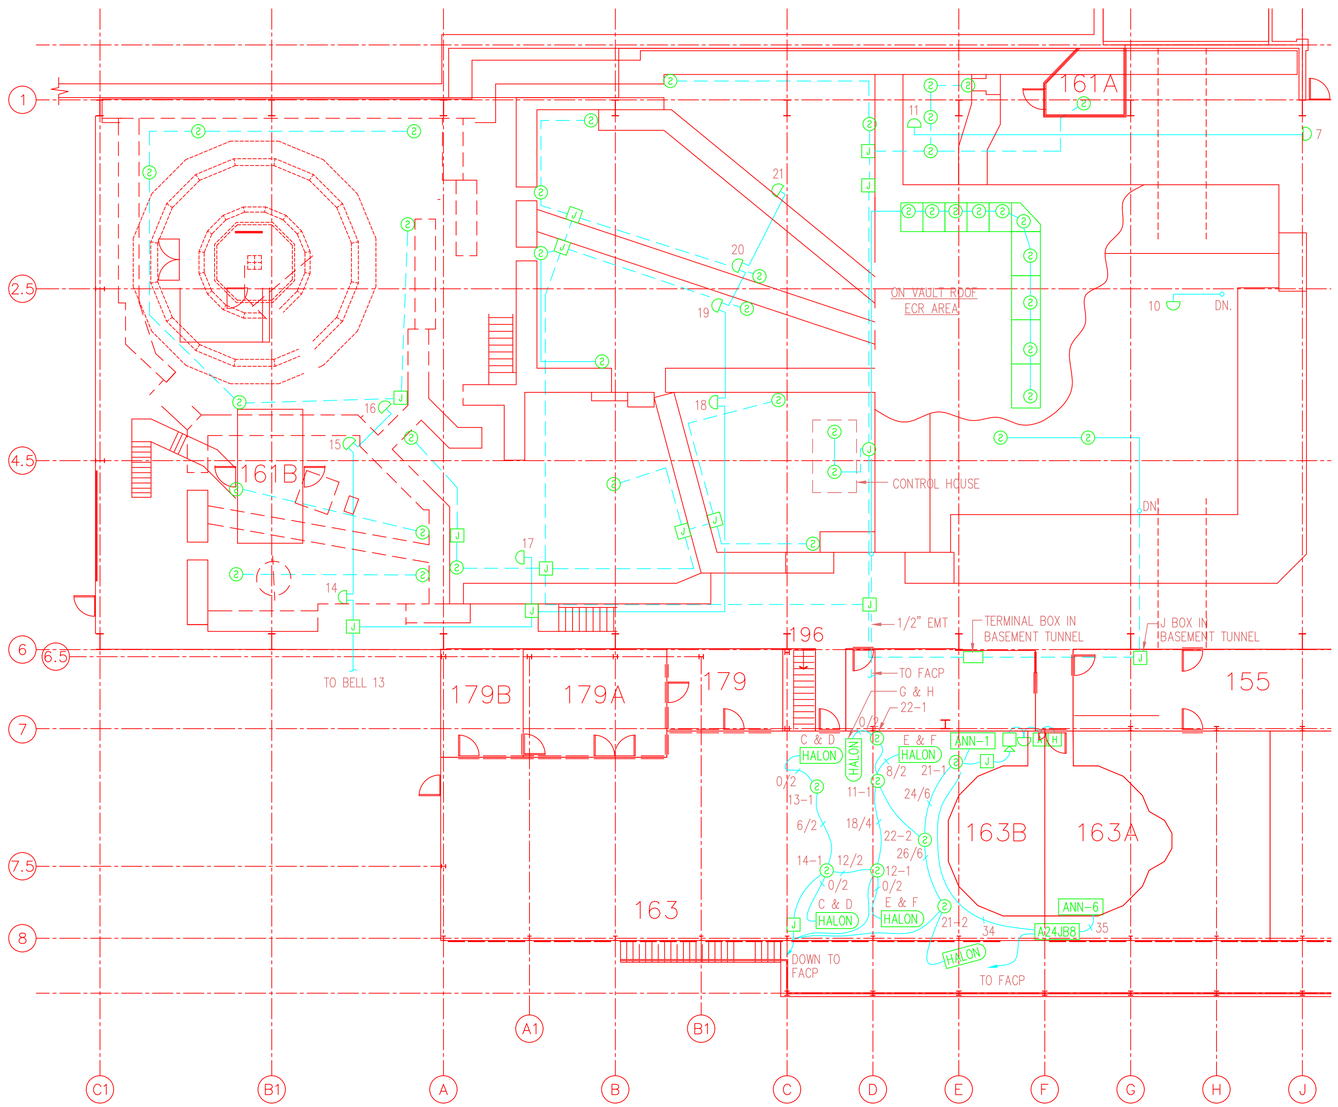

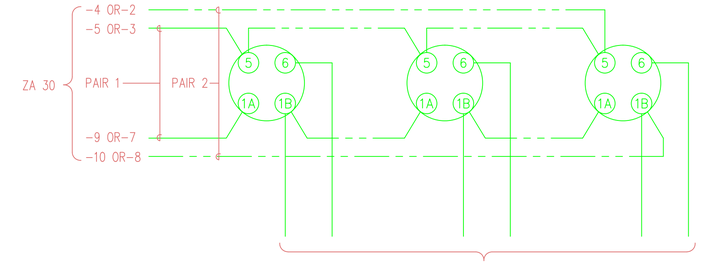

SMOKE DETECTORS

DETAIL A

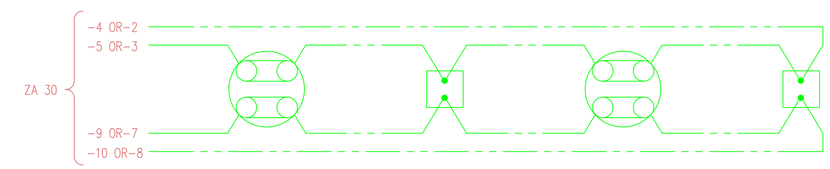

THERMAL DETECTOR/FIRE CALL BOX

DETAIL C

BLDG 88 PARTIAL PLAN–CONTROL ROOM AND CAVES PLAN

SCALE: 3/32"=1'-0"

LEGEND

BELL CIRCUIT

DETECTOR CIRCUIT

REFERENCE DWGS:

4B88E054

DISTRIBUTION LIST:

2 – ELECTRIC SHOP B76 (FILE I & II)
1 – B90J (FILE III)
1 – STICK FILE
ORIGINAL – FLAT FILE B90F

REVISION NUMBER	DRAWN BY	CHECKED BY	APPR'D BY	DATE	REMARKS
C	LDD		MCG	9/28/99	FIELD VERIFIED AS-BUILT
B	LM		MCG	8/12/98	AUTOCAD CONVESION
A	RG	BHS		3/86	ADDED ECR SMOKE DETECTORS

88 FIRE ALARM SYSTEM
CONTROL ROOM & CAVES PLAN

UNIVERSITY OF CALIFORNIA LAWRENCE BERKELEY LABORATORY
FACILITIES DEPARTMENT

DRAWN BY	HW/LSR	DATE	6-1-84
CHECKED BY	HT		–
APPROVED BY	–		–
CAD FILE PATH	00009673		
SCALE	AS SHOWN		
DRAWING NO.	4B88E064C	SHEET	—
PROJECT NO.	153794		1 OF 1