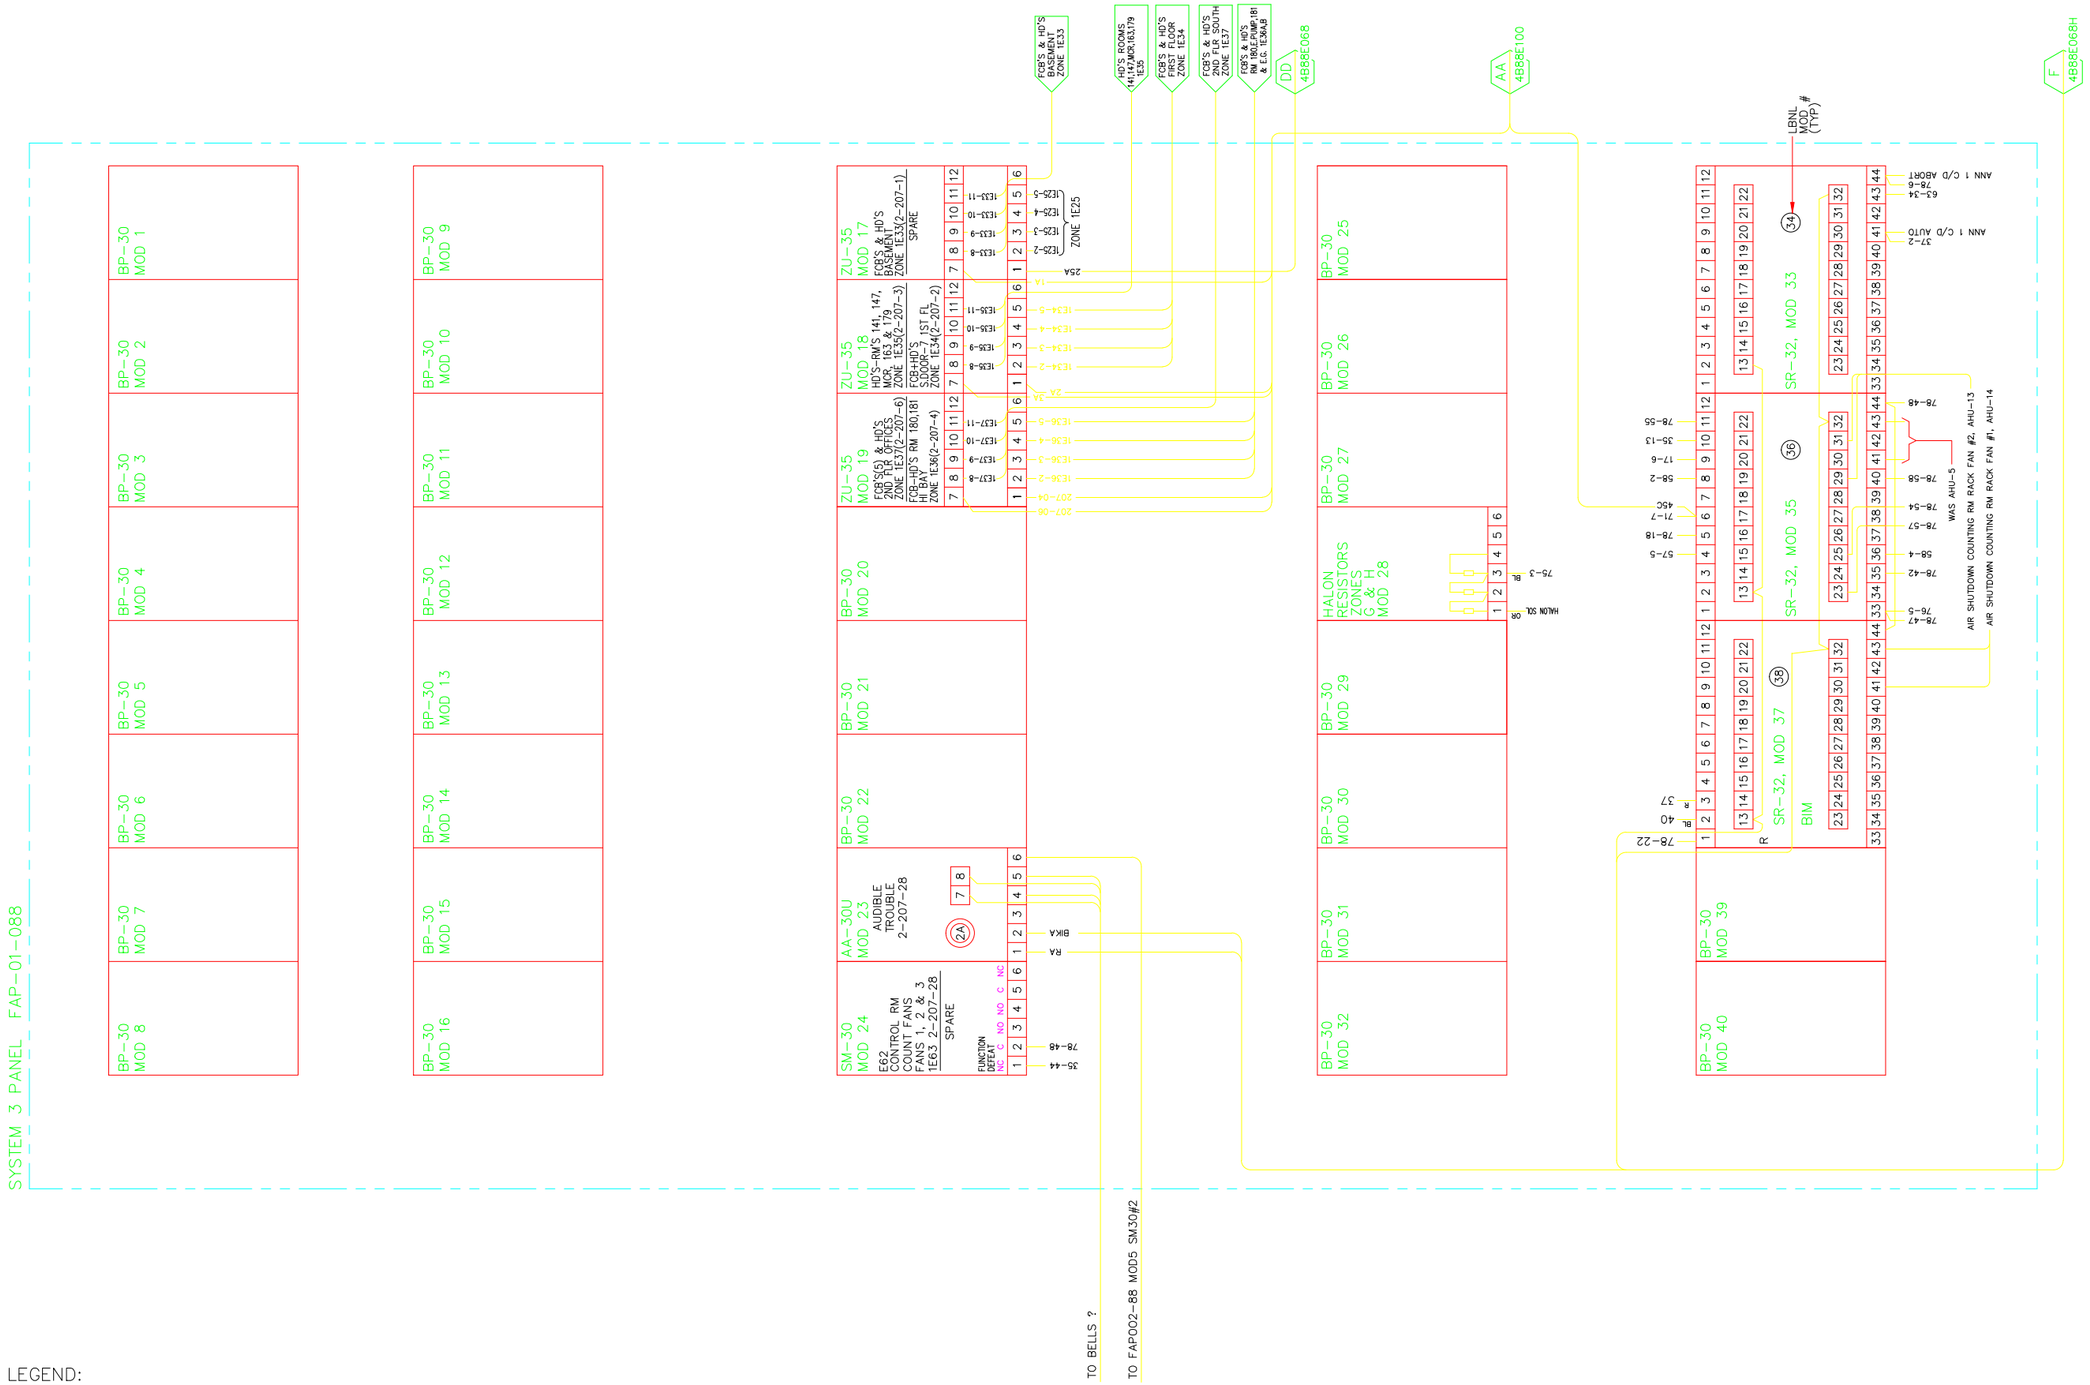

LEGEND:

ZONE 1E33 (2-207-40)

MXL ADDRESS

BUILDING ZONE

	AS BUILT L 6/20/13	L	DSV	LDD	MCD	6/20/13	AS BUILT PER FIELD VERIFICATION	88 FIRE ALARM SYSTEM SYSTEM 3 PANEL FAP-01B-088 INTERCONNECTION DIAGRAM
		K				5/15/09	AS BUILT	
		J				9/30/08	AS BUILT	
		H	AD	LDD	MCD	07/11/07	FIRE ALARM SYSTEM UPGRADE	
		G	MRC	AD	MCG	05/07/04	PHASE III FIRE ALARM UPGRADE	
		F	LDD		MCG	9/28/99	FIELD VERIFIED AS-BUILT	
		E	FWD	MCG	MCG	4/30/98	REDRAWN ON AUTOCAD	
PROFESSIONAL SEAL (IF REVISION, APPLIES ONLY TO REVISED WORK)	ISSUE (PROGRESS, ESTIMATE, BID, CONSTRUCTION, CONFORMED, REVISION, RECORD)	REVISION NUMBER	DRAWN BY	CHECKED BY	APPR'D BY	DATE	REMARKS	UNIVERSITY OF CALIFORNIA LAWRENCE BERKELEY NATIONAL LABORATORY FACILITIES DIVISION

DRAWN BY LSR — DATE 11/1/198
CHECKED BY
APPROVED BY
CAD FILE PATH
SCALE Full
DRAWING NO. 4B88E067L — SHEET 1 OF 1
PROJECT NO. FB4010