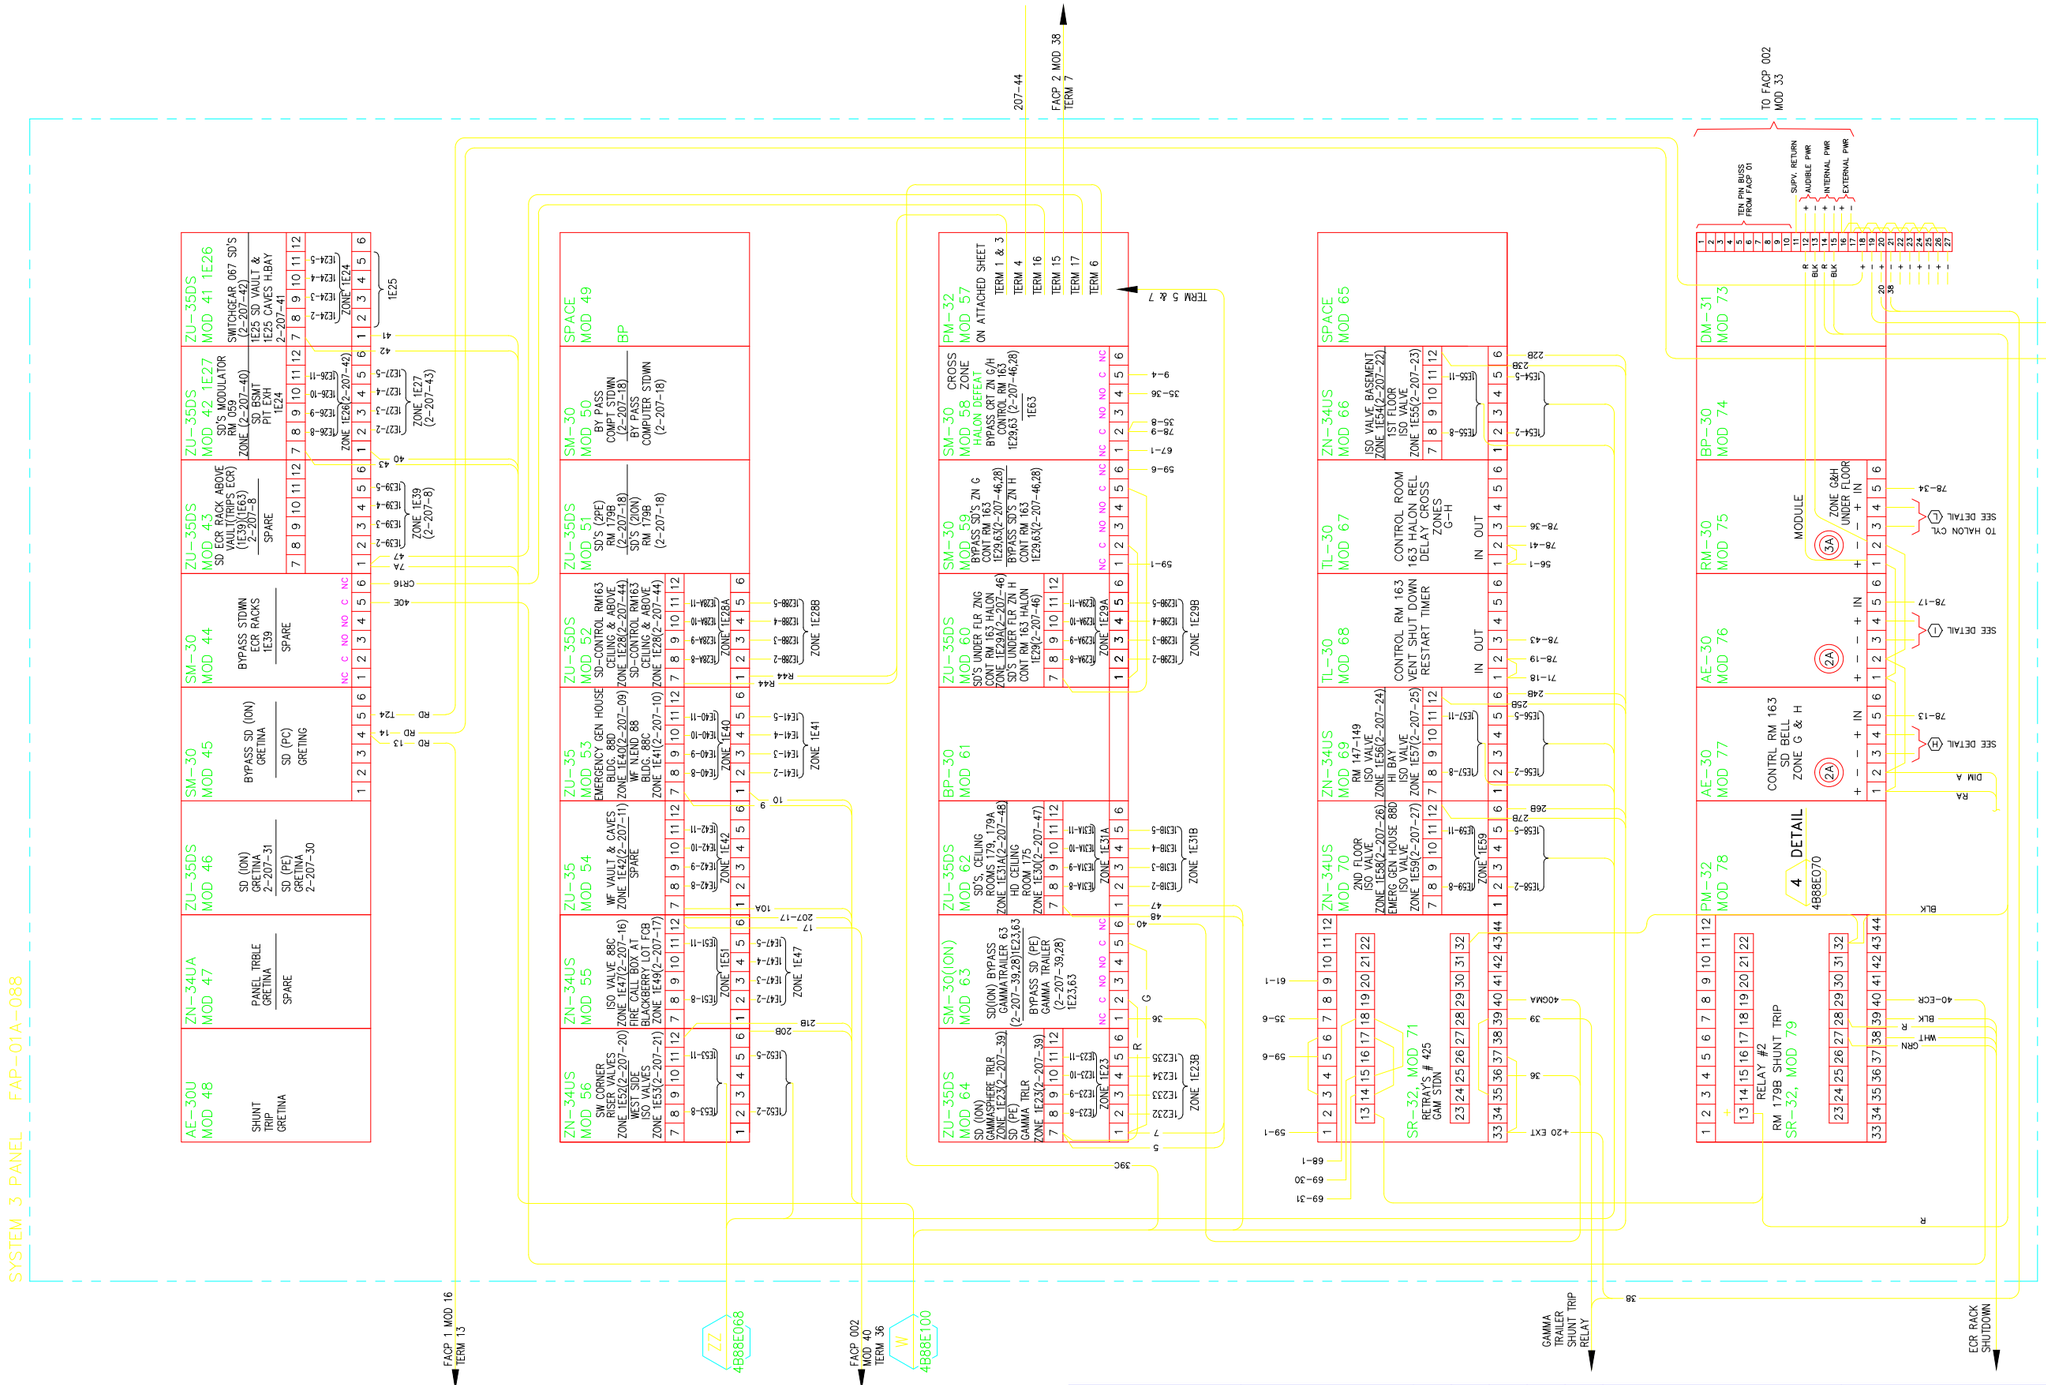

NOTES:

1. SEE DEVICE WIRING DETAILS ON 4B88E070.

LEGEND:

ZONE 1E33 (2-207-40)

MXL ADDRESS

BUILDING ZONE

	ASBUILT	L	DSV	LDD	MCD	6/20/13	AS BUILT PER FIELD VERIFICATION
		K				5/15/09	AS BUILT
		J				09/30/08	AS BUILT
		H	AD	LDD	MCD	7/12/07	FIRE ALARM SYSTEM UP-GRADE
		G	MRC	AD	MCG	9/17/04	PHASE III FIRE ALARM SYSTEM UP-GRADE
		F	LDD		MCG	9/28/99	FIELD VERIFIED AS-BUILT
		E	LM		MCG	6/25/98	CONSTRUCTION COMPLETE, FIELD TO VERIFY
PROFESSIONAL SEAL (IF REVISION, APPLIES ONLY TO REVISED WORK)	ISSUE L 06/20/13 (PROGRESS, ESTIMATE, BID, CONSTRUCTION, CONFORMED, REVISION, RECORD)	REVISION NUMBER	DRAWN BY	CHECKED BY	APPR'D BY	DATE	REMARKS

88 FIRE ALARM SYSTEM

SYSTEM 3 PANEL WIRING

PANEL FAP-01A-088

UNIVERSITY OF CALIFORNIA
LAWRENCE BERKELEY NATIONAL LABORATORY
FACILITIES DIVISION

DRAWN BY	LDD
DATE	9/28/199
CHECKED BY	
APPROVED BY	MCG
DATE	9/28/199
CAD FILE PATH	
SCALE	As Noted
DRAWING NO.	4B88E068L
SHEET	1 OF 1
PROJECT NO.	FB4010