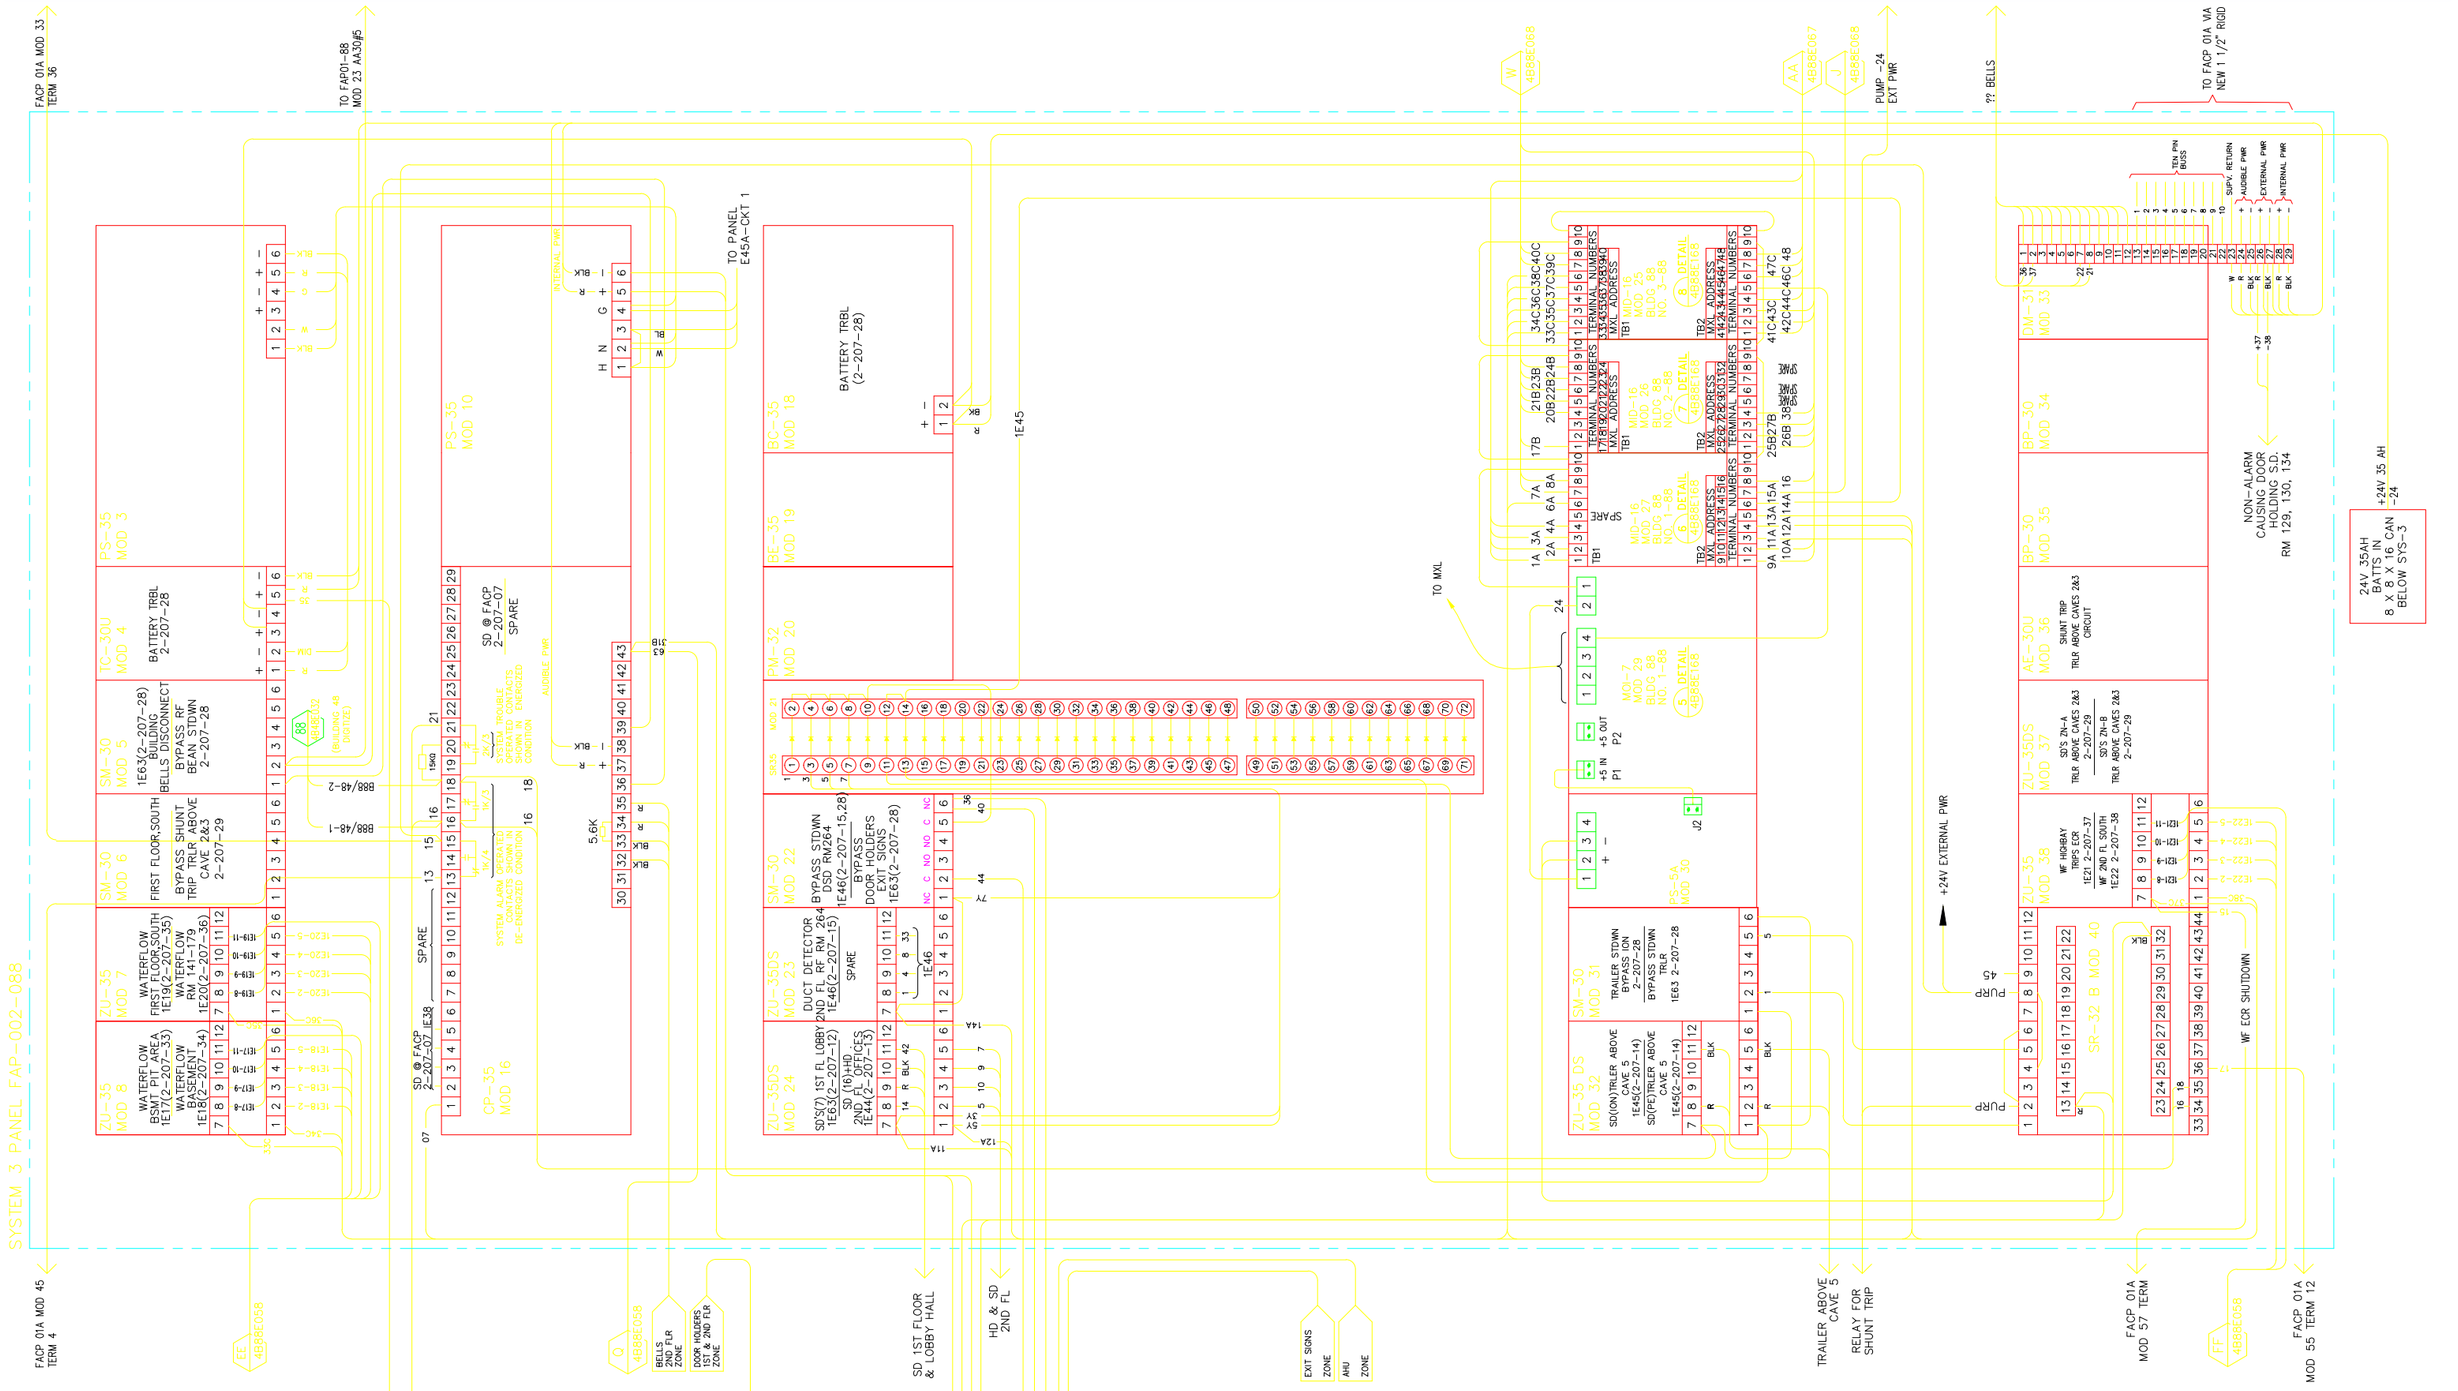


LEGEND:

ZONE 1E33 (2-207-40)

- MXL ADDRESS
- BUILDING ZONE

ASBUILT

F

6/20/13

| REVISION NUMBER | DRAWN BY | CHECKED BY | APPR'D BY | DATE | REMARKS |
|---|---|---|---|---|---|
| F | DSV | LDD | MCD | 6/20/13 | AS BUILT PER FIELD VERIFICATION |
| E | | | | 09/30/08 | AS BUILT |
| D | AD | LDD | MCD | 07/11/07 | FIRE ALARM SYSTEM UPGRADE |
| C | MRC | AD | MCG | 05/06/04 | PHASE III FIRE ALARM UPGRADE |
| B | LDD | | MCG | 9/28/99 | FIELD VERIFIED AS-BUILT |
| A | FWD | MCG | MCG | 5/1/98 | AS BUILT |

PROFESSIONAL SEAL (IF REVISION, APPLIES ONLY TO REVISED WORK)

ISSUE (PROGRESS, ESTIMATE, BID, CONSTRUCTION, CONFORMED, REVISION, RECORD)

# 88 FIRE ALARM SYSTEM
## SYSTEM 3 WIRING
## PANEL FAP-01-088

UNIVERSITY OF CALIFORNIA
LAWRENCE BERKELEY NATIONAL LABORATORY
FACILITIES DIVISION

| | | |
|---|---|---|
| DRAWN BY | FWD | DATE 4/30/199 |
| CHECKED BY | MCG | 5/1/1995 |
| APPROVED BY | MCG | 5/1/1995 |
| CAD FILE PATH | | |
| SCALE | Full | |
| DRAWING NO. | 4B88E100F | SHEET |
| PROJECT NO. | FB4010 | 1 OF 1 |