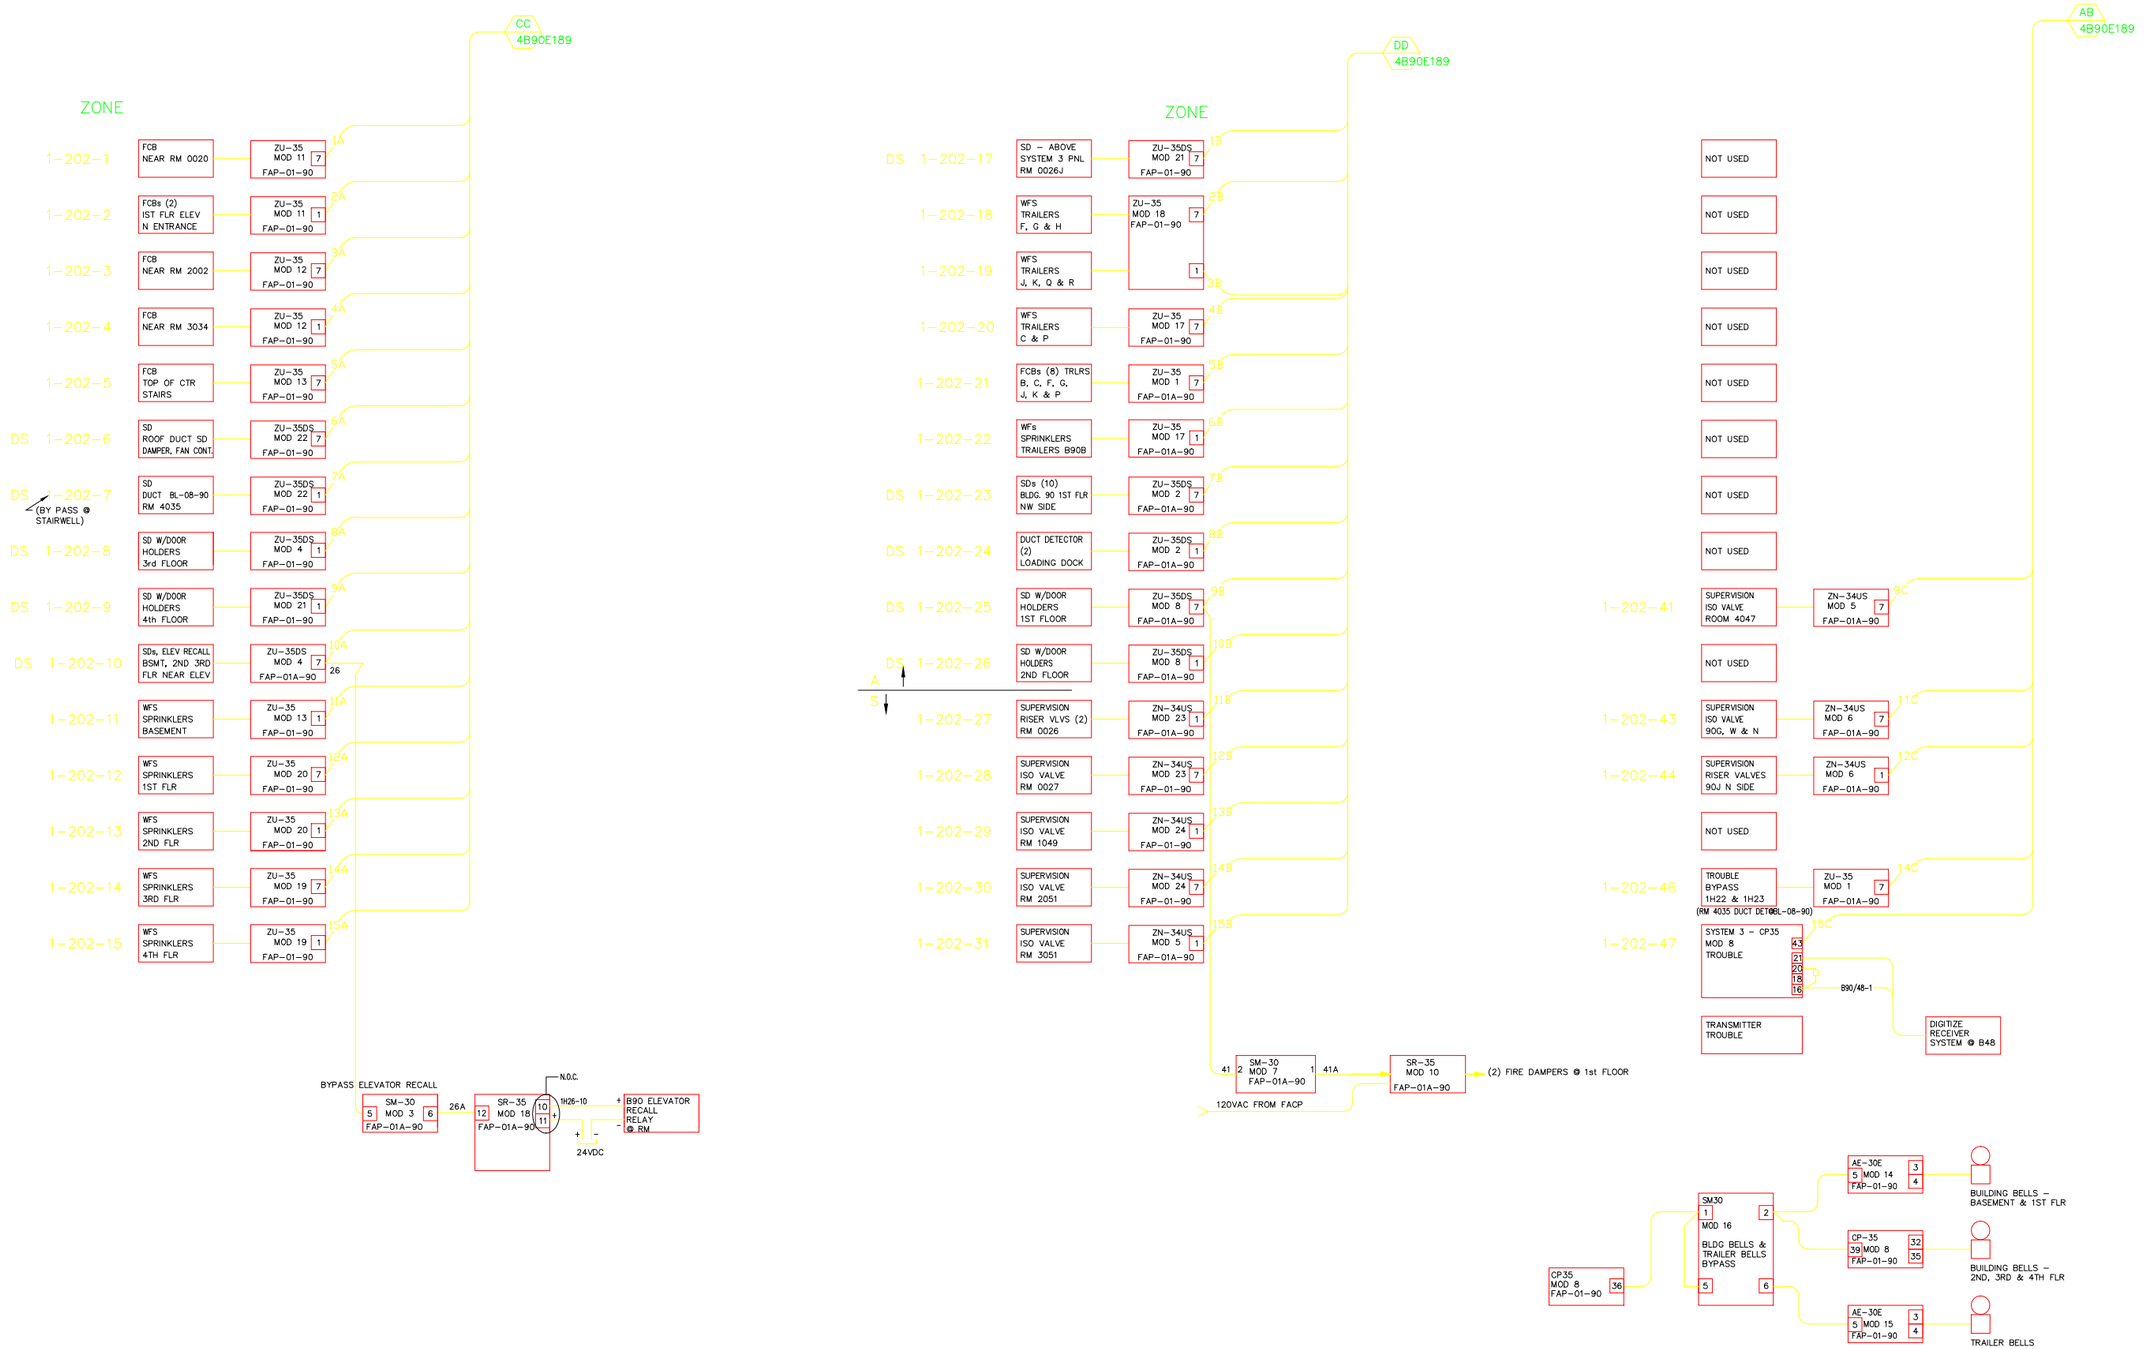

REVISION NUMBER	DRAWN BY	CHECKED BY	APPR'D BY	DATE	REMARKS
I	DSV	LDD	MCG	6/20/13	AS BUILT PER FIELD VERIFICATION
H				9/30/08	AS BUILT
G	LDD	MCG	MCG	5/27/05	PHASE III FA SYS UPGRADE- REV LETTER CHANGE ONLY
F	MRC	AD	MCG	3/21/05	PHASE III FIRE ALARM SYSTEM UPGRADE
E	VDA	MCG	MCG	4/22/02	AS BUILT (#WB3793)
D	VDA	MCG	MCG	2/5/02	ADDED SMOKE DETECTORS TO ZONE IH33 (#WB3793)
C	LM		MCG	6/27/97	AS BUILT - FIRE & LIFE SAFETY PROJECT.

90 FIRE ALARM
TRANSMETER 144 & 145
LOGIC DIAGRAM

UNIVERSITY OF CALIFORNIA LAWRENCE BERKELEY LABORATORY
FACILITIES DEPARTMENT

DRAWN BY LSR	DATE 8/23/1994	
CHECKED BY SL	8/26/1994	
APPROVED BY ROB	8/26/1994	
CAD FILE PATH		
SCALE As Noted		
DRAWING NO. 4B90E101I	SHEET E1	
PROJECT NO. FB4010	1 OF 1	