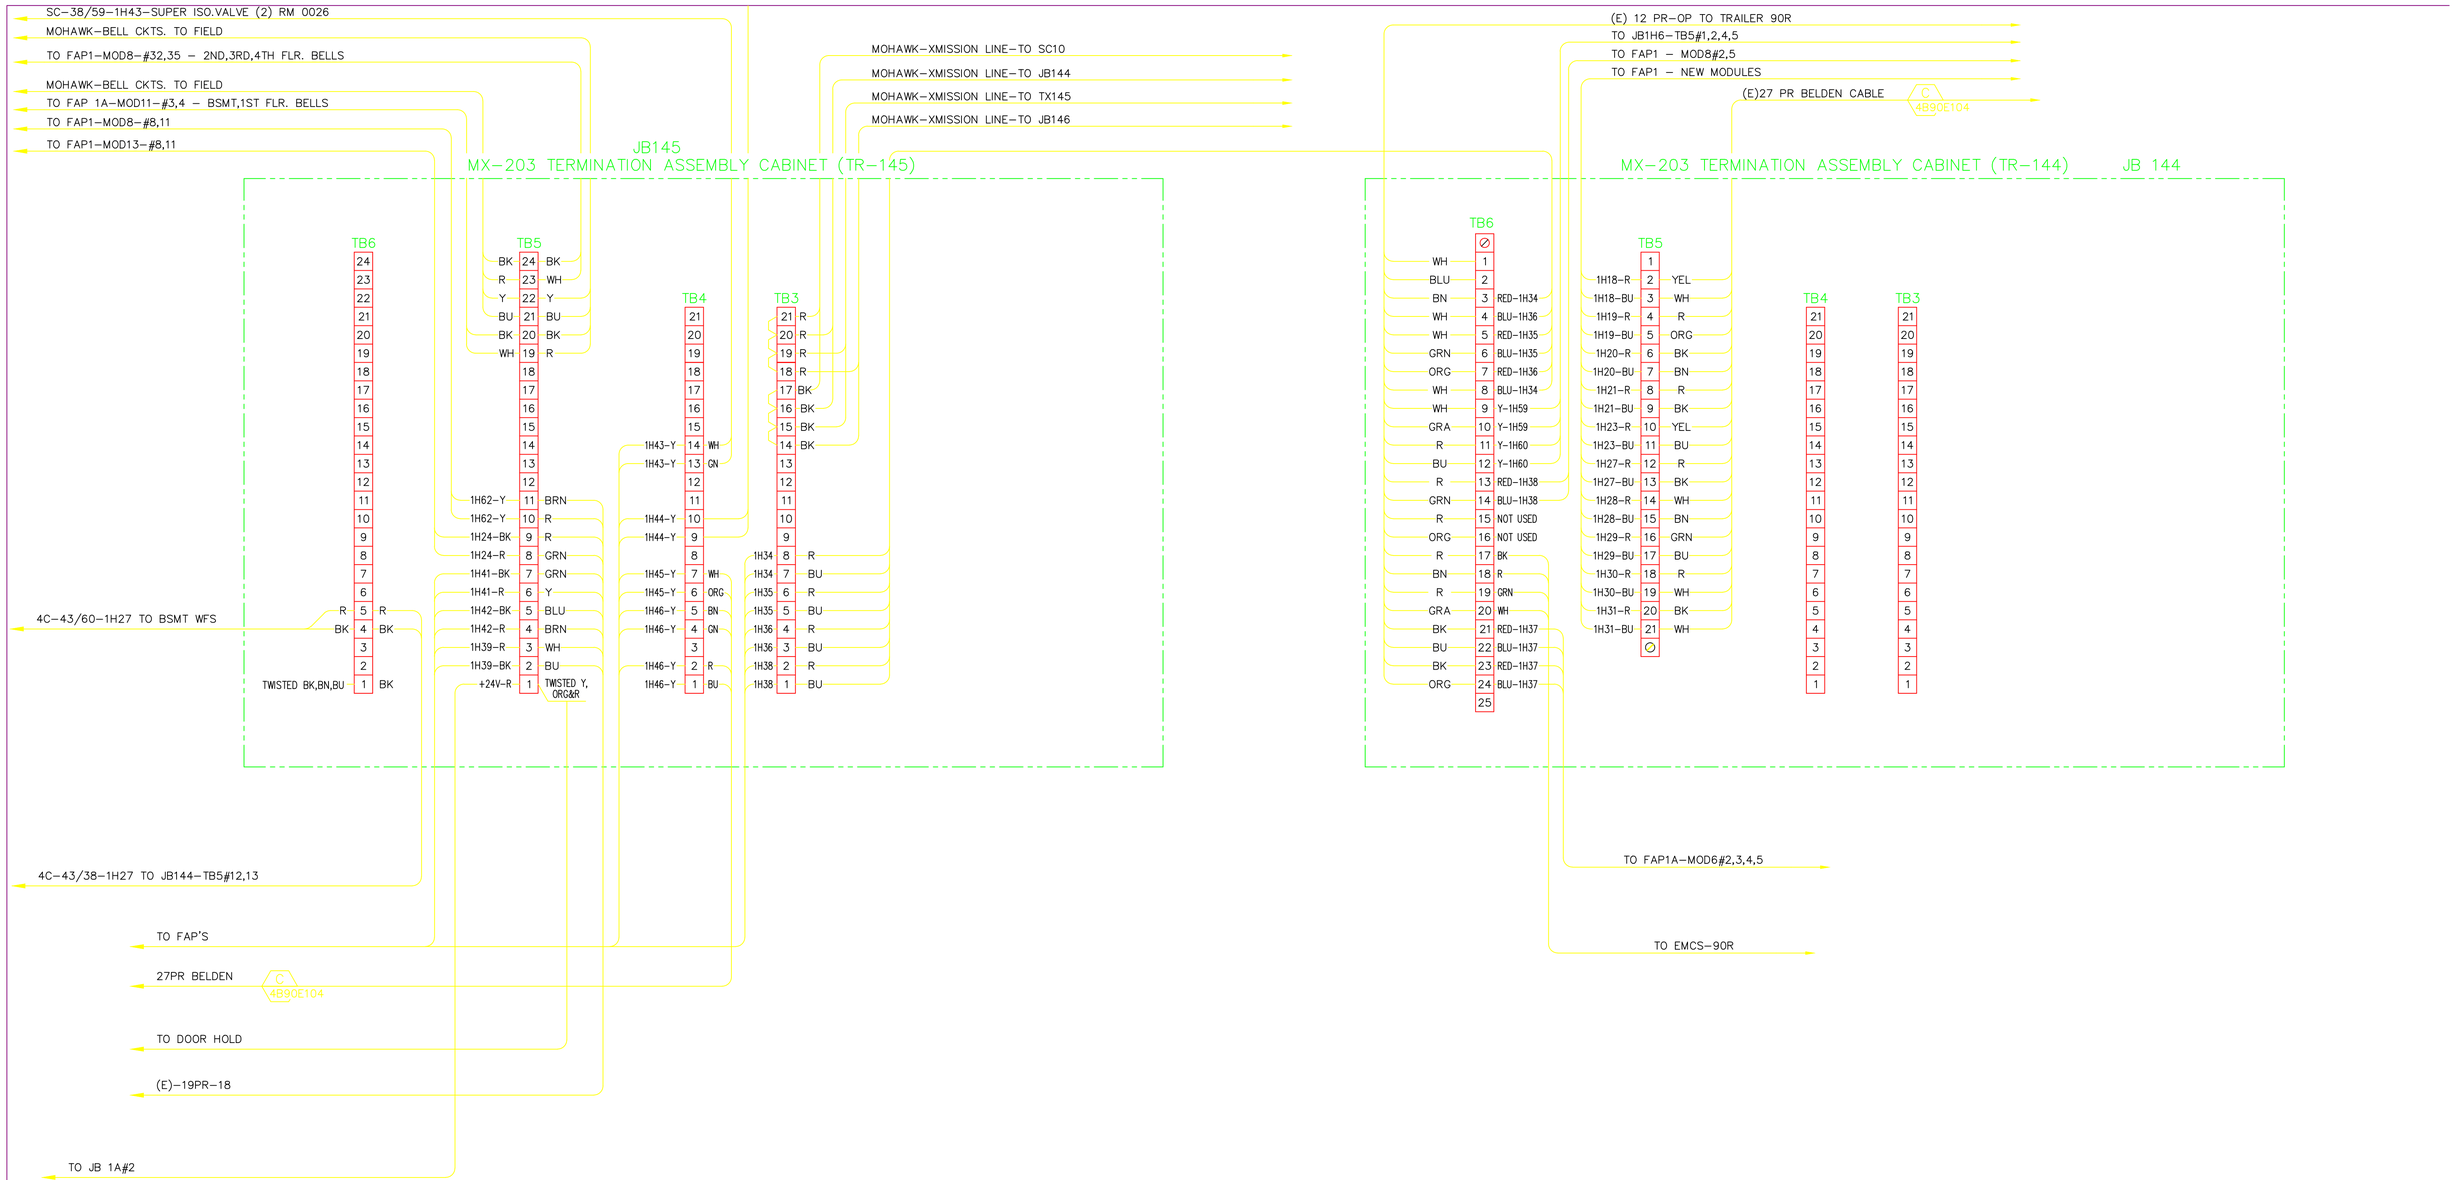

REVISION NUMBER	DRAWN BY	CHECKED BY	APPR'D BY	DATE	REMARKS
H				5/15/09	AS BUILT
G				9/30/08	AS BUILT
F	MRC	AD	MCG	8/17/04	PHASE III FIRE ALARM SYSTEM UPGRADE
E	VDA	MCG	MCG	4/22/02	AS BUILT (#WB3793)
D	VDA	MCG	MCG	02/12/02	ADDED SMOKE DET's RM002A&B 1H33 (#WB3793)
C	LM		MCG	07/25/97	AS BUILT - FIRE & LIFE SAFETY PROJECT.
B	RZT	MCG	MCG	09/18/95	REPLACED SPLICES WITH TERMINATIONS, REVISED FOR ZONE 1H24, 25, 41, & 42. FIRE & LIFE SAFETY PROJECT.

90 FIRE ALARM
MX-203 TR-144 & TR 145
INTERCONNECTION DIAGRAM

UNIVERSITY OF CALIFORNIA LAWRENCE BERKELEY LABORATORY
FACILITIES DEPARTMENT

DRAWN BY	LSR	DATE 8/23
CHECKED BY	SL	8/26
APPROVED BY	ROB	8/26
CAD FILE PATH	00017837	
SCALE	As Noted	
DRAWING NO.	4B90E102H	SH
PROJECT NO.	FB4010	1 OF