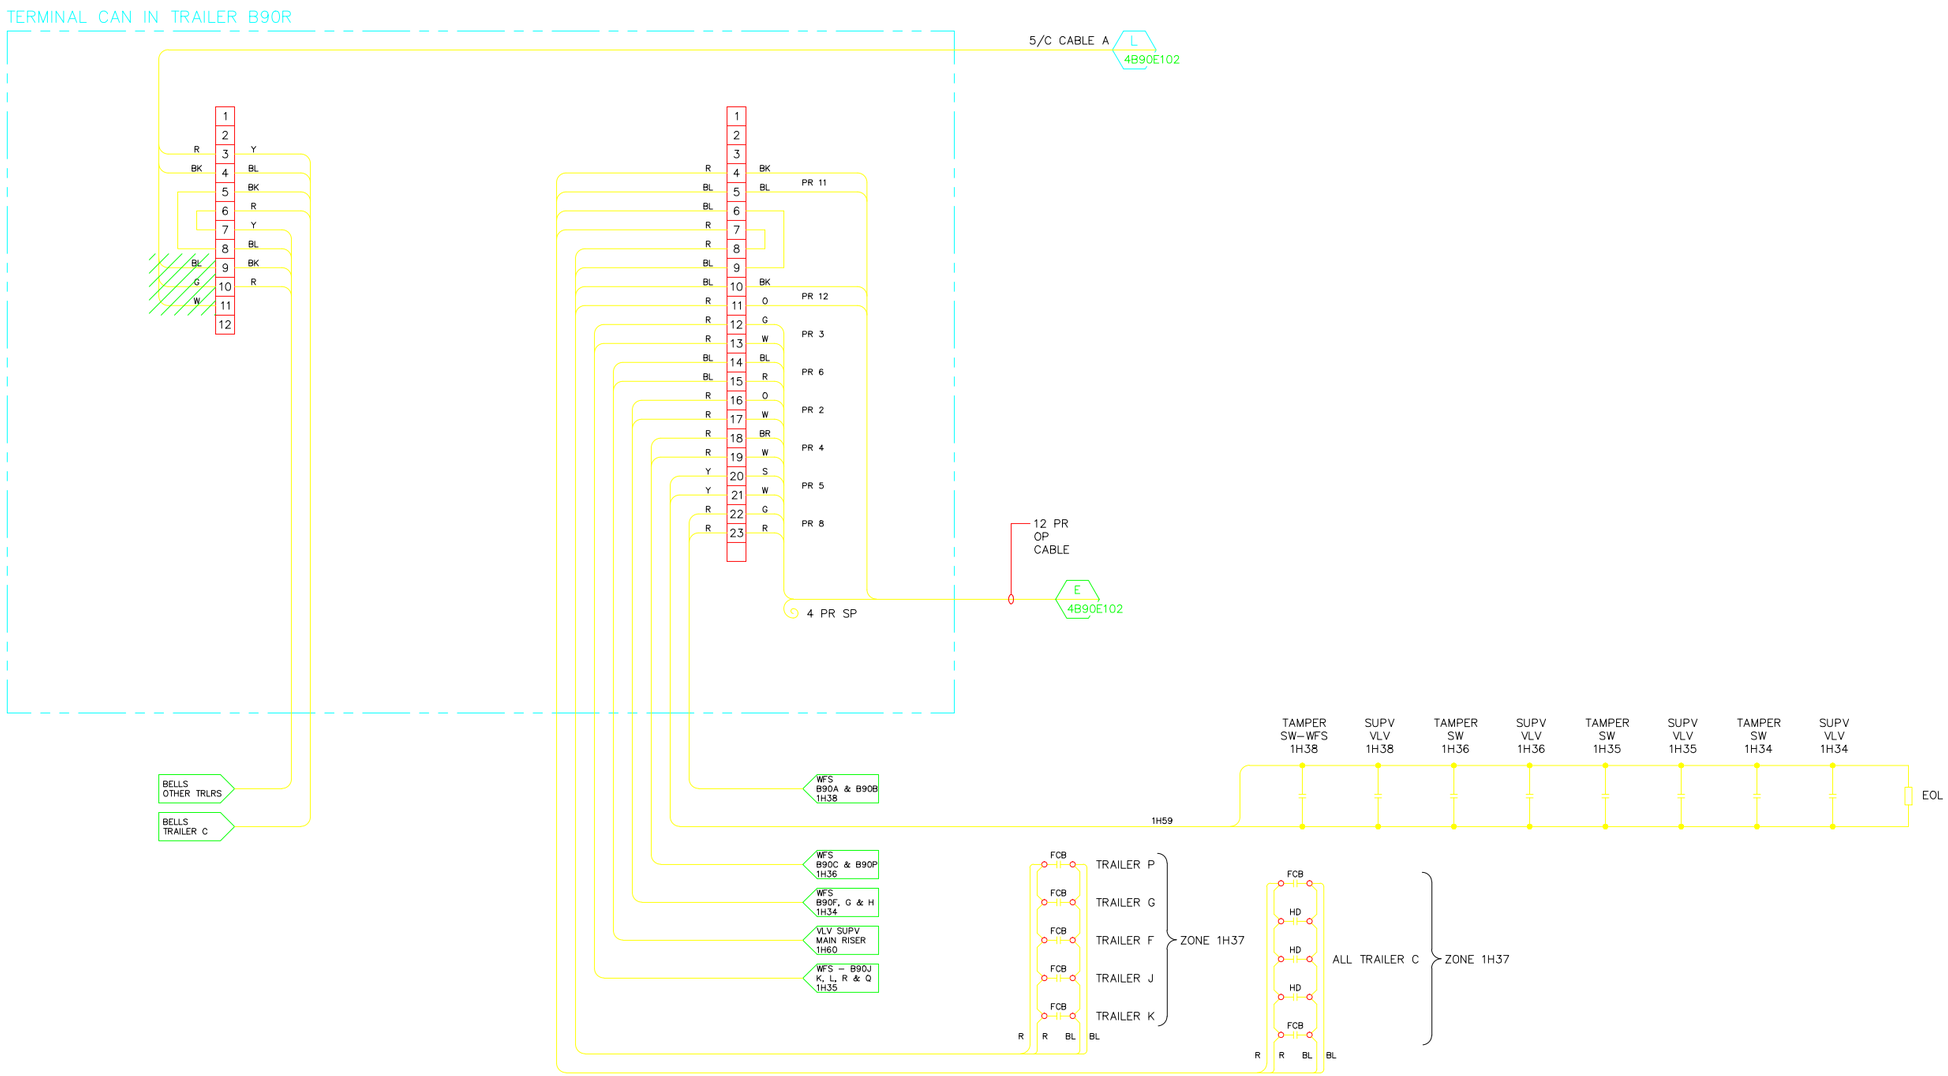

REVISION NUMBER	DRAWN BY	CHECKED BY	APPR'D BY	DATE	REMARKS
C				5/15/09	AS BUILT
B				9/30/08	AS BUILT
A	RZT	MCG	MCG	3/21/05	REVISED FOR PHASE III UPGRADE PROJECT.

90 FIRE ALARM
TRAILER DEVICES
INTERCONNECTION DIAGRAM

UNIVERSITY OF CALIFORNIA LAWRENCE BERKELEY LABORATORY
FACILITIES DEPARTMENT

DRAWN BY	RZT	DATE 3/21/20
CHECKED BY	MCG	3/21/20
APPROVED BY	MCG	3/21/20
CAD FILE PATH	00002263	
SCALE	As Noted	
DRAWING NO.	4B90E105C	SHEET E5
PROJECT NO.	761383	1 OF1