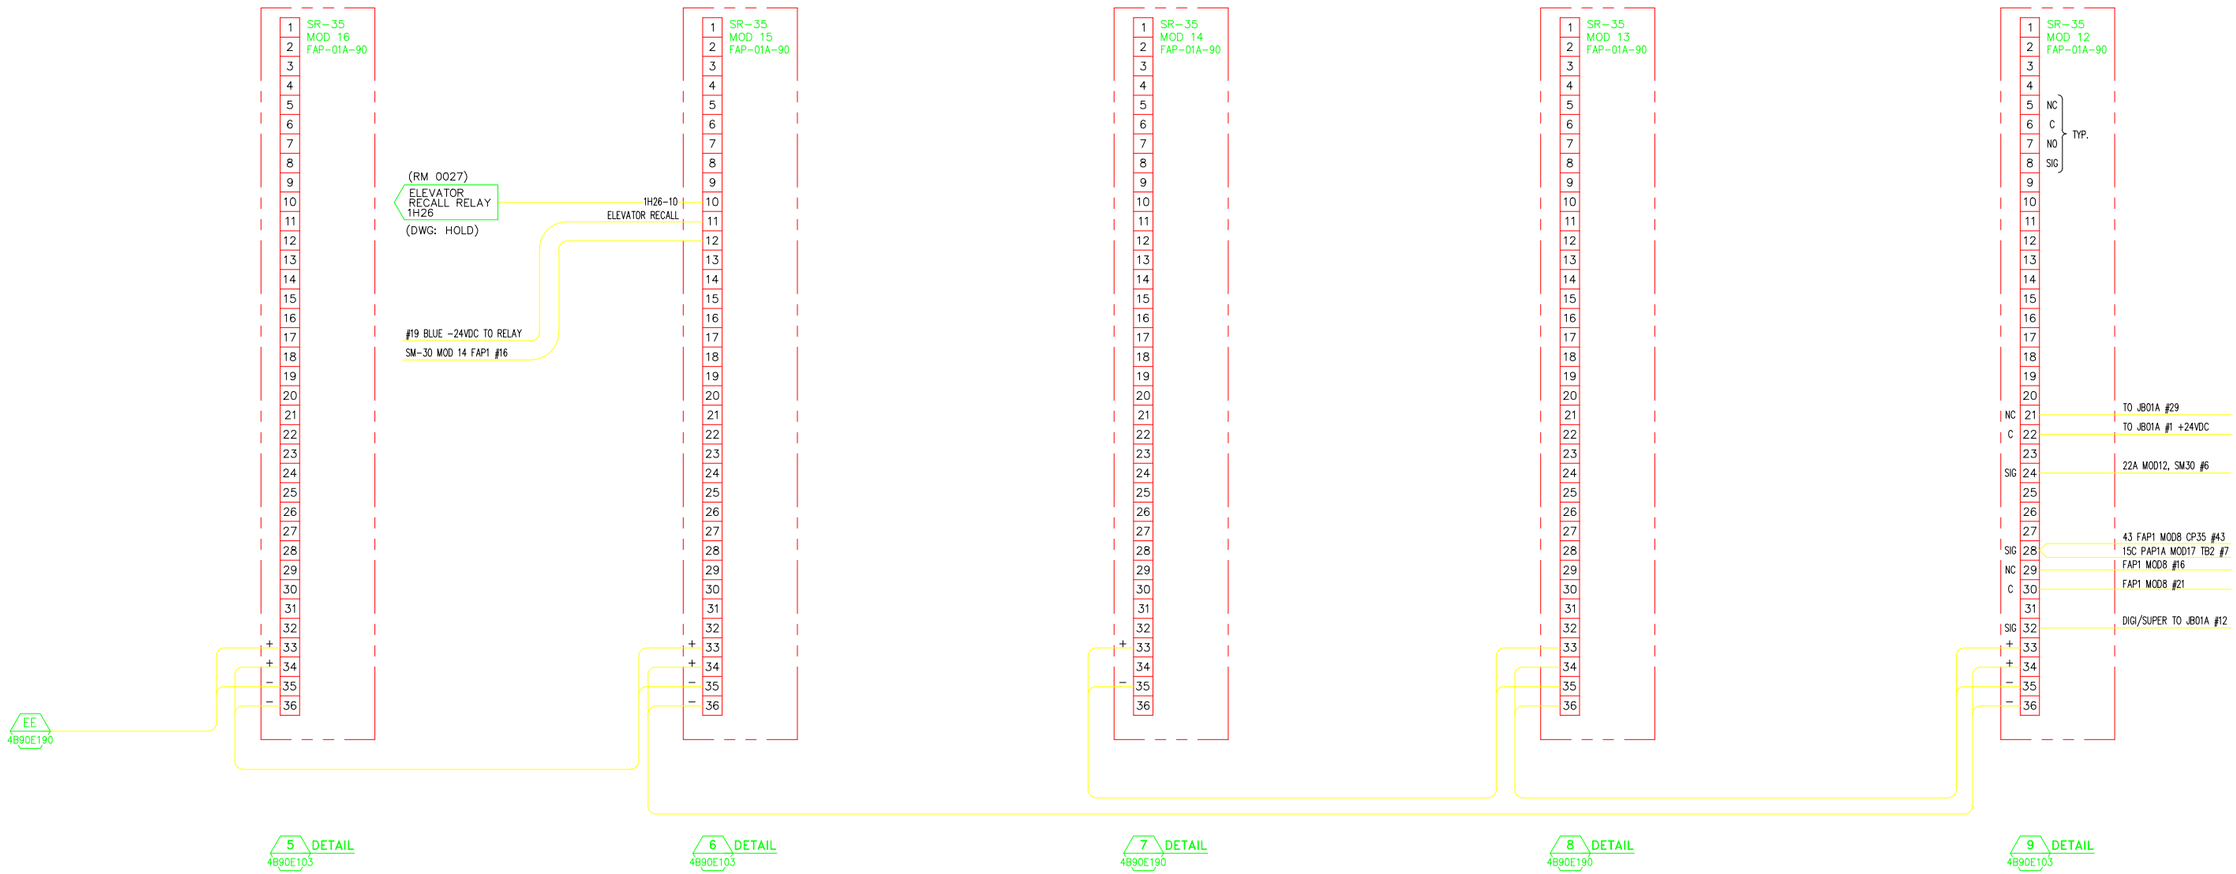

DISTRIBUTION LIST:

2-ELECTRIC SHOP B76 (FILE I & II)
1-B90J (FILE III)
1-STICK FILE B90J
ORIGINAL-FLAT FILE B90F

AS BUILT
REVISION
B
05/15/2009

REVISION NUMBER	DRAWN BY	CHECKED BY	APPR'D BY	DATE	REMARKS
B				5/15/09	AS BUILT
A				9/30/08	AS BUILT

PROFESSIONAL SEAL (IF REVISION, APPLIES ONLY TO REVISED WORK)

ISSUE (PROGRESS, ESTIMATE, BID, CONSTRUCTION, CONFORMED, REVISION, RECORD)

90 FIRE ALARM
SR-35 RELAYS
INTERCONNECTION DIAGRAM

UNIVERSITY OF CALIFORNIA
LAWRENCE BERKELEY NATIONAL LABORATORY
FACILITIES DIVISION

DRAWN BY	AD	DATE 5/17/200
CHECKED BY	AD	5/17/200
APPROVED BY	MCG	5/17/200
CAD FILE PATH	00017818	
SCALE	Full	
DRAWING NO.	4B90E188B	SHEET
PROJECT NO.	FB4010	1 OF 1