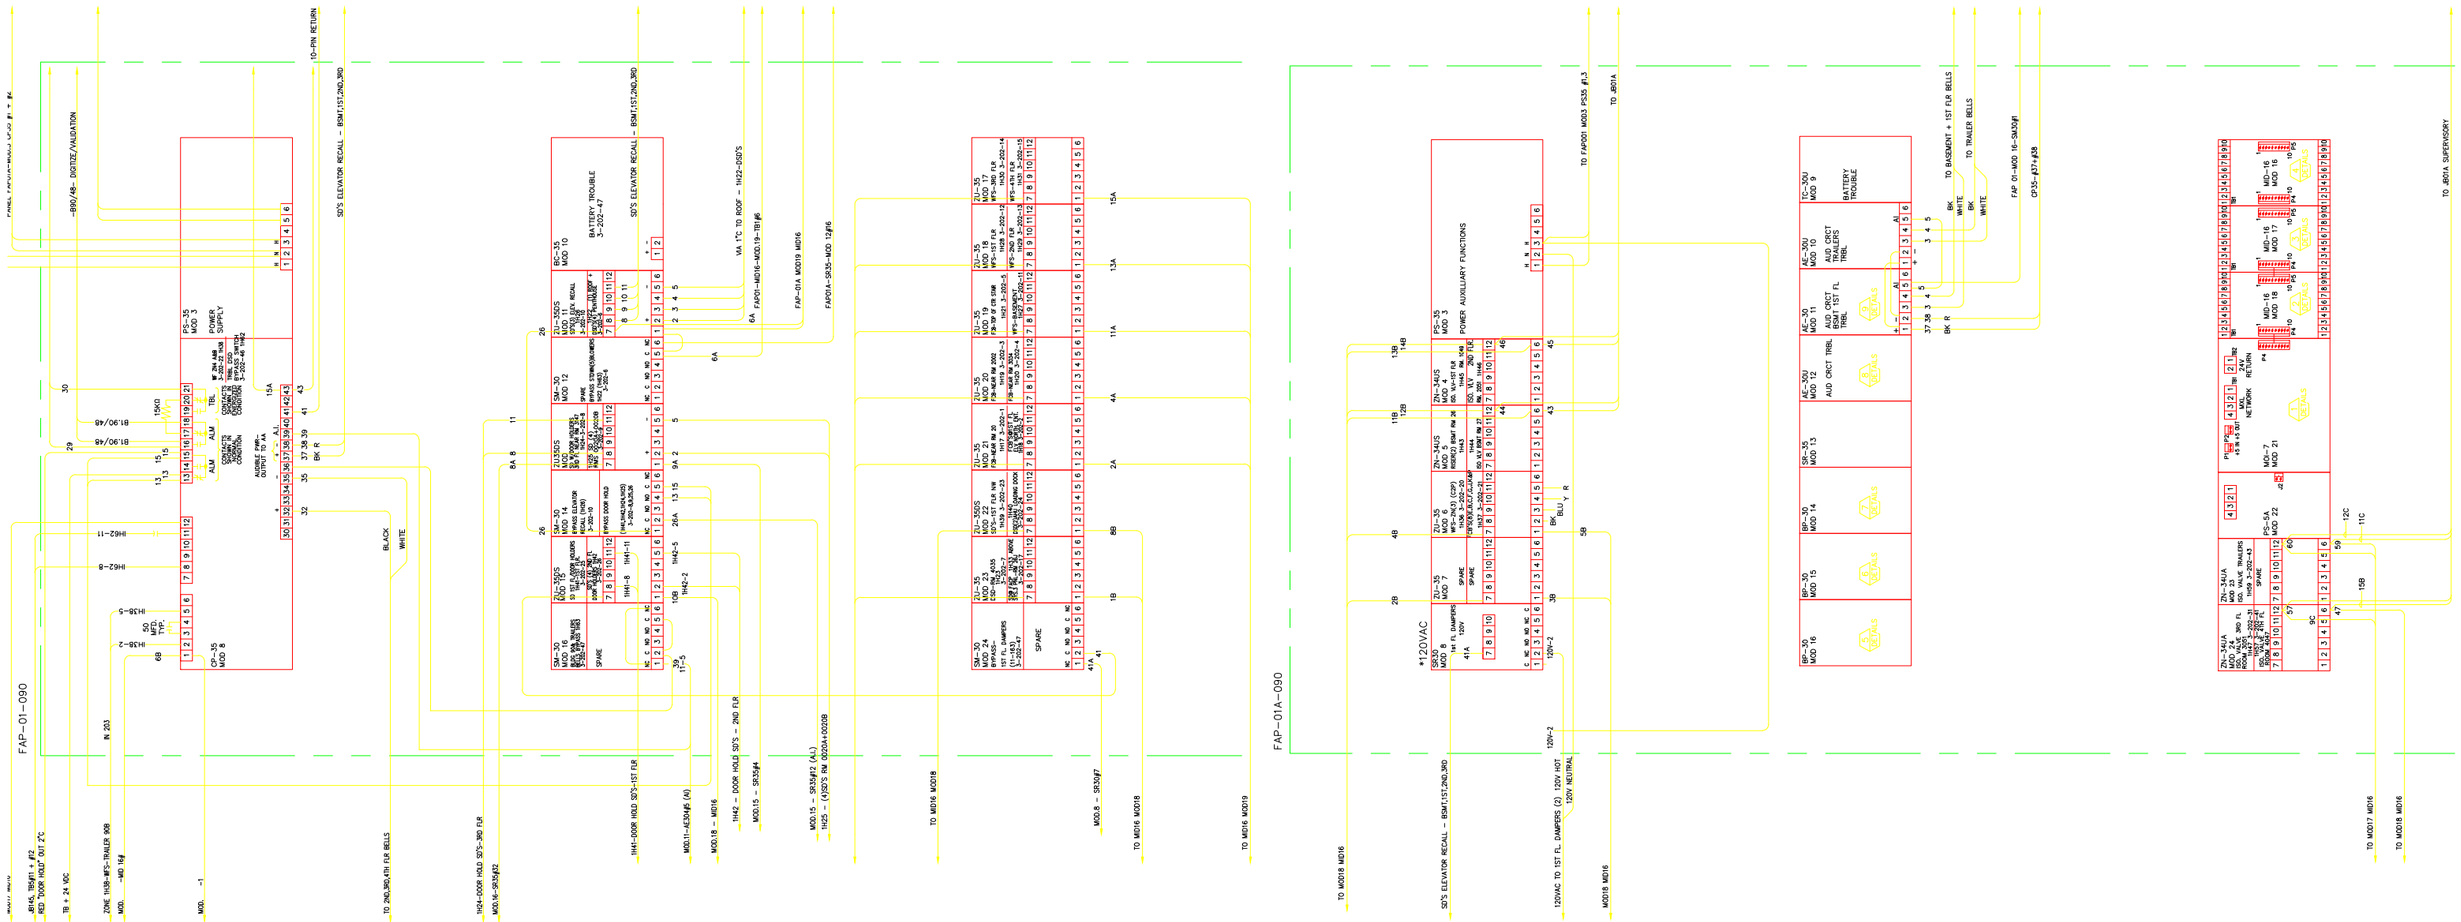

PROFESSIONAL SEAL (IF REVISION, APPLIES ONLY TO REVISED WORK)	ISSUE (PROGRESS, ESTIMATE, BID, CONSTRUCTION, CONFORMED, REVISION, RECORD)	REVISION NUMBER	DRAWN BY	CHECKED BY	APPR'D BY	DATE	REMARKS
	AS BUILT C 6/20/13	C	DSV	LDD	MCD	6/20/13	AS BUILT PER FIELD VERIFICATION
		B				5/15/09	AS BUILT
		A				9/30/08	AS BUILT

90 FAP-01-01A-90

FIRE ALARM SYSTEM

SYSTEM 3 WIRING DIAGRAM

UNIVERSITY OF CALIFORNIA
LAWRENCE BERKELEY NATIONAL LABORATORY
FACILITIES DIVISION

DRAWN BY	MRS	DATE 5/21/20C
CHECKED BY	AD	5/21/20C
APPROVED BY	MCG	5/21/20C
CAD FILE PATH		
SCALE	FULL	
DRAWING NO.	4B90E190C	SHEET FA
PROJECT NO.	FB4010	