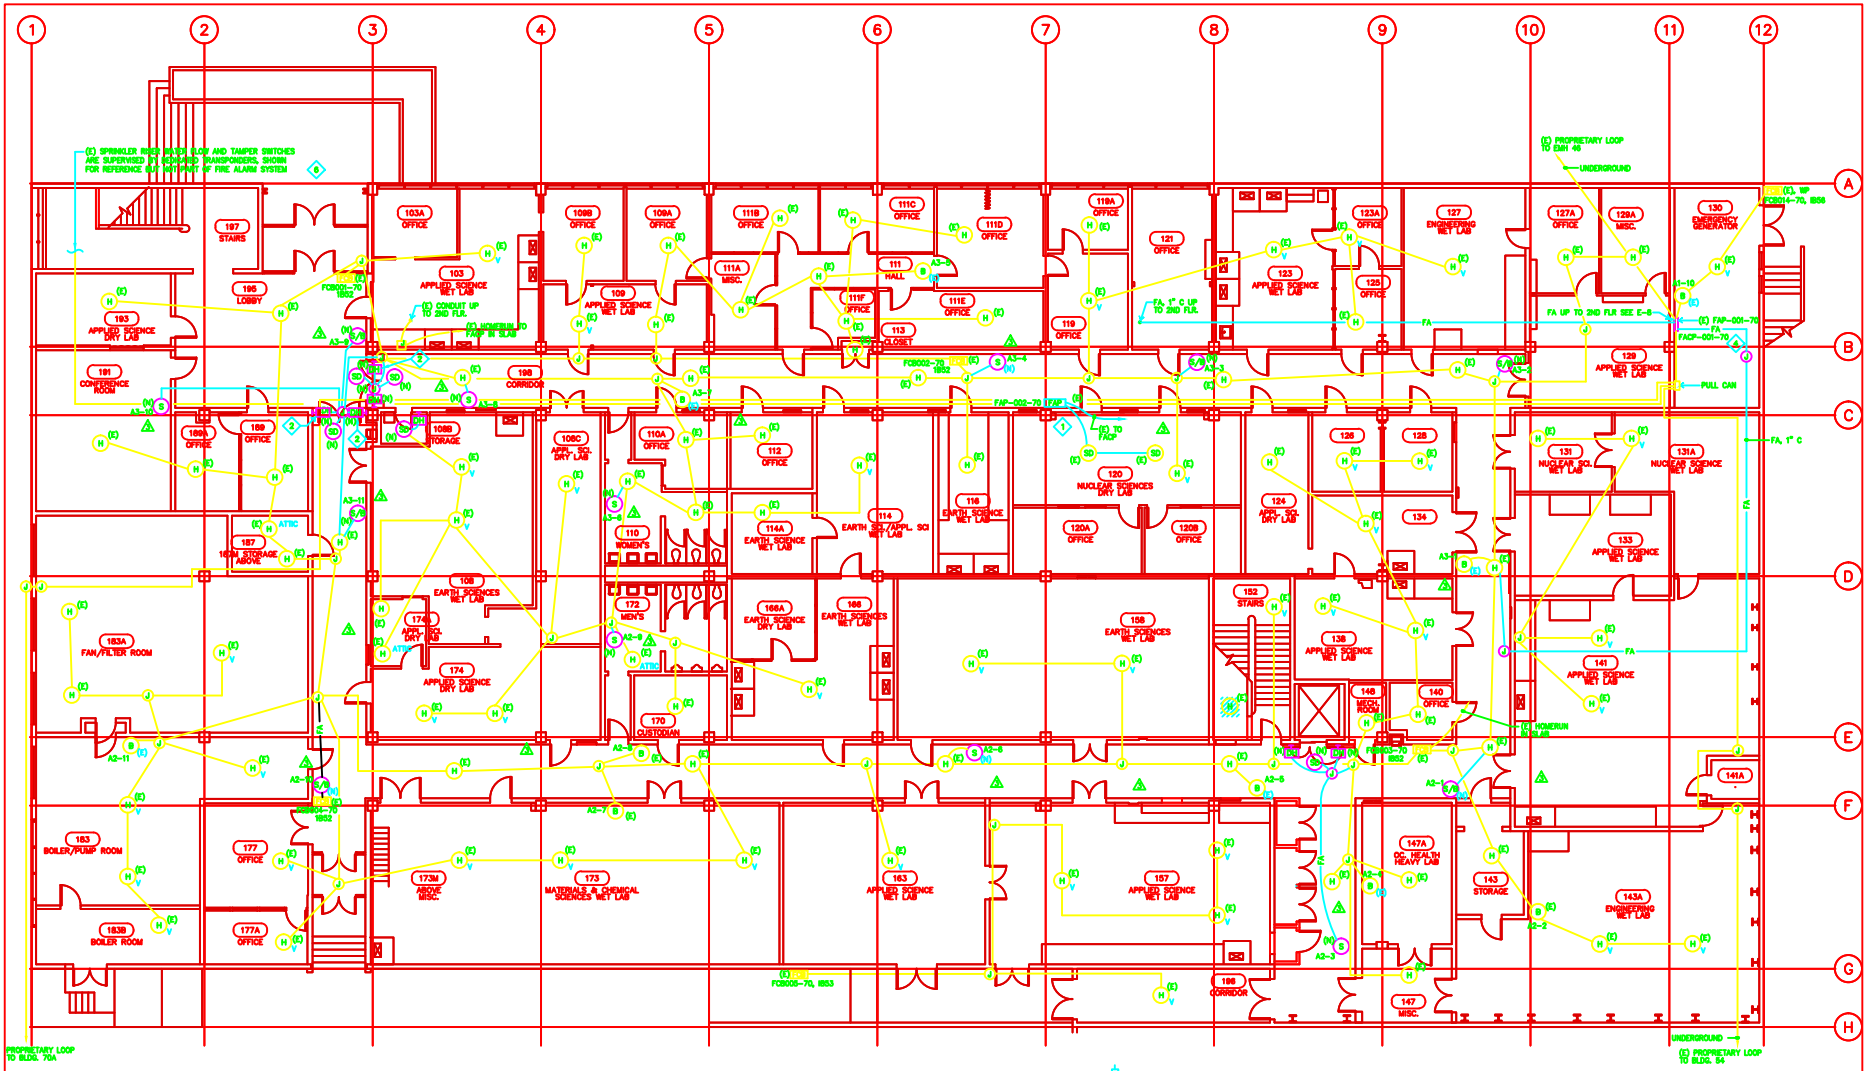

NOTES

1. (E) PYRALARM FAP-002-70 & LIGHT
2. FOUR (4) DOOR HOLDERS AT LOBBY 195 ARE FLOOR MOUNTED, ALL OTHERS ARE RECESSED IN WALL (TYP.)
3. MINIMUM CONDUIT TRADE SIZE IS 1 INCH
4. FOR FIRE ALARM RISER DIAGRAM, REFER TO EXISTING FIRE ALARM PANEL TO BE REPLACED SEE SHEET E-19
5. (E) DEVICES AND CONDUIT SHOWN LIGHTLY. NEW DEVICES AND CONDUIT SHOWN HEAVILY
6. (E) SPRINKLER RISER FLOW / TAMPER SWITCH SUPERVISION AT FIRST FLOOR:
   A) SUP-1859, WF-1849 B) WFS-001-70, A-1849, S-1859

FIRST FLOOR FIRE ALARM PLAN

1/8"=1'

GEZ ARCHITECTS ENGINEERS
[illegible] Montgomery Street, Suite 200
San Francisco, California 94104
TEL 415/ 391-3383 FAX 415/ 391-3383

REVISION NO.	DRAWN BY	DESIGNED BY	REVIEWED BY	APPROVED BY	DATE	REMARKS
4	CC	ASH	KKM	KKM	10/31/95	RECORD DRAWING
3	CC	ASH	KKM	KKM	2/1/95	ISSUED FOR CONSTRUCTION (REVISED)
2	HJ	ASH	KKM	KKM	1/3/95	ISSUED FOR CONSTRUCTION
	HJ	ASH	KKM	KKM	12/12/94	FIRE ALARM PACKAGE

BLDG. 70
HAZARDOUS MATERIALS SAFEGUARDS
FIRST FLOOR FIRE ALARM PLAN

UNIVERSITY OF CALIFORNIA LAWRENCE BERKELEY LABORATORY
FACILITIES DEPARTMENT

DRAWN BY	HJ
DATE	12/12/94
CHECKED BY	ASH
APPROVED BY	KKM
CAD FILE NO.	E-16
	2805
SCALE	1/8"=1'
DRAWING NO.	4B70E116A
SHEET	E-16
PROJECT NO.	90729
	48-52