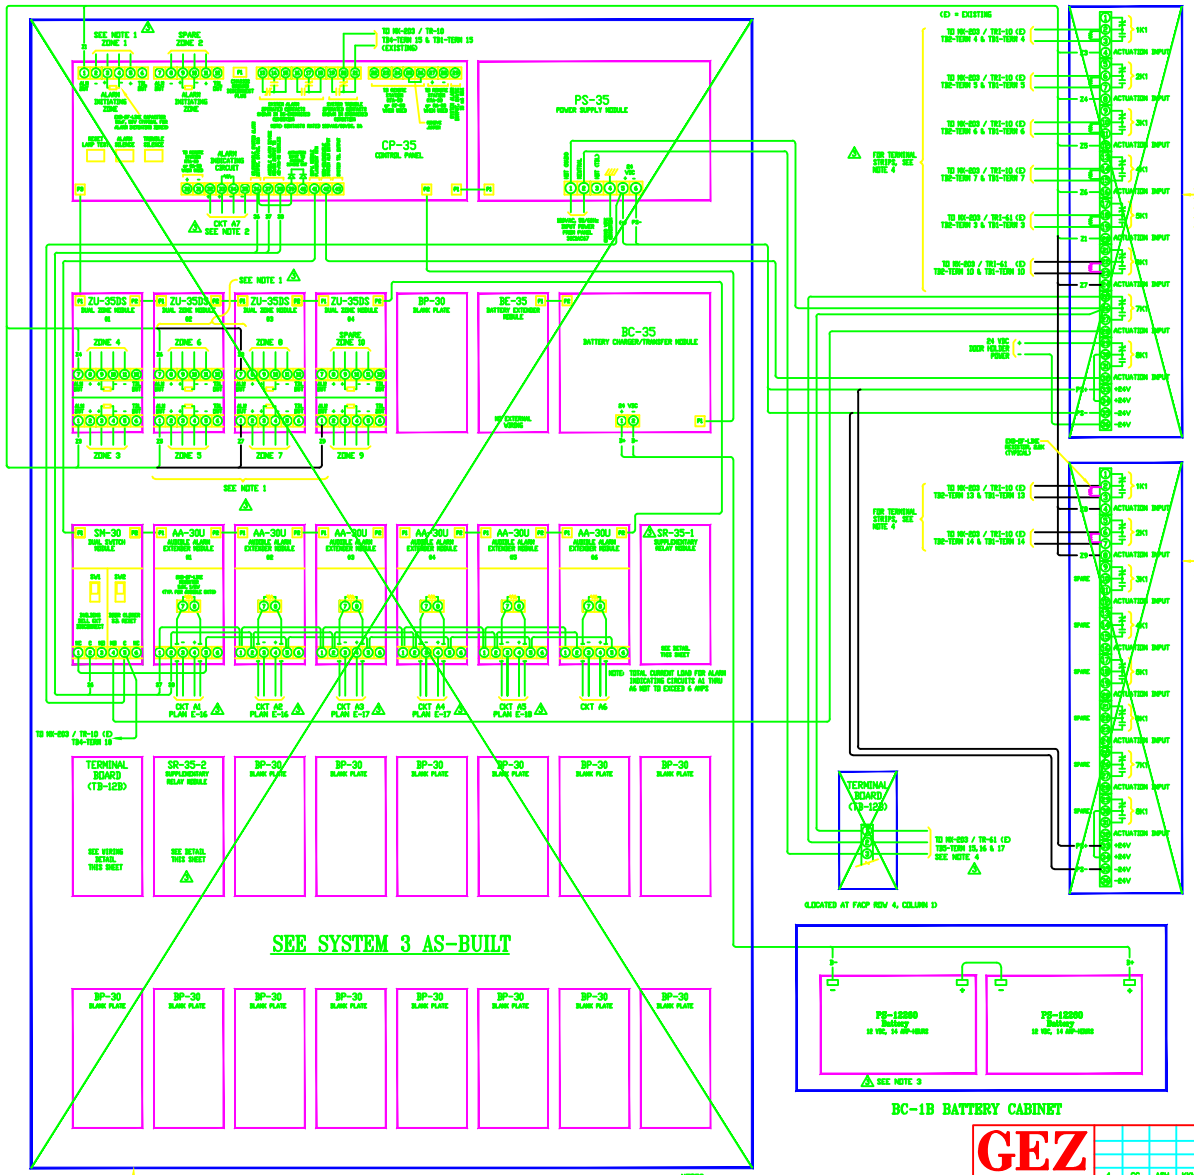

EA-35 ENCLOSURE
Consisting of:
EB-35 BACKBOX
EP-35 DOOR ASSY
EA-35 RAIL/BRACKET KIT

WIRING DIAGRAM
SYSTEM 3 FIRE ALARM CONTROL PANEL

NOTES:
1. SEE SHEET SYSTEM 3 AS-BUILT.
2. SEE SHEET E-15 FOR ALARM INDICATING CIRCUITS.
3. SEE SHEET E-15 FOR BATTERY SIZING CALCS.
4. REFERENCE UCLBL DWG. 4B70E0390.

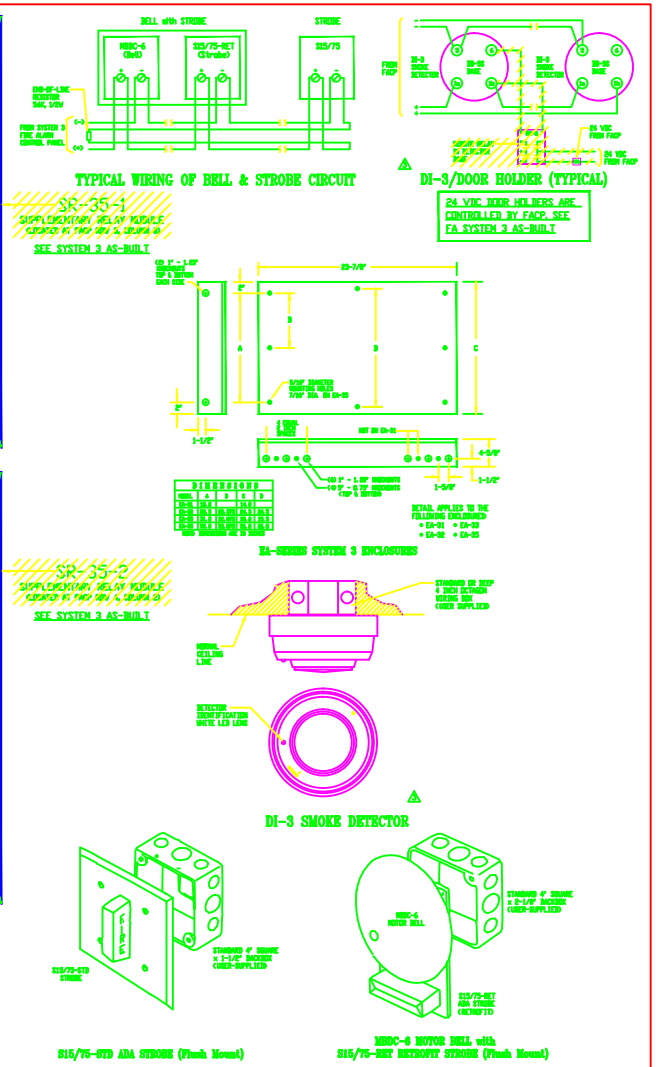

TYPICAL MOUNTING DETAILS
FIRE ALARM EQUIPMENT/DEVICES

GEZ ARCHITECTS ENGINEERS
150 Montgomery Street, Suite 800
San Francisco, California 94104
TEL 415/ 394-3000 FAX 415/ 394-3000

REVISION NUMBER	DRAWN BY	CHECKED BY	APPR'D BY	DATE	REMARKS
4	CC	ASH	KKM	10/31/94	RECORD DRAWING
3	CC	ASH	KKM	2/1/95	ISSUED FOR CONSTRUCTION (REVISED)
2	HJ	ASH	KKM	1/3/95	ISSUED FOR CONSTRUCTION
	KT	ASH	KKM	12/12/94	FIRE ALARM PACKAGE

BLDG. 70
HAZARDOUS MATERIAL SAFEGUARDS
FIRE ALARM WIRING DIAGRAM
AND ENCLOSURE DETAILS

UNIVERSITY OF CALIFORNIA LAWRENCE BERKELEY LABORATORY
FACILITIES DEPARTMENT

DRAWN BY	KT	DATE	12/12/94
CHECKED BY	ASH		
APPROVED BY	KKM		
CAD FILE NO.	E-20		2810
SCALE	AS NOTED		
DRAWING NO.	4B70E120A	SHEET	E-20
PROJECT NO.	SC729		52-52