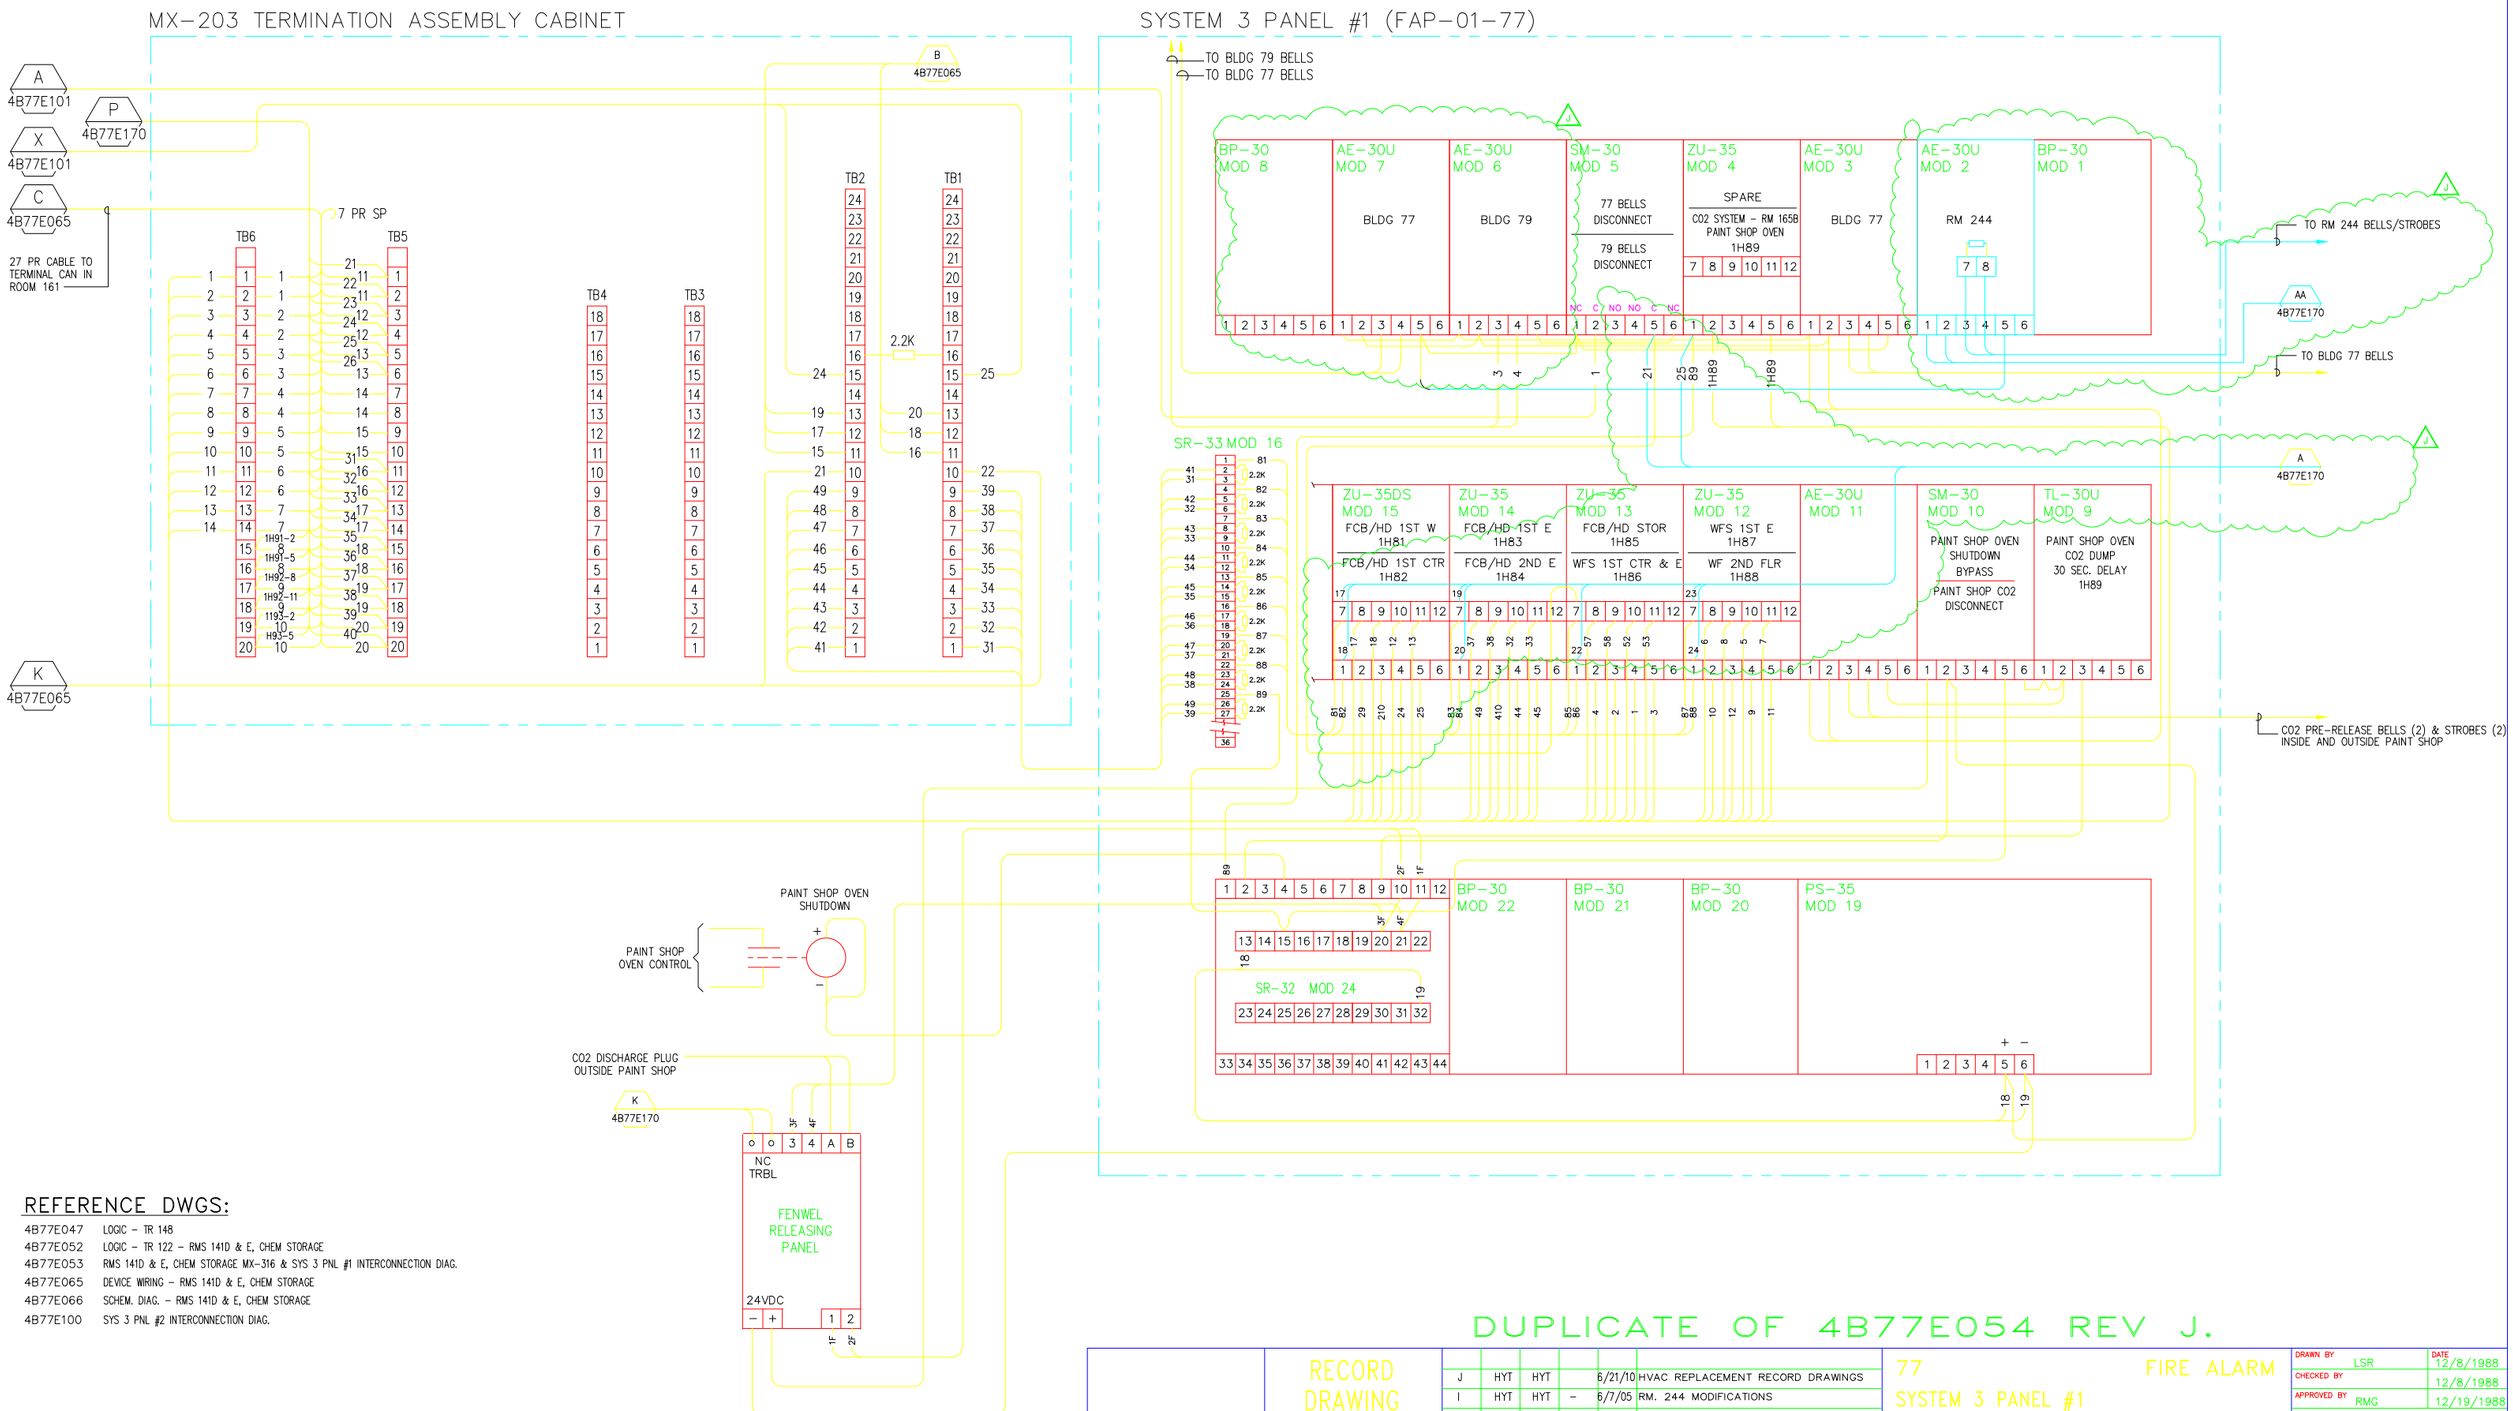

REFERENCE DWGS:

4B77E047	LOGIC - TR 148
4B77E052	LOGIC - TR 122 - RMS 141D & E, CHEM STORAGE
4B77E053	RMS 141D & E, CHEM STORAGE MX-316 & SYS 3 PNL #1 INTERCONNECTION DIAG.
4B77E065	DEVICE WIRING - RMS 141D & E, CHEM STORAGE
4B77E066	SCHEM. DIAG. - RMS 141D & E, CHEM STORAGE
4B77E100	SYS 3 PNL #2 INTERCONNECTION DIAG.

DUPLICATE OF 4B77E054 REV J.

RECORD DRAWING

06/21/10

REVISION NUMBER	DRAWN BY	CHECKED BY	APPR'D BY	DATE	REMARKS
J	HYT	HYT		6/21/10	HVAC REPLACEMENT RECORD DRAWINGS
I	HYT	HYT	-	6/7/05	RM. 244 MODIFICATIONS
H	AD	AD	MCG	1/12/04	AS-BUILT, PHASE II FIRE ALARM UPGRADE
G	MRC	MCG	MCG	3/29/02	REPLACEMENT FIRE ALARM PROJECT
F	HYT	HYT	-	3/29/02	REPLACEMENT FIRE ALARM PROJECT
D	LDD		MCG	12/6/99	77 REHAB MODS - PROJ FN9100

PROFESSIONAL SEAL (IF REVISION, APPLIES ONLY TO REVISED WORK)

ISSUE (PROGRESS, ESTIMATE, BID, CONSTRUCTION, CONFORMED, REVISION, RECORD)

77 FIRE ALARM

SYSTEM 3 PANEL #1

INTERCONNECTION DIAGRAM

UNIVERSITY OF CALIFORNIA
LAWRENCE BERKELEY NATIONAL LABORATORY
FACILITIES DIVISION

DRAWN BY	LSR	DATE 12/8/1988
CHECKED BY		12/8/1988
APPROVED BY	RMG	12/19/1988
CAD FILE PATH	00019728	
SCALE	As Noted	
DRAWING NO.	4N77E212	SHEET FA0.2
PROJECT NO.	FX4030	