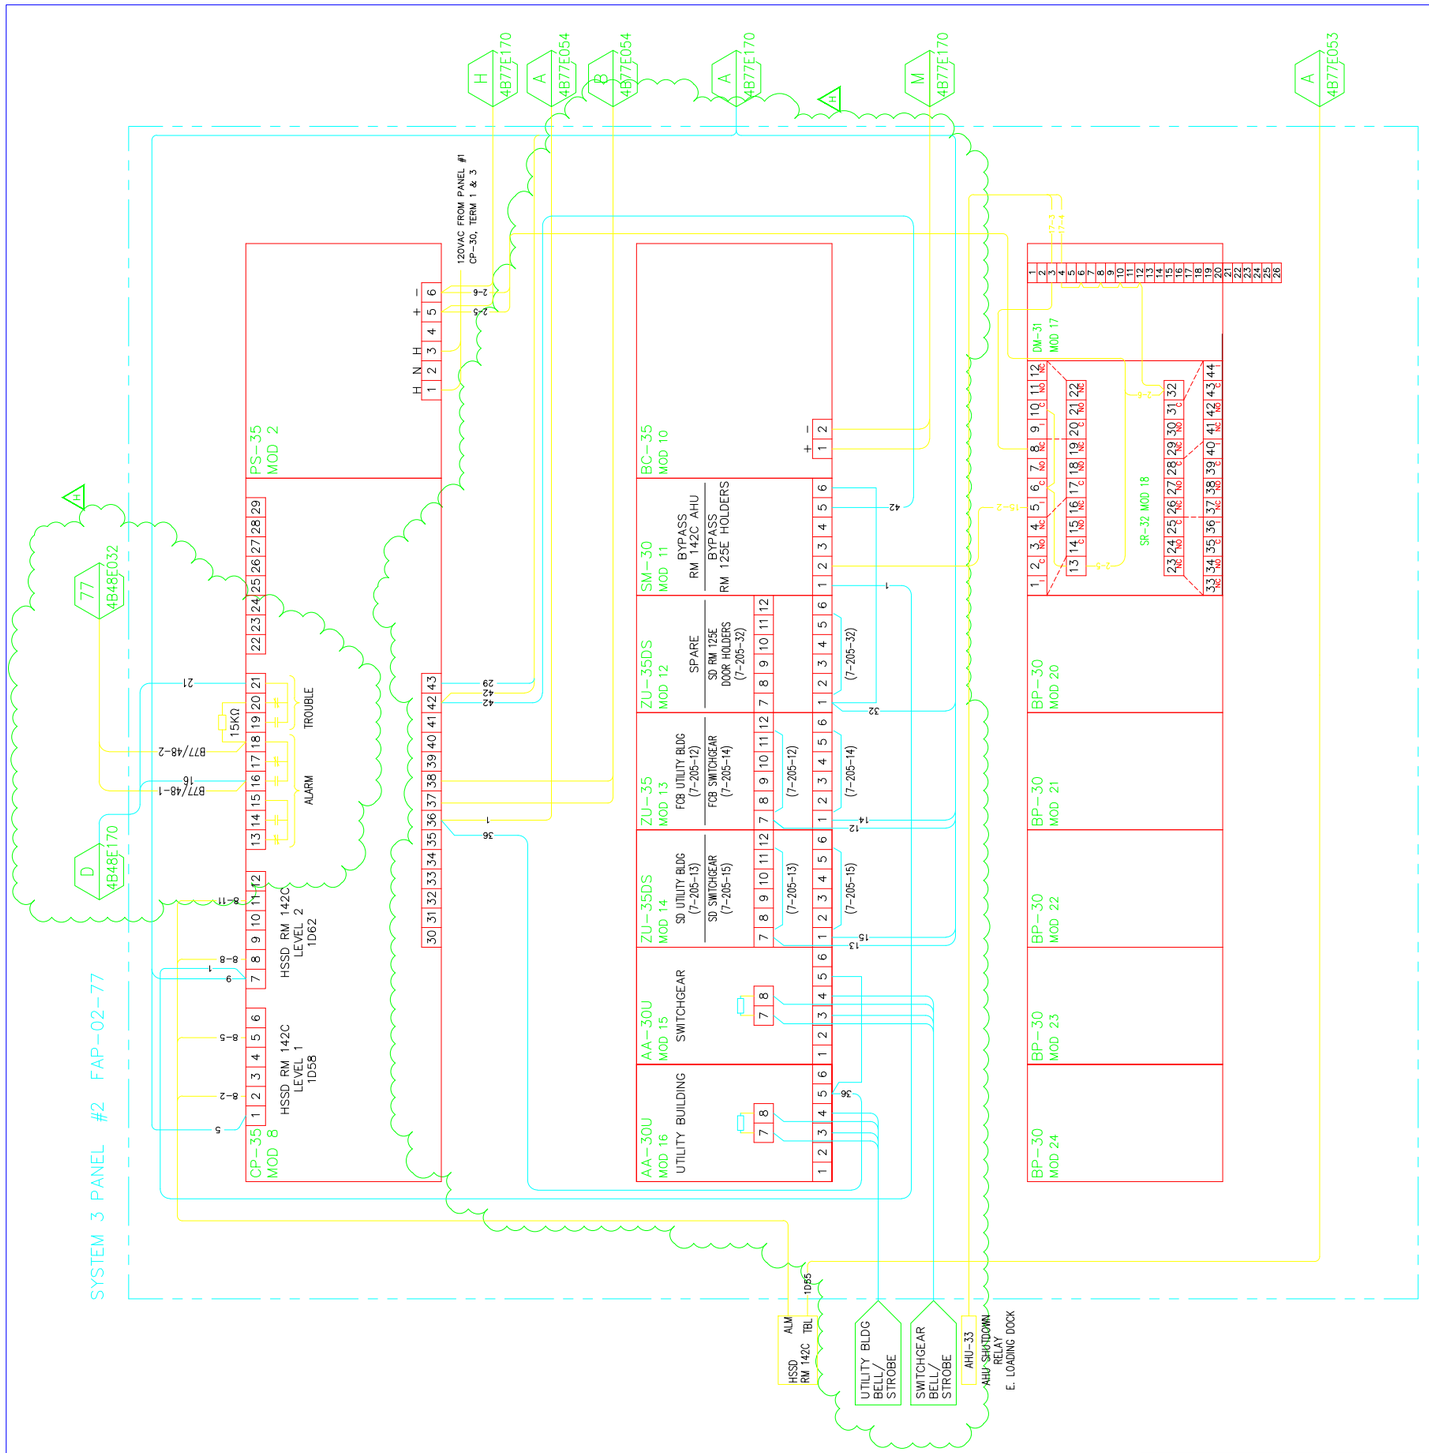

NOTES:

1. REMOVE BT-34 BATTERIES.
   CONNECT BC-35 TO NEW BATTERIES SHOWN ON DWG. 4B77E170.

REFERENCE DWGS:

4B77E047	LOGIC DIAG. - TR148
4B77E052	LOGIC DIAG. - TR 122 - RMS 141D & E, CHEM STORAGE
4B77E053	RMS 141D & E, CHEM STORAGE MX-316 & SYS 3 PNL #1 INTERCONNECTION DIAG.
4B77E054	MX-203 & SYS 3 PNL #1 INTERCONNECTION DIAG.
4B77E065	DEVICE WIRING - RMS 141D & E, CHEM STORAGE
4B77E066	SCHEM. DIAG. - RMS 141D & E, CHEM STORAGE
4B77E170	INTERCONNECTION DIAGRAM

DUPLICATE OF 4B77E101 REV. H

RECORD DRAWING

06/21/10

REVISION NUMBER	DRAWN BY	CHECKED BY	APPR'D BY	DATE	REMARKS
H	HYT	HYT	–	06/21/10	HVAC REPLCAEMENT PROJECT
G	RZT	MCG	MCG	4/27/05	REVISED FOR DIGITIZE SYSTEM
F	AD	AD	MCG	1/12/04	AS-BUILT, PHASE II FIRE ALARM UPGRADE
E	MRC	AD	MCG	8/8/03	PHASE II FIRE ALARM UPGRADE
D	HYT	HYT	–	3/29/02	REPLACEMENT FIRE ALARM PROJECT
C	HYT	HYT	–	3/29/02	REPLACEMENT FIRE ALARM PROJECT
B	LDD	LDD	MCG	9/5/01	142C CLEANROOM MODS – PROJ FM1100

PROFESSIONAL SEAL (IF REVISION, APPLIES ONLY TO REVISED WORK)

ISSUE (PROGRESS, ESTIMATE, BID, CONSTRUCTION, CONFORMED, REVISION, RECORD)

77 FIRE ALARM

SYSTEM 3 PANEL #2

INTERCONNECTION DIAGRAM

UNIVERSITY OF CALIFORNIA
LAWRENCE BERKELEY NATIONAL LABORATORY
FACILITIES DIVISION

DRAWN BY LDD	DATE 1/10/2000	
CHECKED BY LDD	1/10/2000	
APPROVED BY MCG	1/10/2000	
CAD FILE PATH 00019342		
SCALE As Noted		
DRAWING NO. 4N77E213	SHEET FA0.3	1 OF 1
PROJECT NO. FN9100		