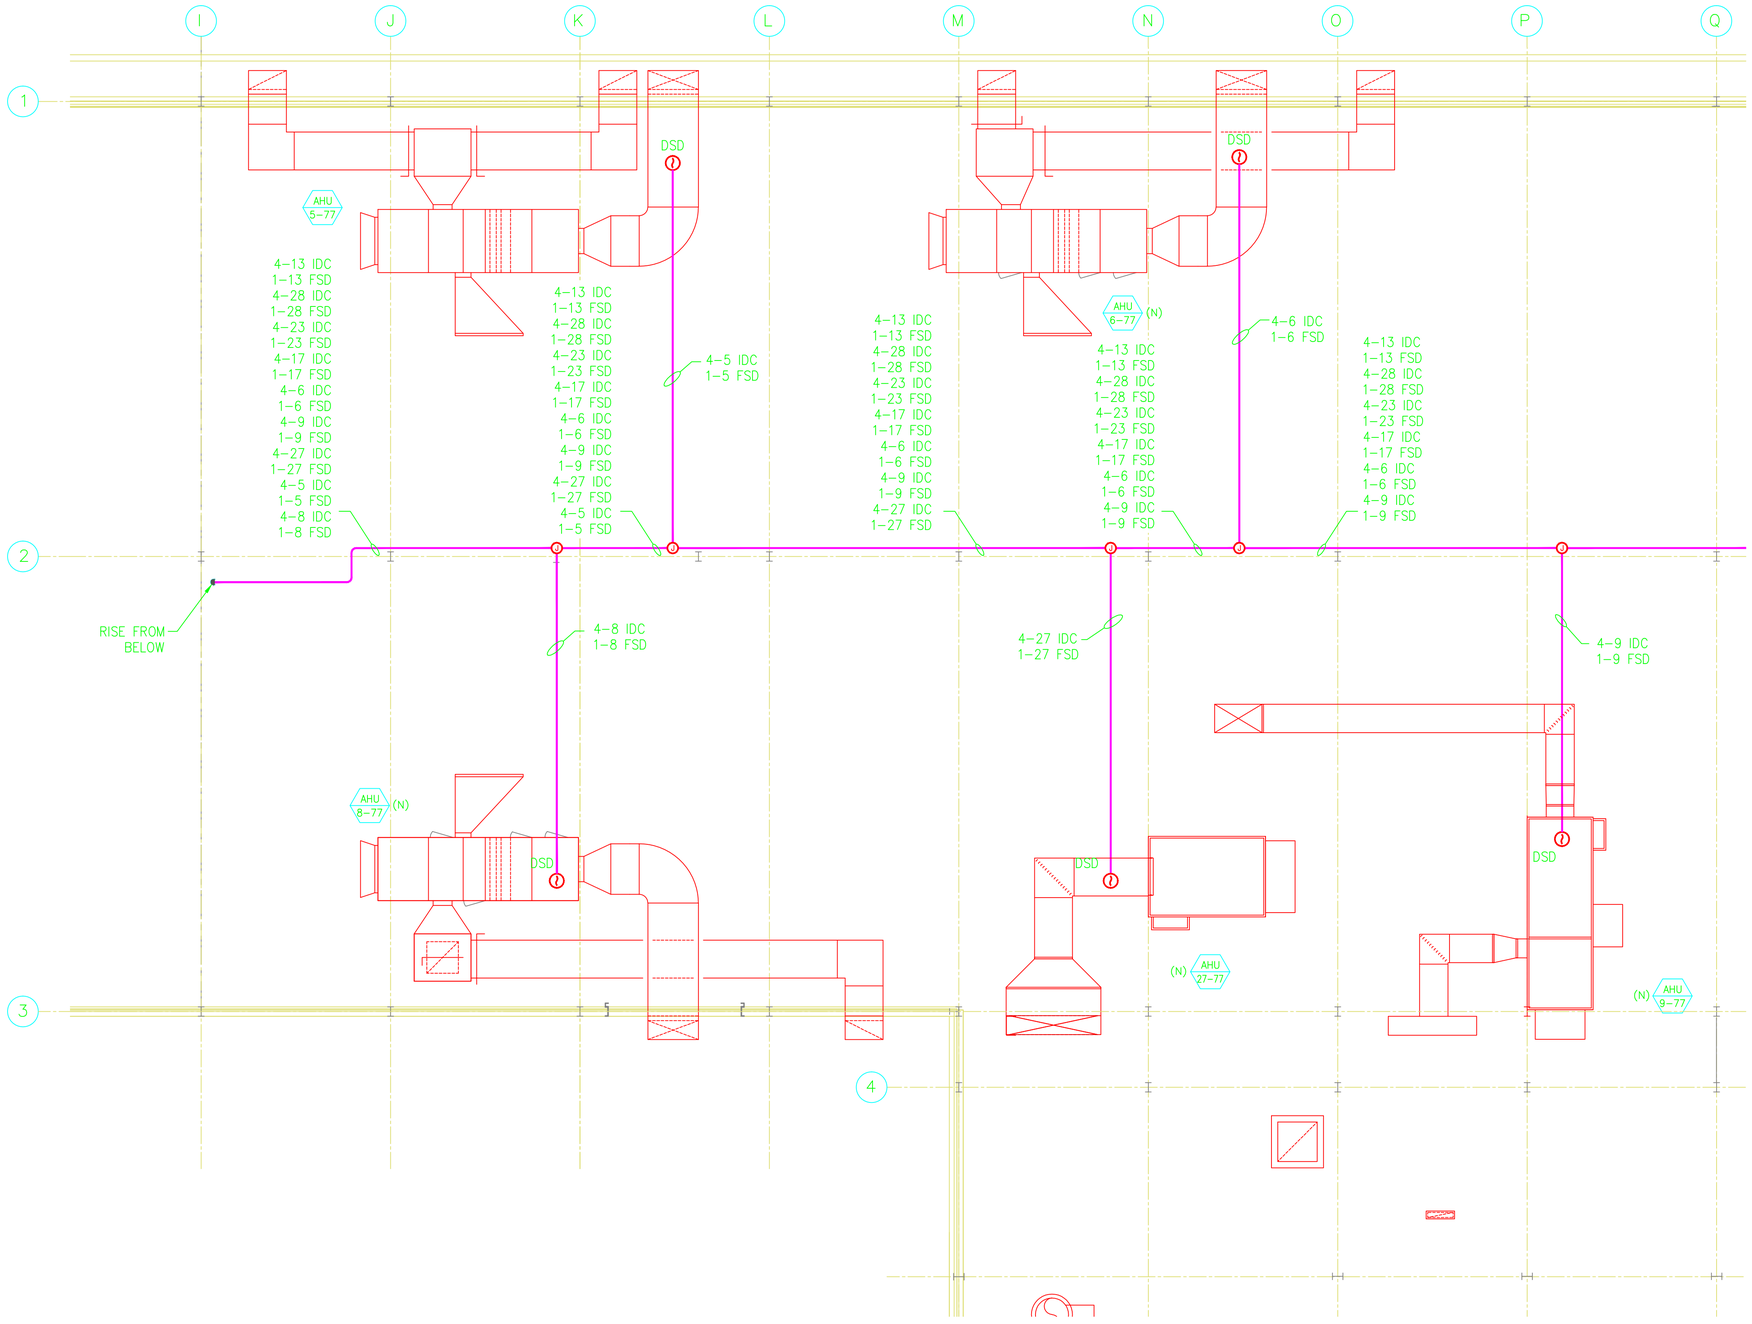

LEGEND

DSD — NEW DUCT SMOKE DETECTOR.

J — FIRE ALARM JUNCTION BOX.

FAP — EXISTING FIRE ALARM CONTROL UNIT.

NEW ¾ INCH FIRE ALARM CONDUIT.

CONDUCTOR IDENTIFICATION LEGEND

4-13 IDC 4#16 INITIATION DEVICE CIRCUIT CONDUCTORS FOR HVAC FAN UNIT #13.
1-13 FSD 1#16 RELAY CIRCUIT CONDUCTOR FOR HVAC FAN UNIT #13 FAN SHUT DOWN.

BUILDING KEY PLAN

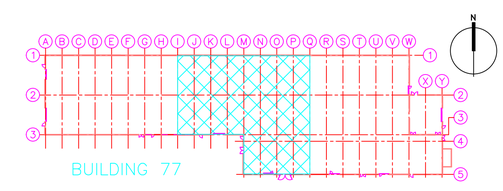

1 FIRE ALARM PARTIAL ROOF PLAN

FA0.5 SCALE: 1/8"=1'-0"

0 8 FT 16 FT 24 FT
SCALE: 1/8"=1'-0" UNO

N W E S

HYT Corporation
Fire Protection Engineers and Consultants
3498 Clayton Road - Suite 101 Concord, California
94519 Phone: (925) 681-2731 FAX: (925) 681-2733

CONSULTING FIRM

PROFESSIONAL SEAL (IF REVISION, APPLIES ONLY TO REVISED WORK)

RECORD DRAWING

06/21/10

ISSUE (PROGRESS, ESTIMATE, BID, CONSTRUCTION, CONFORMED, REVISION, RECORD)

REVISION NUMBER	DRAWN BY	CHECKED BY	APPR'D BY	DATE	REMARKS

BUILDING 77
REHAB. BLDG. STRUCTURE/SYSTEMS PH.2
FIRE ALARM - ROOF PLAN COL. I-Q/1-3

UNIVERSITY OF CALIFORNIA
LAWRENCE BERKELEY NATIONAL LABORATORY
FACILITIES DIVISION

DRAWN BY	DWH
CHECKED BY	BBT
APPROVED BY	–
CAD FILE PATH	TBD
SCALE	AS NOTED
DATE	3/16/09
DRAWING NO.	4N77E215
SHEET	FA0.5
PROJECT NO.	TBD