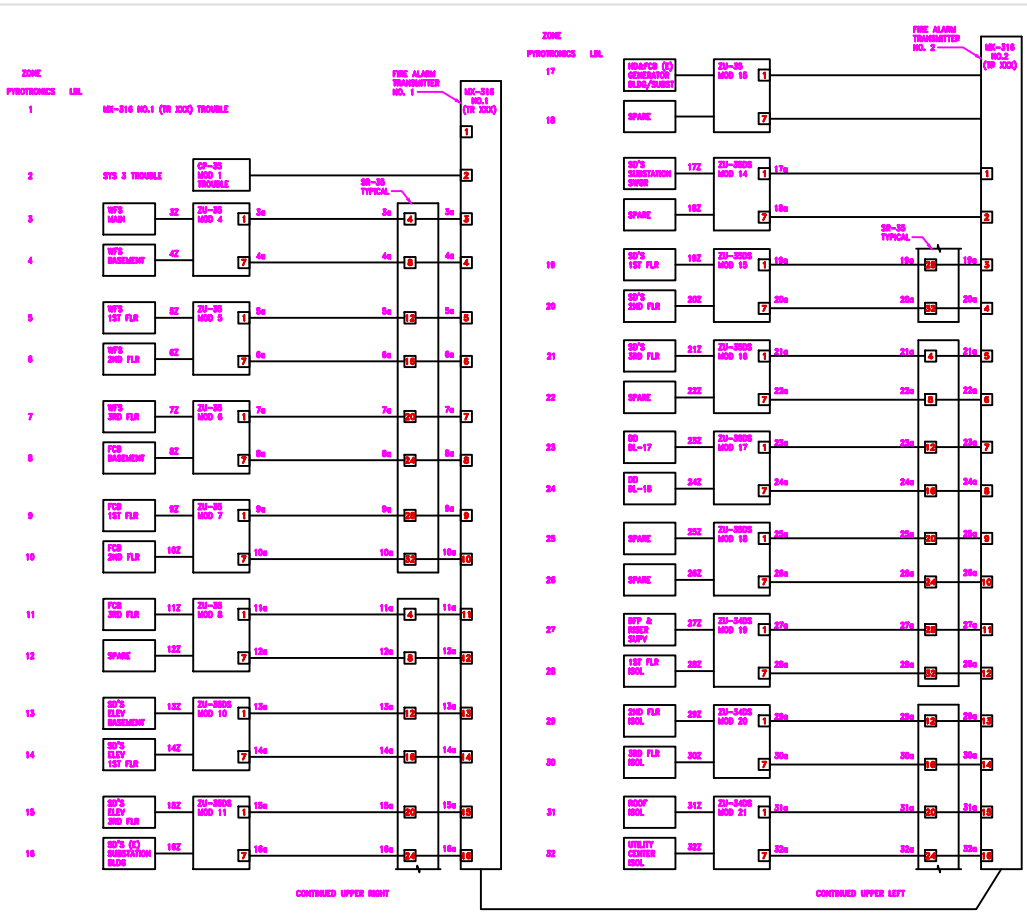

NOTES:
1. SEE SHEET E5.07 FOR AUDIBLE AND VISUAL CIRCUITS.
2. NUMBERS INDICATED ARE THAT OF CERBERUS PYROTRONICS.

FA LOGIC DIAGRAM
NOT TO SCALE

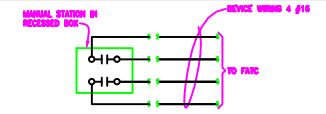

MANUAL STATION DIAGRAM

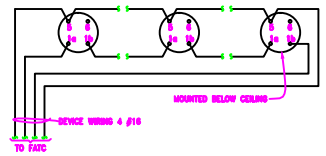

SMOKE DETECTOR DIAGRAM

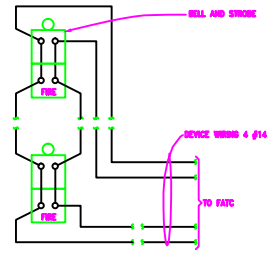

BELL AND STROBE DIAGRAM

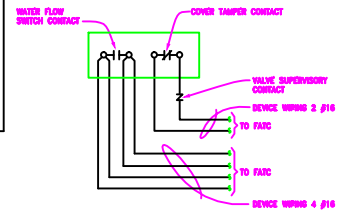

WATERFLOW SWITCH DIAGRAM

MBH Architecture

SEALS

CONSULTANTS

CIVIL ENGINEER
ARUP, INC.
55 New Montgomery Street, Suite 600
San Francisco, California 94105
Tel (415) 777-7500 Fax (415) 777-7501

MECHANICAL ENGINEER
AYRES ENGINEERS
1333 Fourth Street
San Francisco, CA 94158
Tel (415) 474-7500 Fax (415) 474-7501

STRUCTURAL ENGINEER
FERRELL / ALDERSON
150 Fine Street
San Francisco, CA 94105
Tel (415) 397-0500 Fax (415) 397-0501

LANDSCAPE ARCHITECT
CARTER TERRE LANDRUM + ASLANIAN
2000 Powell Street, Suite 1000
San Francisco, CA 94133
Tel (415) 956-6400 Fax (415) 956-6404

GENERAL NOTES

12 JUNE 98	RECORD DRAWINGS
22 AUG 97	CONFORM SET ADDENDA INCL.

REVISIONS

PROT. JOB NO:	7016	PROJECT NO:	95025
DATE:	22 MAY 97	CAD FILE NO:	
DRAWN BY:	JG	DRWG. NO:	E5.06

PROJECT

LBL HGL

HUMAN GENOME LABORATORY
PHASE 2 BUILDING 84

UNIVERSITY OF CALIFORNIA
LAWRENCE BERKELEY LABORATORY
BERKELEY, CALIFORNIA

SHEET TITLE

DIAGRAMS –
FIRE DETECTION
AND ALARM SYSTEM

SOLIDWORK
4N84E044

SHEET NO.
E 5.06