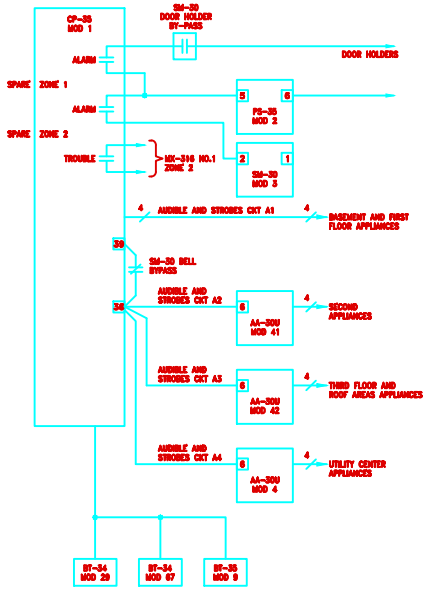

AUDIBLE AND VISUAL CIRCUITS

NOT TO SCALE

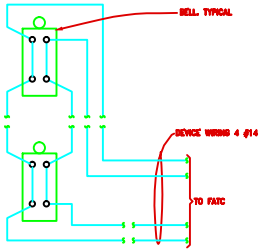

BELL DIAGRAM

NOT TO SCALE

MBH Architecture

SEALS

CONSULTANTS

CIVIL ENGINEER

MECHANICAL ENGINEER

STRUCTURAL ENGINEER

LANDSCAPE ARCHITECT

GENERAL NOTES

12 JUNE 98	RECORD DRAWINGS
22 AUG 97	CONFORM SET ADDENDA INCL.

REVISIONS

PROJECT

LBL HGL

HUMAN GENOME LABORATORY
PHASE 2 BUILDING 64

UNIVERSITY OF CALIFORNIA
LAWRENCE BERKELEY LABORATORY
BERKELEY, CALIFORNIA

SHEET TITLE

DIAGRAMS –
FIRE DETECTION &
ALARM SYSTEM

SOLIDWORK

4N64E045

SHEET NO.

E 5.07