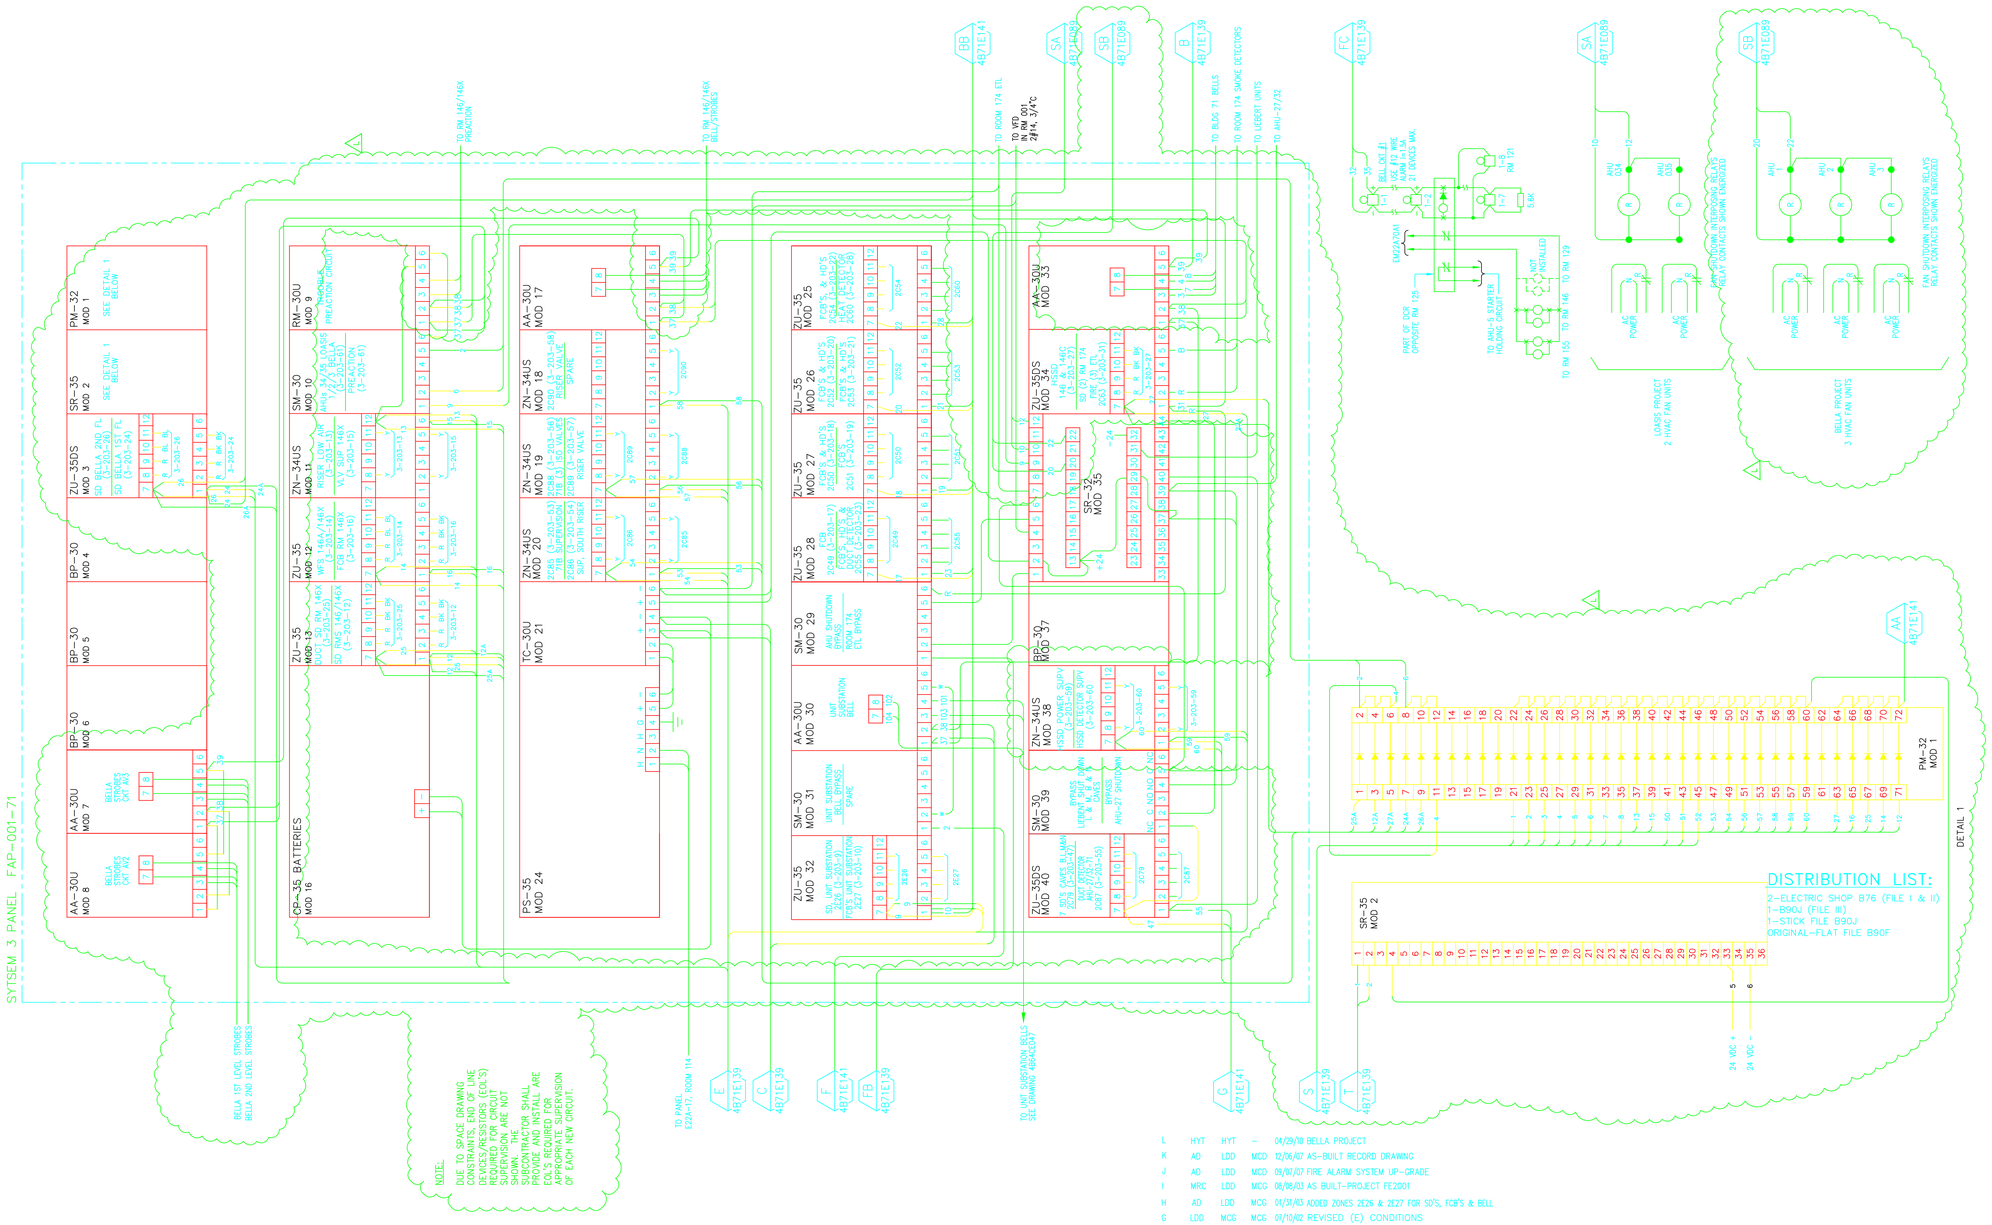

REV.	DATE	DESCRIPTION	DRAWN	CHECKED
1	10/21/10	RESPONSE TO LBNL FM COMMENTS	HYT	HYT

KEY PLAN

L	HYT	HYT	–	04/29/10 BELLA PROJECT
K	AD	LDD	MCD	12/06/07 AS-BUILT RECORD DRAWING
J	AD	LDD	MCD	09/07/07 FIRE ALARM SYSTEM UP-GRADE
I	MRC	LDD	MCG	08/08/03 AS BUILT-PROJECT FE2001
H	AD	LDD	MCG	01/31/03 ADDED ZONES 2E26 & 2E27 FOR SD'S, FCB'S & BELL
G	LDD	MCG	MCG	07/10/02 REVISED (E) CONDITIONS
F	VDA	MCG	MCG	11/13/01 REVISED PER JO#WA9614 (AC SHUTDOWN)

CLIENT

BERKELEY LAB

PROJECT
BUILDING 71
BERKELEY LAB LASER ACCELERATOR (BELLA)
CONVENTIONAL FACILITIES

M+W GROUP
M+W U.S., Inc.
49 Stevenson Street, Suite 700
San Francisco, CA 94105
Telephone: (415) 442-1881
Fax: (415) 442-1882

HYT Corporation
Fire Protection Engineers and Consultants
3498 Clayton Road - Suite 101
Concord, California 94519
Phone: (925) 681-2731

SHEET TITLE

FIRE ALARM SYSTEM 3 PANEL FAP-001-71 INTERCONNECTION DIAGRAM

	DATE	NAME	PROJ. NO.	PROJ. PHASE
DRAWN	04/21/2010	DWH	12092	FINAL
CHECKED	04/21/2010	BBT		
ISSUED/APPROVE	05/26/2010		SHEET NO.	REV.
SCALE/SHT. SIZE	AS NOTED		FA-003	
CTB FILE	LBNL_B&W_Full			

FOR CONSTRUCTION

© M+W Zander. All rights reserved. Reproduction in whole or in part is prohibited without the written consent of the copyright owner.