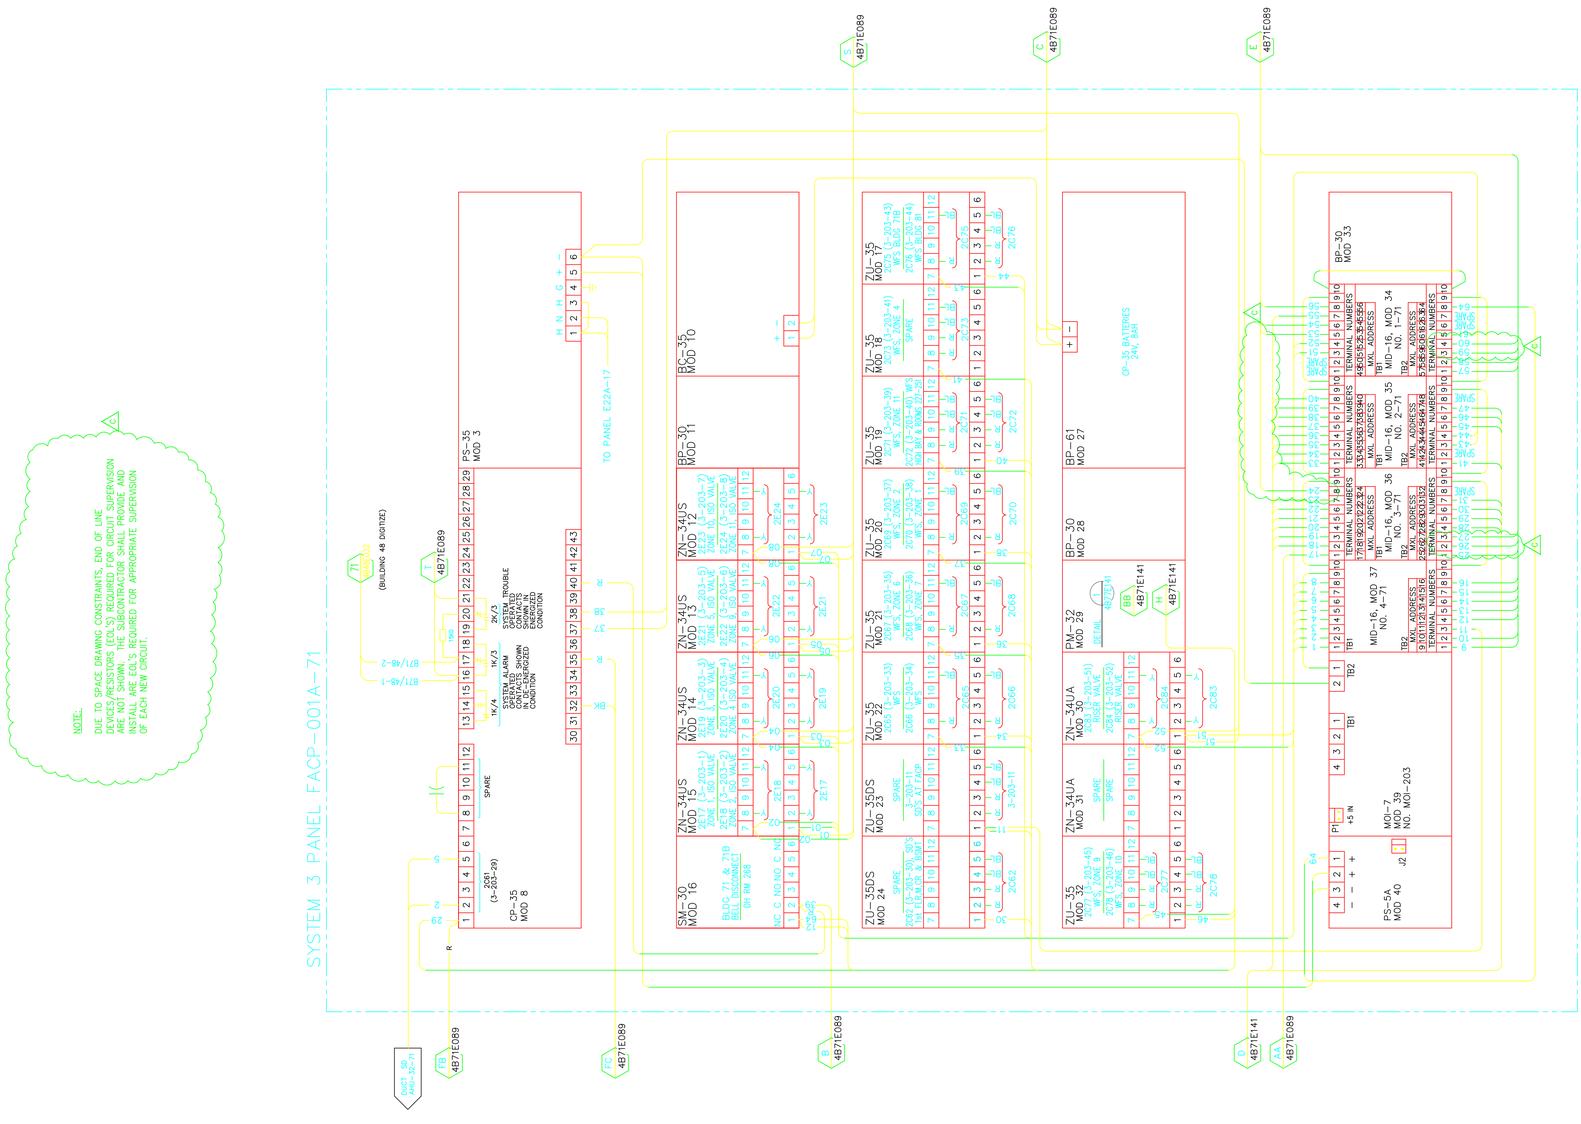

REV.	DATE	DESCRIPTION	DRAWN	CHECKED
1	10/21/10	RESPONSE TO LBNL FM COMMENTS	HYT	HYT

KEY PLAN

C	HYT HYT	–	04/29/10 BELLA PROJECT
B	AD LDD	MCD	12/10/07 AS-BUILT RECORD DRAWING
A	AD LDD	MCD	4/19/06 REVISED FOR MXL COPPER LOOP

CLIENT

BERKELEY LAB

PROJECT
BUILDING 71
BERKELEY LAB LASER ACCELERATOR (BELLA)
CONVENTIONAL FACILITIES

M+W GROUP
M+W U.S., Inc.
49 Stevenson Street, Suite 700
San Francisco, CA 94105
Telephone: (415) 442-1881
Fax: (415) 442-1882

HYT Corporation
Fire Protection Engineers
and Consultants
3498 Clayton Road - Suite 101
Concord, California 94519
Phone: (925) 681-2731

SHEET TITLE
FIRE ALARM SYSTEM 3 CONNECTION DIAGRAM

	DATE	NAME	PROJ. NO.	PROJ. PHASE
DRAWN	04/21/2010	DWH	12092	FINAL
CHECKED	04/21/2010	BBT		
ISSUED/APPROVE	05/26/2010		SHEET NO.	REV.
SCALE/SHT. SIZE	AS NOTED		FA-004	
CTB FILE	LBNL_B&W_Full			

FOR CONSTRUCTION

© M+W Group. All rights reserved. Reproduction in whole or in part is prohibited without the written consent of the copyright owner.