FIRE ALARM CONTROL UNIT ARRANGEMENT – DETAIL 1

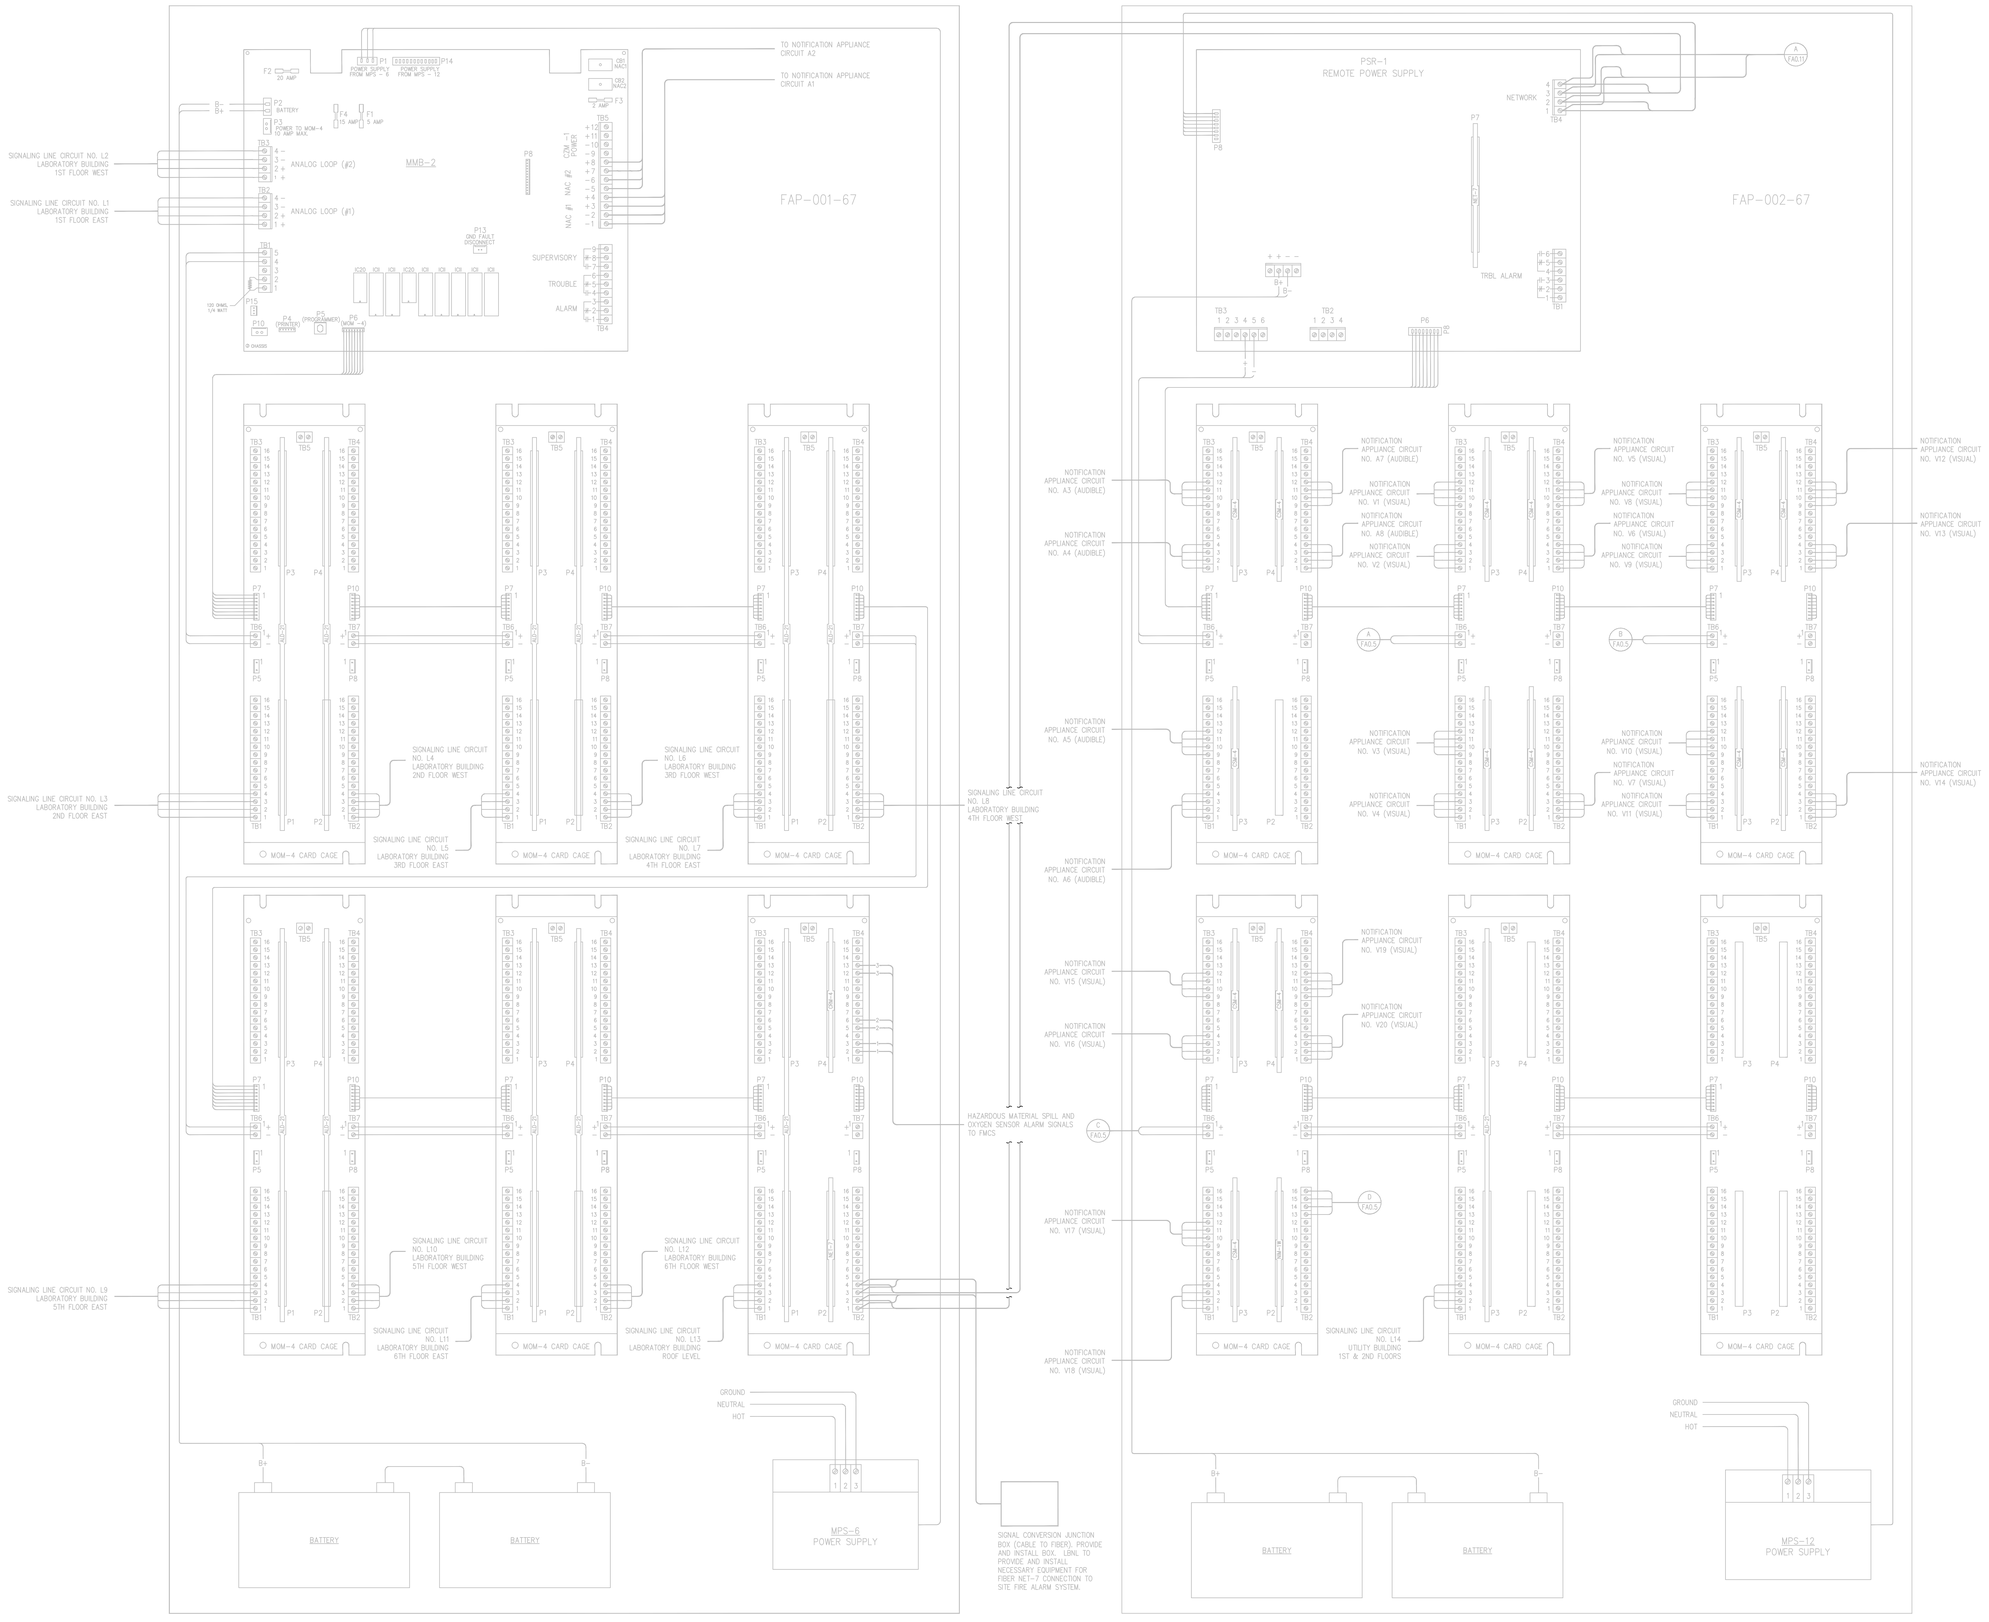

Lawrence Berkeley National Laboratory

Molecular Foundry
Building 67

Issued for	Rev	Date
RECORD DRAWINGS		18 JAN 2007

Seals and Signatures

RECORD DRAWINGS

SPECIAL NOTE:
THE INFORMATION SHOWN IN THIS DRAWING WAS DEVELOPED USING THE RECORD DRAWINGS PROVIDED BY SIEMENS BUILDING TECHNOLOGIES, INC. FOLLOWING THE COMPLETION OF THIS PROJECT (IDENTIFIED AS JOB NUMBER 107739, SHEETS 1 THROUGH 24). SPECIFICALLY, SEE SHEET 6 OF 24 FOR INFORMATION.

LBNL Project Title: MOLECULAR FOUNDRY
LBNL Building Number: 67

Key Plan

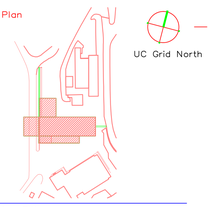

Drawing Title
FIRE ALARM SYSTEM CONTROL UNIT ARRANGEMENT

Scale: MF1212

SG Project Number: FA0.4

LBNL Project Number: 4 OF 20

Drawing Number: 5N67E024

LBNL Drawing Number: IFB 841

Plot Sheet Filename: A0$S\JOBNUMBER\FILENAME
XREF Filename List: A0$S\JOBNUMBER\FILENAME
Plot Page Setup: PAGE15 B
Plot Layout: PSPAGE: SHEET @ 1:1
Plot Date:

LBNL Drawing Status:
LBNL Issue Status:
LBNL Revision:
LBNL Date: